

INDEX OF SHEETS

- 1, TITLE SHEET
- 2, INDEX OF SHEETS

RECORD PLANS & MATERIAL SUPPLIERS

# STATE OF VERMONT AGENCY OF TRANSPORTATION




CONTRACTOR- EARTH CONSTRUCTION INC. GROTON, VT CONTRACT DATED-11-13-84 CONSTRUCTION BEGAN-11-13-84  
 CONSTRUCTION SUSPENDED-1-14-86 CONSTRUCTION RESUMED-4-17-86 CONSTRUCTION COMPLETED- ACCEPTED-  
 RESIDENT ENGINEER- EDWARD M. GIPSON JR. INSPECTORS- EUGENE L. PEABODY, FRED C. DONALD JR., THOMAS I. ROBERTS & ALBERT M. STONE  
 RECORD PLANS- FRED C. DONALD JR. SAND BORROW- CARRARA PIT NORTH CLARENDON, VT. GRANULAR BORROW- CARRARA PIT, ELNICKI  
 PIT & ROWAN PIT CLARENDON, VT. GRANULAR BACKFILL FOR STRUCTURES- CARRARA, ROWAN PITS CLARENDON, VT & MEADE PIT  
 WEST RUTLAND, VT. SUBBASE OF CRUSHED GRAVEL (FINE GRADED)- JOSEPH P. CARRARA & SONS INC. NORTH CLARENDON, VT.  
 PLANT MIX BASE COURSE & BIT. CONC. FAYT-PIKE INDUSTRIES, INC. NORTH CLARENDON, VT. CONC. CLASS "A" & "B"- JOSEPH P. CARRARA & SONS INC. NORTH CLARENDON, VT.  
 REIN. STEEL- PIONEER VALLEY STEEL CO. INC. GREENFIELD, MA. STEEL PILING- L.B. FOSTER CO.,  
 DORAVILLE, GA. STRUCTURAL STEEL & BEARING DEVICE ASSEMBLY- BANCROFT & MARTIN INC. SOUTH PORTLAND, ME.  
 JOINT SEALER POLYURETHANE & PREFORMED JOINT FILLER CORK- SONNEBORN BLDG. PRODUCTS MASPETH, N.Y. WATER REPELLENT- N.E. PAINT MFG. CO., INC. CENTRAL FALLS, RI.  
 GRANITE BRIDGE CURB- BARRE T TO GRANITE CO. MILFORD, N.H. BRIDGE RAILING- O.W. HUBBELL & SONS INC. NEW HARTFORD, N.Y.  
 SHEAR CONNECTORS- PAIGE WELDING CO. WENTWORTH, N.H. METAL PIPES & ELBOWS- LANE METAL PRODUCTS, BALLSTON SPA, NY.  
 REIN. CONC. PIPES- S.T. GRISWOLD CO., INC. WILLISTON, VT. CAST IRON GRATE W/ FRAME TYPE "A" & "B"- QUALITY WATER PRODUCTS - LAPERLE FOUNDRY TOWN FARM RD. SOUTH BARRE, MA  
 6' CHAIN LINK & WOVEN WIRE FENCE, BOUNDARY MARKERS- MASKELL FENCE & GUARD RAIL CO., INC. SWANTON, VT.

## PROPOSED IMPROVEMENT TOWNS OF WEST RUTLAND - RUTLAND COUNTY OF RUTLAND U.S. RTE. 4

LENGTH OF ROADWAY 9,980.06 FEET = 1.890 MILES  
 LENGTH OF BRIDGES 571.54 FEET = 0.108 MILES  
 LENGTH OF PROJECT 10,551.60 FEET = 1.998 MILES

CONSTRUCTION CONSISTS OF A NEW FOUR LANE, DIVIDED, LIMITED ACCESS HIGHWAY WITH DRAINAGE, STRUCTURES AND BRIDGES.

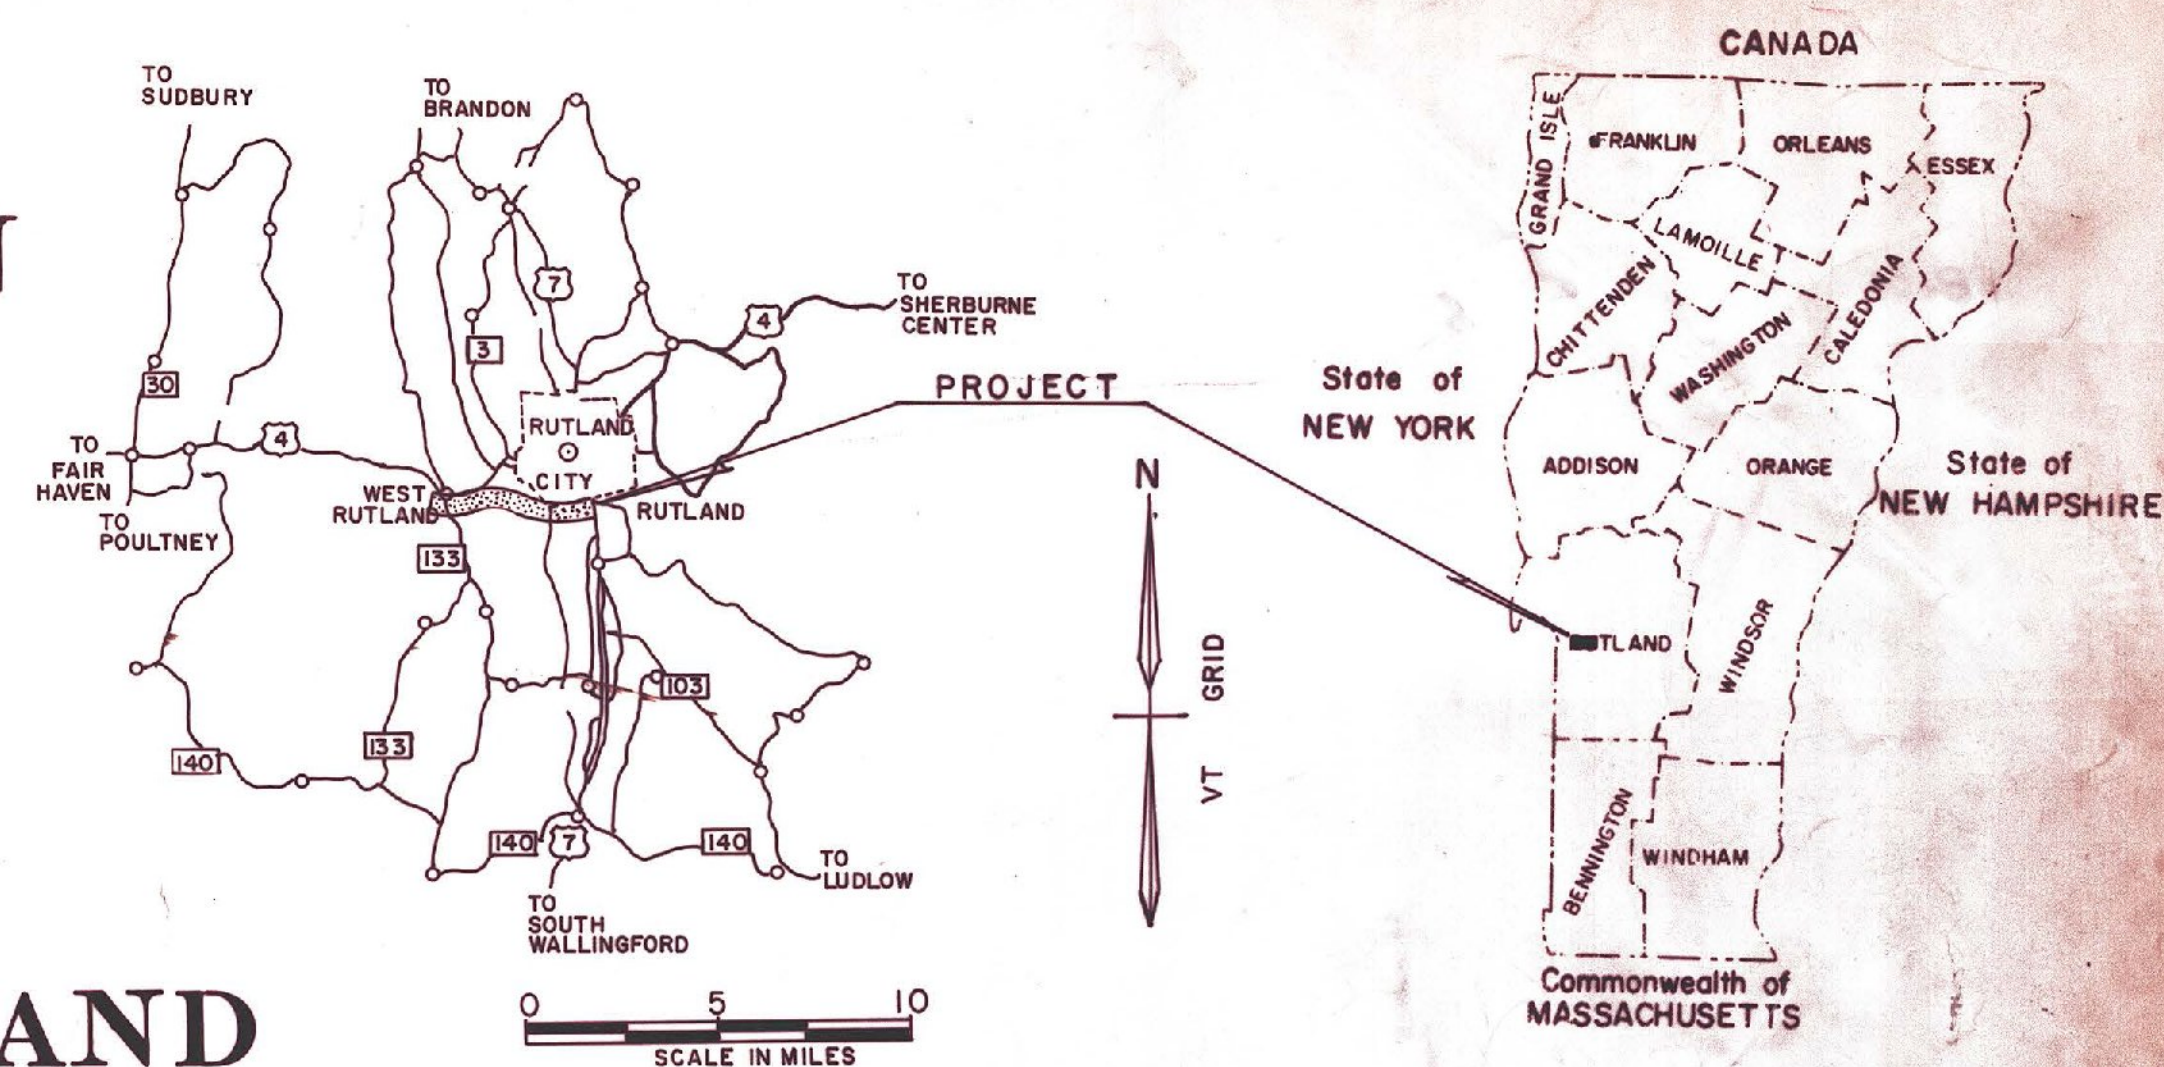

AS BUILT PLANS  
 I hereby certify that all the construction shown on this set of drawings has been accomplished as indicated herein.  
 Project Engineer  
 Date 4-21-92


TRAFFIC DATA - US 4	
1984	ADT = 6390
2004	ADT = 8140
2004	DHV = 860
D	= 55%
T	= 7%
V	= 60 MPH

TRAFFIC DATA - TH 5	
1984	ADT = 60
2004	ADT = 70
2004	DHV = 10
D	= 50%
T	= 0%

TRAFFIC DATA - TH 22	
1984	ADT = 20
2004	ADT = 30
2004	DHV = 5
D	= 50%
T	= 0%



- COUNTY LINE
- TOWN LINE
- LIMITS OF ACCESS
- POINT OF ACCESS
- FENCE LINE
- STONE WALL
- TRAVELED WAY
- GUARD RAIL
- RAILROAD
- SURVEY LINE
- CULVERT
- POWER POLE
- TELEPHONE POLE
- TREES
- CONTROL OF ACCESS
- PROPERTY LINE
- R.O.W TAKING LINE
- SLOPE RIGHTS
- TOE OF CUT
- TOE OF SLOPE

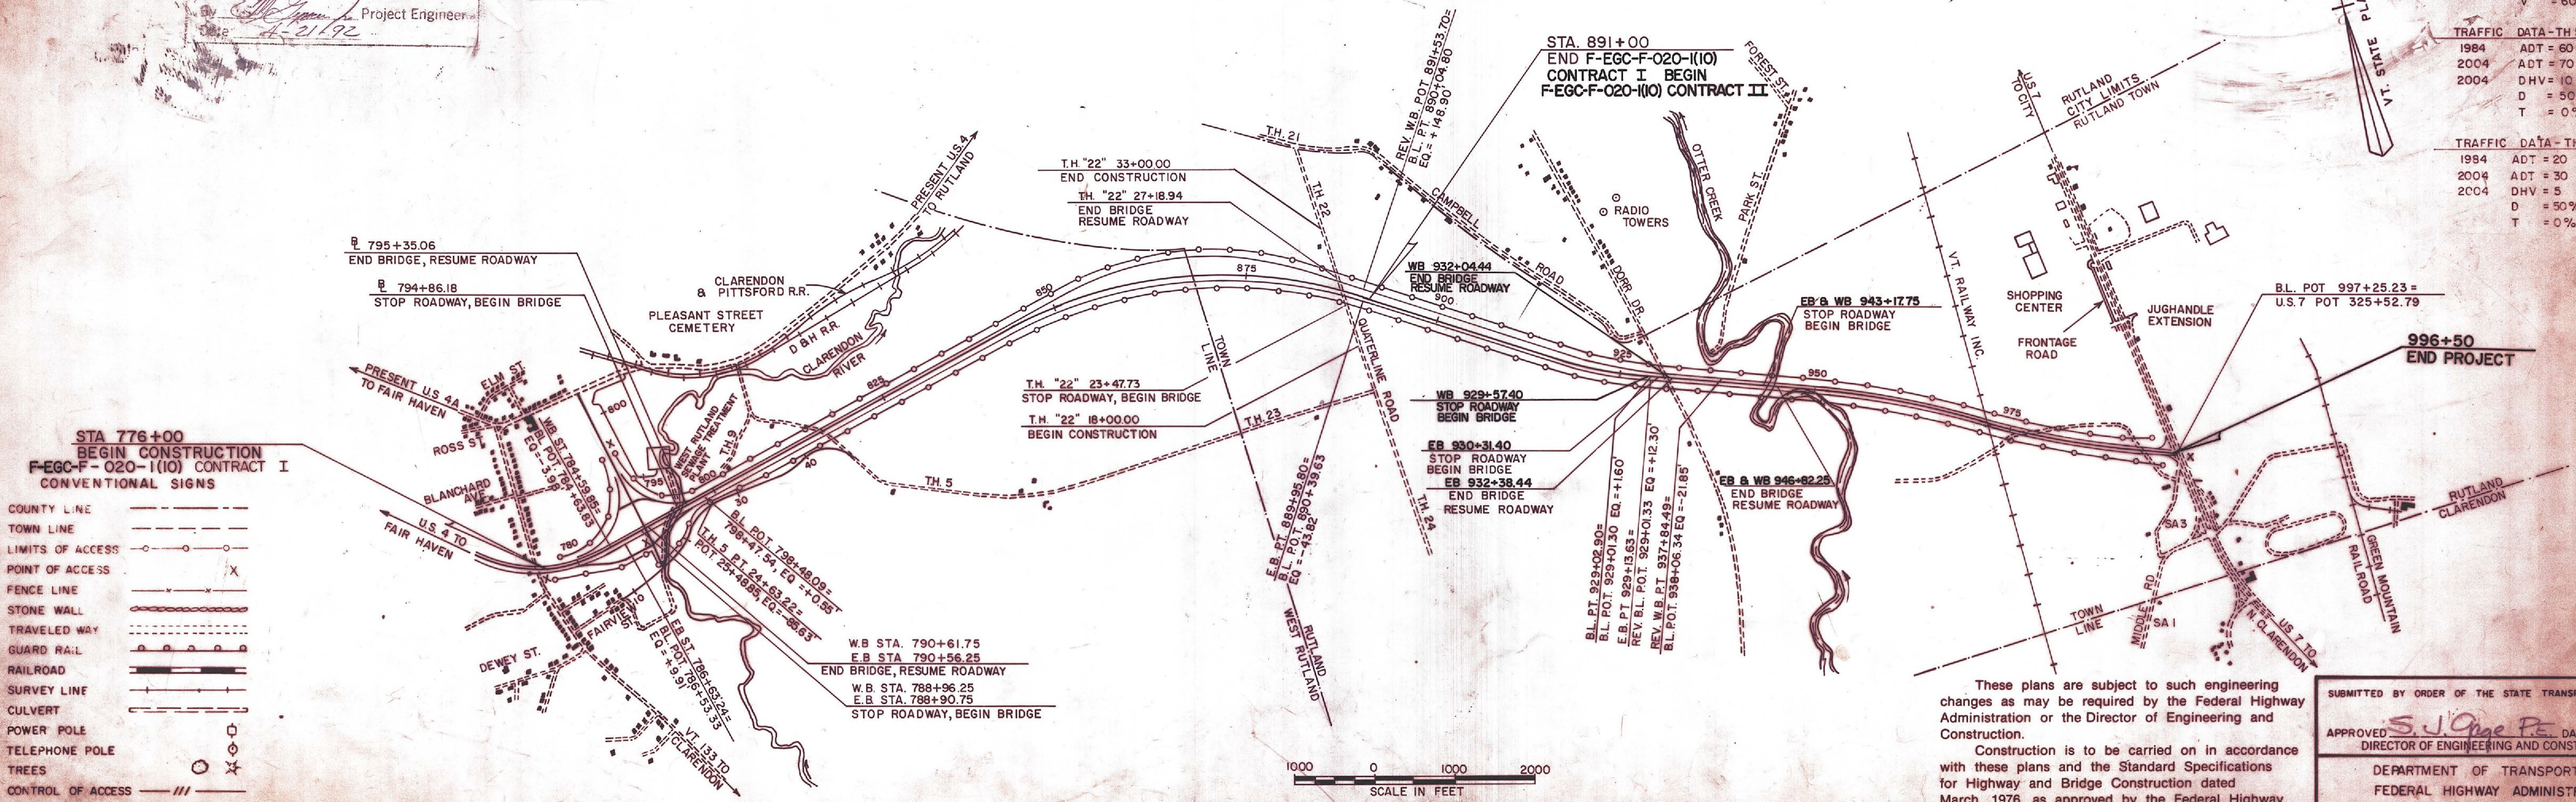DATUM

VERTICAL	NGVD 1929
HORIZONTAL	NAD 1927

These plans are subject to such engineering changes as may be required by the Federal Highway Administration or the Director of Engineering and Construction.  
 Construction is to be carried on in accordance with these plans and the Standard Specifications for Highway and Bridge Construction dated March, 1976, as approved by the Federal Highway Administration on October 27, 1976 for use on this project, including all subsequent revisions and such revised specifications and special provisions as are incorporated in these plans.

SUBMITTED BY ORDER OF THE STATE TRANSPORTATION BOARD

APPROVED: *S.J. O'Neil P.E.* DATE 4-13-92  
 DIRECTOR OF ENGINEERING AND CONSTRUCTION

DEPARTMENT OF TRANSPORTATION  
 FEDERAL HIGHWAY ADMINISTRATION

APPROVED: \_\_\_\_\_ DATE \_\_\_\_\_  
 DIVISION ADMINISTRATOR

PROJECT: F EGC-F 020-1(10) C/2  
 SHEET 1 OF 459 SHEETS