

# US 4 TYPICAL SECTIONS

3" BITUMINOUS CONCRETE PAVEMENT ITEM 406.25 ( $\pm 1/4"$  TOTAL THICKNESS) 1 1/4" WEARING COURSE OVER 1 3/4" BINDING COURSE

5" PLANT MIXED BASE COURSE ITEM 303.25 ( $\pm 1/2"$  TOTAL THICKNESS) 2-2 1/2" COURSES

24" SUB-BASE OF DENSE GRADED CRUSHED STONE ITEM 301.35 ( $\pm 1"$  TOTAL THICKNESS)

SHOULDERS: 1 1/4" BITUMINOUS CONCRETE PAVEMENT ITEM 406.25







0"-12" GRANULAR BORROW ITEM 203.32 (IN FILL)

0"-24" SAND BORROW ITEM 203.31 (IN CUT)

TO BE PLACED AS NOTED ON THE PLANS OR AS DIRECTED BY THE ENGINEER

(PERMISSIBLE TOLERANCES IN PARENTHESIS APPLY TO THICKNESS ONLY)

THESE ITEMS NOT A PART OF STAGE ONE CONSTRUCTION

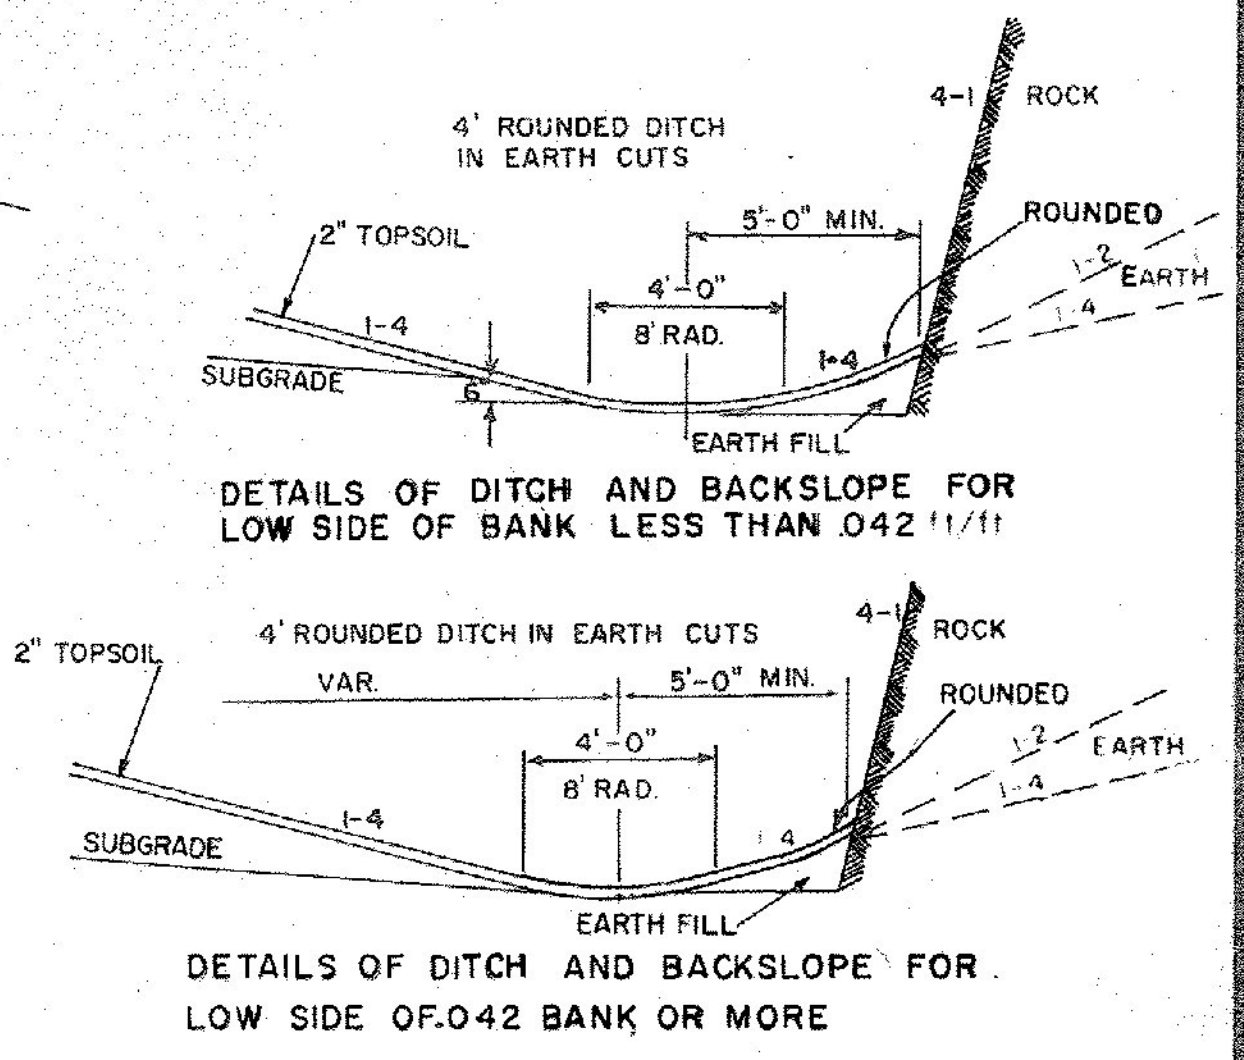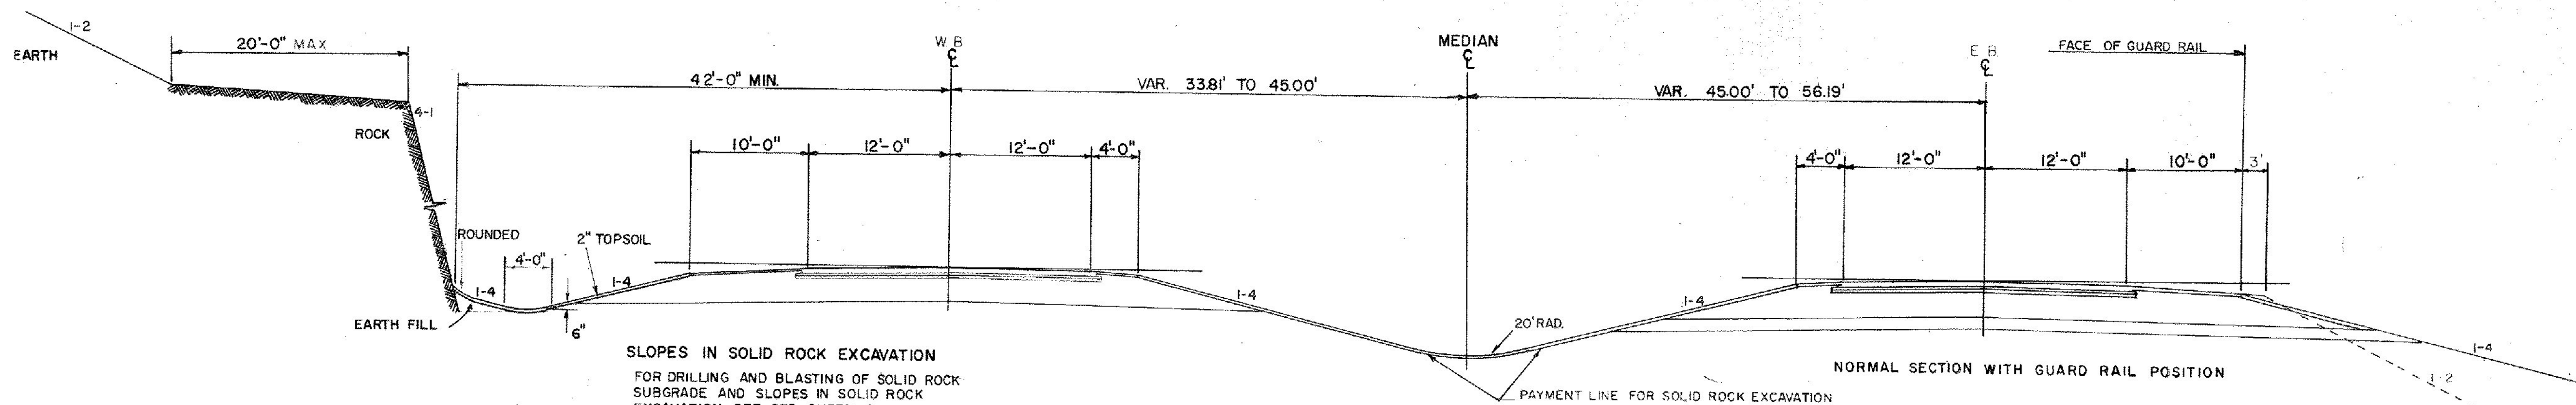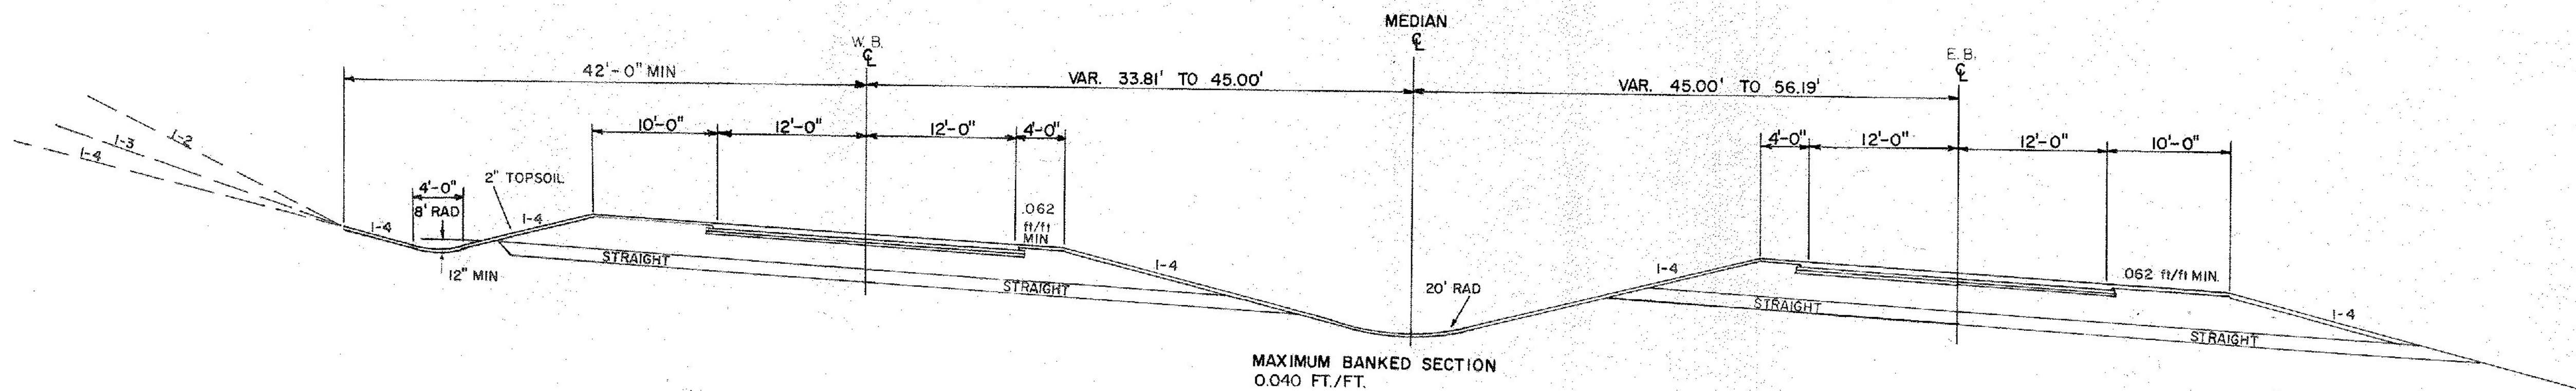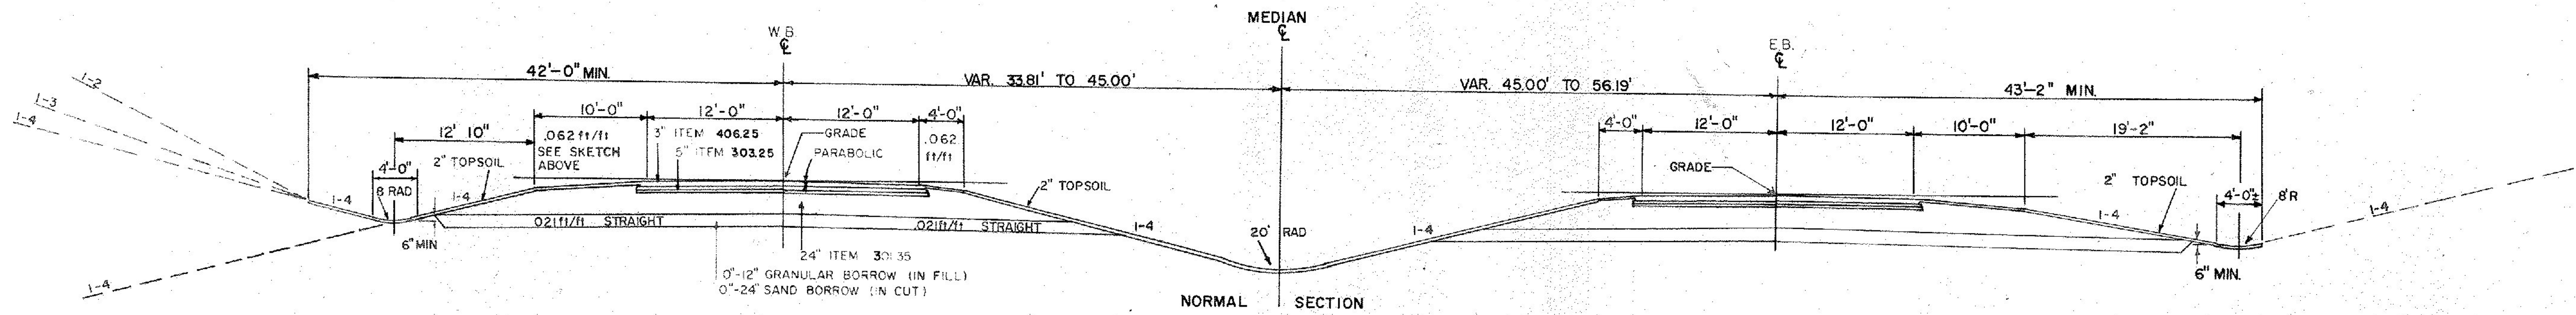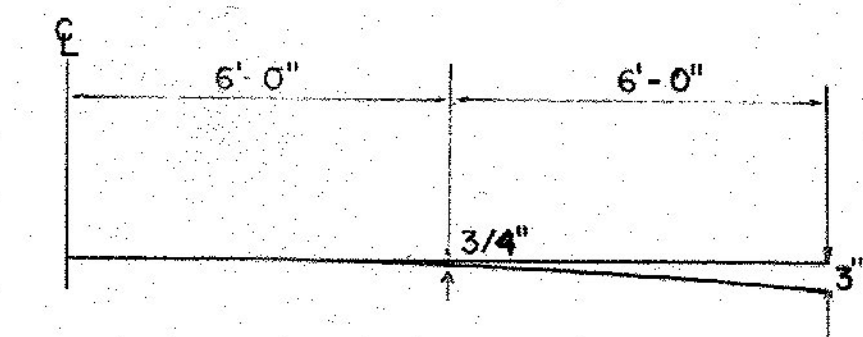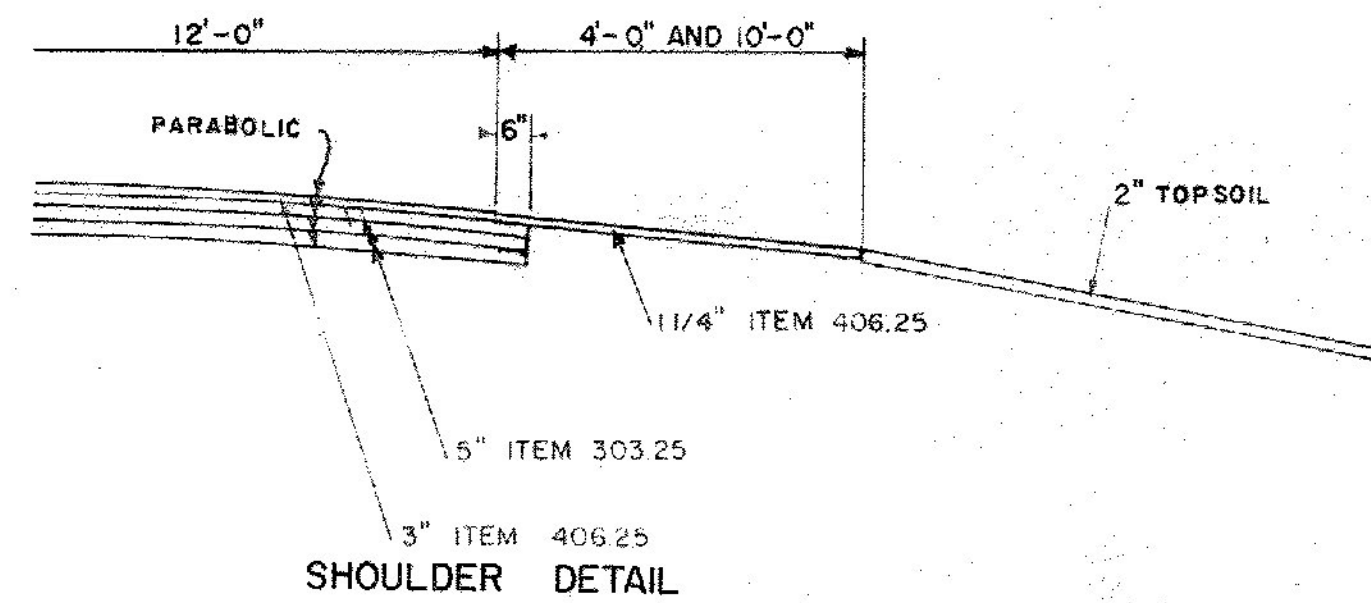

SLOPES IN SOLID ROCK EXCAVATION FOR DRILLING AND BLASTING OF SOLID ROCK SUBGRADE AND SLOPES IN SOLID ROCK EXCAVATION, SEE STD SHEET A-60

FOR GENERAL NOTES REFER TO SHEET NO 6