


DORR DRIVE TYPICAL SECTION

- 2" BITUMINOUS CONCRETE PAVEMENT ITEM 406.25 ($\pm 1/4"$ FOR TOTAL THICKNESS)
- 3" PLANT MIXED BASE COURSE ITEM 303.25 ($\pm 1/2"$)
- 18" SUBBASE OF CRUSHED GRAVEL (FINE GRADED) ITEM 301.26
- SHOULDERS 2" BITUMINOUS CONCRETE PAVEMENT ITEM 406.25 ($\pm 1/4"$ FOR TOTAL THICKNESS)
- 0'-24" SAND BORROW ITEM 203.31 (IN CUTS) (TO BE PLACED AS NOTED ON THE PLANS OR AS DIRECTED BY THE ENGINEER)

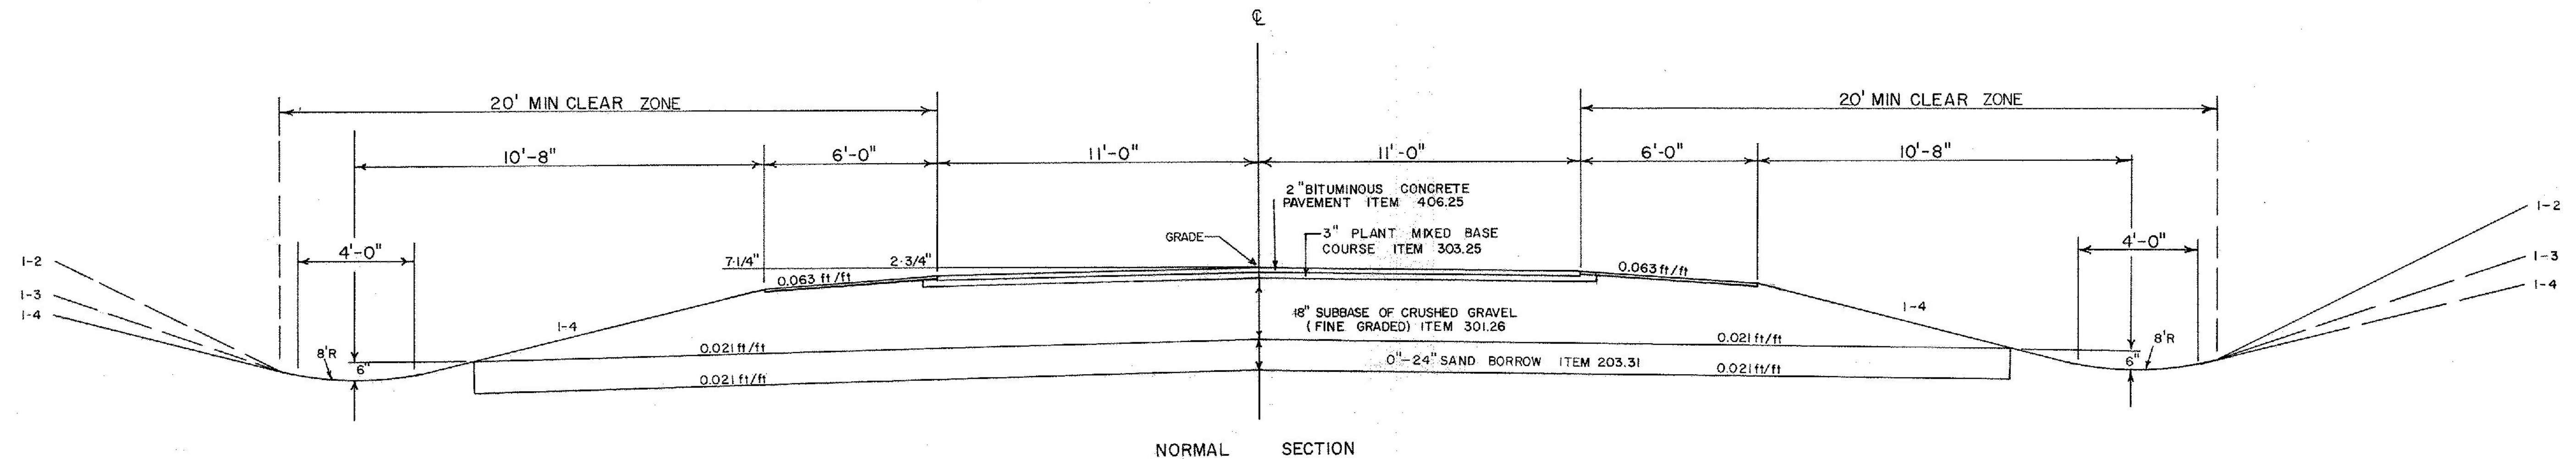

NOTE: DORR DRIVE CONSTRUCTION TO BE COMPLETED DURING STAGE I CONSTRUCTION.

SEEDING FORMULA, ITEM 651.10

RURAL AREAS				
% WT.	LBS./A.	NAME	PUR.%	GERM%
3.33	2	CROWN VETCH	97	75
50.00	30	CREeping RED FESCUE	98	85
8.33	5	TIMOTHY	99	85
16.67	10	PERENNIAL RYE GRASS (VAR. PENNFINE)	95	85
8.34	5	ALFALFA (VAR. SARANAC)	99	85
8.33	5	BIRDSFOOT TREFOIL (VAR. EMPIRE)	98	85
5.00	3	HIGHLAND BENT GRASS	92	85
100.00	60			

THE SEED MIXTURE SHALL NOT HAVE A WEED CONTENT EXCEEDING 0.40% BY WEIGHT AND SHALL BE FREE FROM ALL NOXIOUS WEED SEED.

HAY MULCH, ITEM 651.25, TO BE PLACED ON ALL EARTH SLOPES AT THE RATE OF TWO TONS PER ACRE.

FERTILIZER, ITEM 651.15, SHALL BE MIXED AS FOLLOWS:

NITROGEN 10%
PHOSPHORUS 20%
POTASH 10%

FERTILIZER SHALL BE DELIVERED IN BAGS OF NOT TO EXCEED 100LBS EACH AND IS TO BE APPLIED AT THE RATE OF 500 LBS. PER ACRE.

AGRICULTURAL LIMESTONE, ITEM 651.20, TO BE APPLIED TO ALL EARTH SLOPES AT THE RATE OF TWO TONS PER ACRE OR AS DIRECTED BY THE ENGINEER.

SEEDING FORMULA, ITEM 651.12

WETLAND AREAS


WINTER RYE, ITEM 651.12, SHALL BE APPLIED AT THE RATE OF 200LBS PER ACRE OR AS DIRECTED BY THE ENGINEER.

FERTILIZER, ITEM 651.15, SHALL BE APPLIED AT THE RATE OF 500LBS PER ACRE OR AS DIRECTED BY THE ENGINEER.


HAY MULCH, ITEM 651.25, SHALL BE APPLIED AT THE RATE OF TWO TONS PER ACRE OR AS DIRECTED BY THE ENGINEER.

WOOD MARKER POSTS, ITEM 619.15, TO BE PLACED AS DIRECTED BY THE ENGINEER FOR ROUNDING OF SLOPES, SEE STANDARD SHEET B-5.


TYPICAL FOR REPLACEMENT WETLANDS

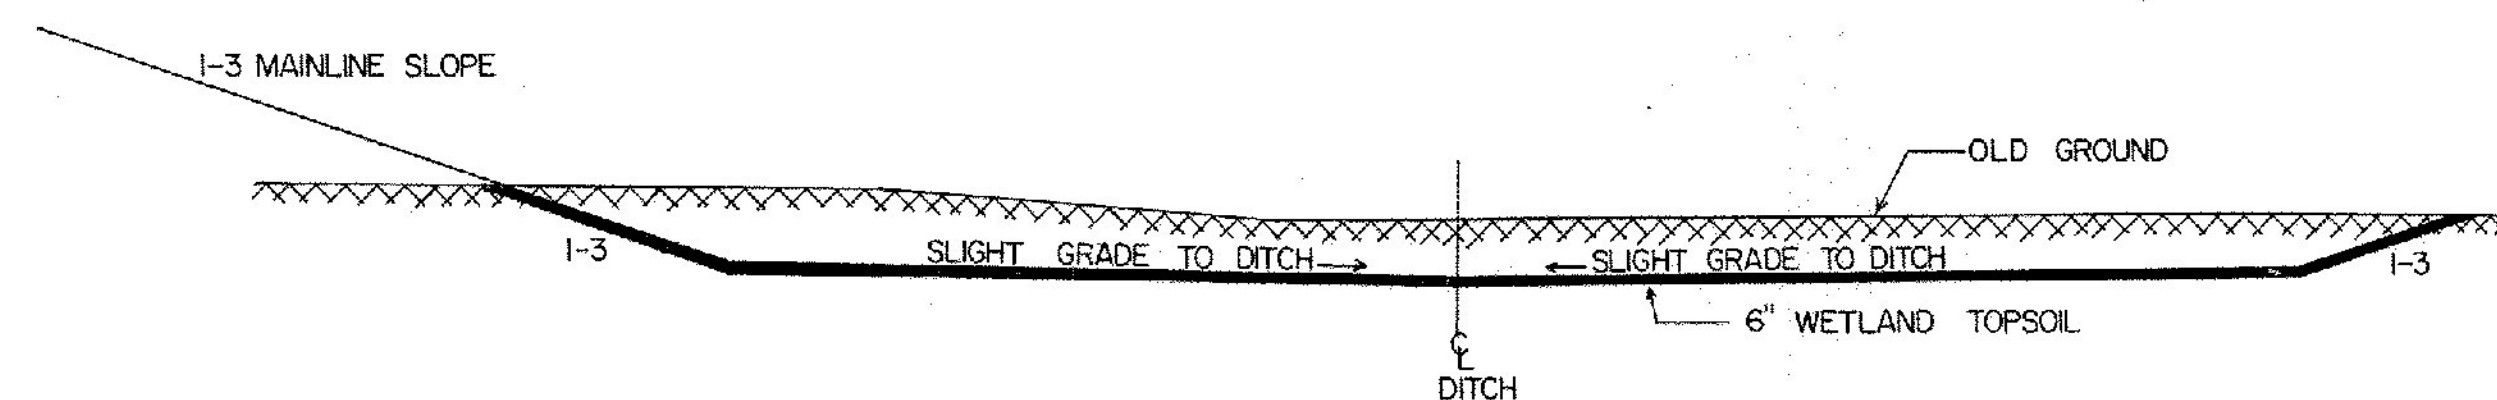

THIS TYPICAL APPLIES AT STATIONS
E.B. RT. 959+50-978+50
W.B. LT. 958+30-978+25

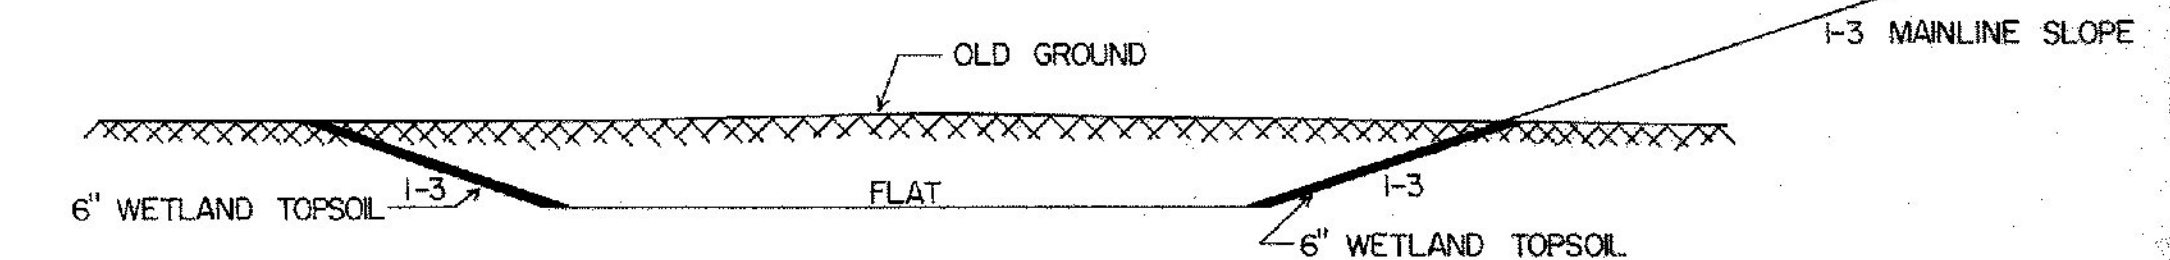

THIS TYPICAL APPLIES AT STATIONS
W.B. LT. 951+50-955+00

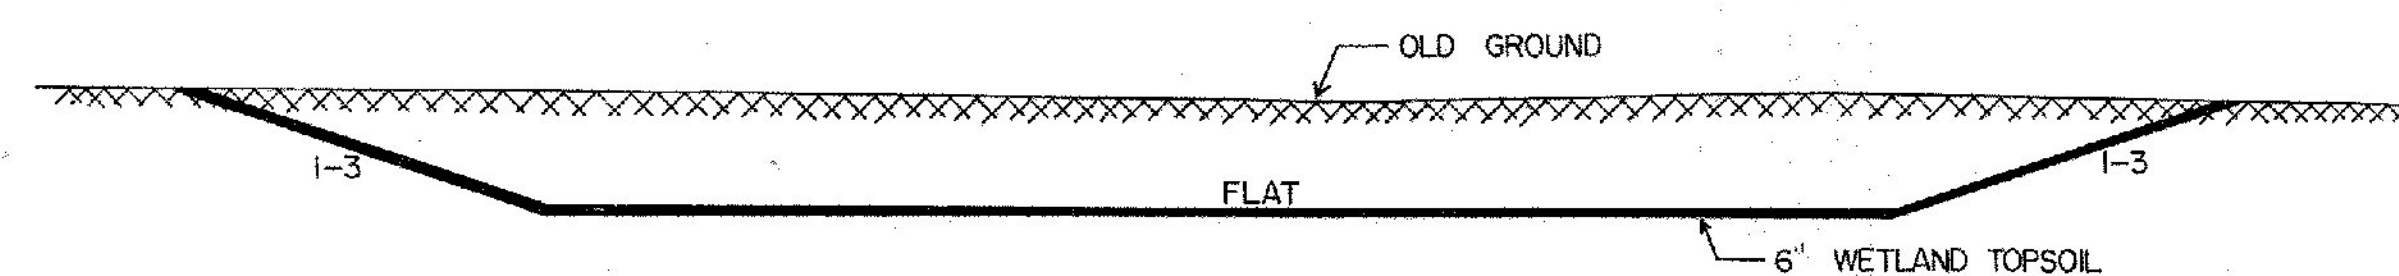

THIS TYPICAL APPLIES AT STATIONS
W.B. LT. 975+50-977+50

NOTE: WETLAND TOPSOIL CONSISTS OF MATERIAL FROM SWAMP CONTAINING PLANT ROOTS ETC. THE COST PLACING WETLAND TOPSOIL TO BE SUBSIDIARY TO THE COST OF COMMON EXCAVATION.
ALL WETLAND EXCAVATION TO BE PAID AS COMMON EXCAVATION, ITEM 203.15

SURVEYED BY: _____ DATE: _____
DRAWN BY: _____ DATE: _____
TRACED BY: _____ DATE: _____
WEST RUTLAND-RUTLAND
PROJ. F EGC FNO. 020 -1(10)
SHEET 6 OF 459