


MOD. OUTLET AT 972+27 LT.



- NOTES:
1. SHADED AREA TO BE STONE FILL TYPE I, ITEM 613.10.
 2. ELEVATION OF 60" PIPE OUTLET, 18" PIPE INLET AND BOTH WEIRS TO BE 530.00.
 3. ALL REINFORCING STEEL TO BE NO. 5 DEFORMED BARS, PAID AS REINFORCING STEEL ITEM 507.15.
 4. ALL CONCRETE SHALL CONFORM TO ITEM 501.25 CONCRETE CLASS B, AND SHALL BE PAID AS ITEM 501.25.

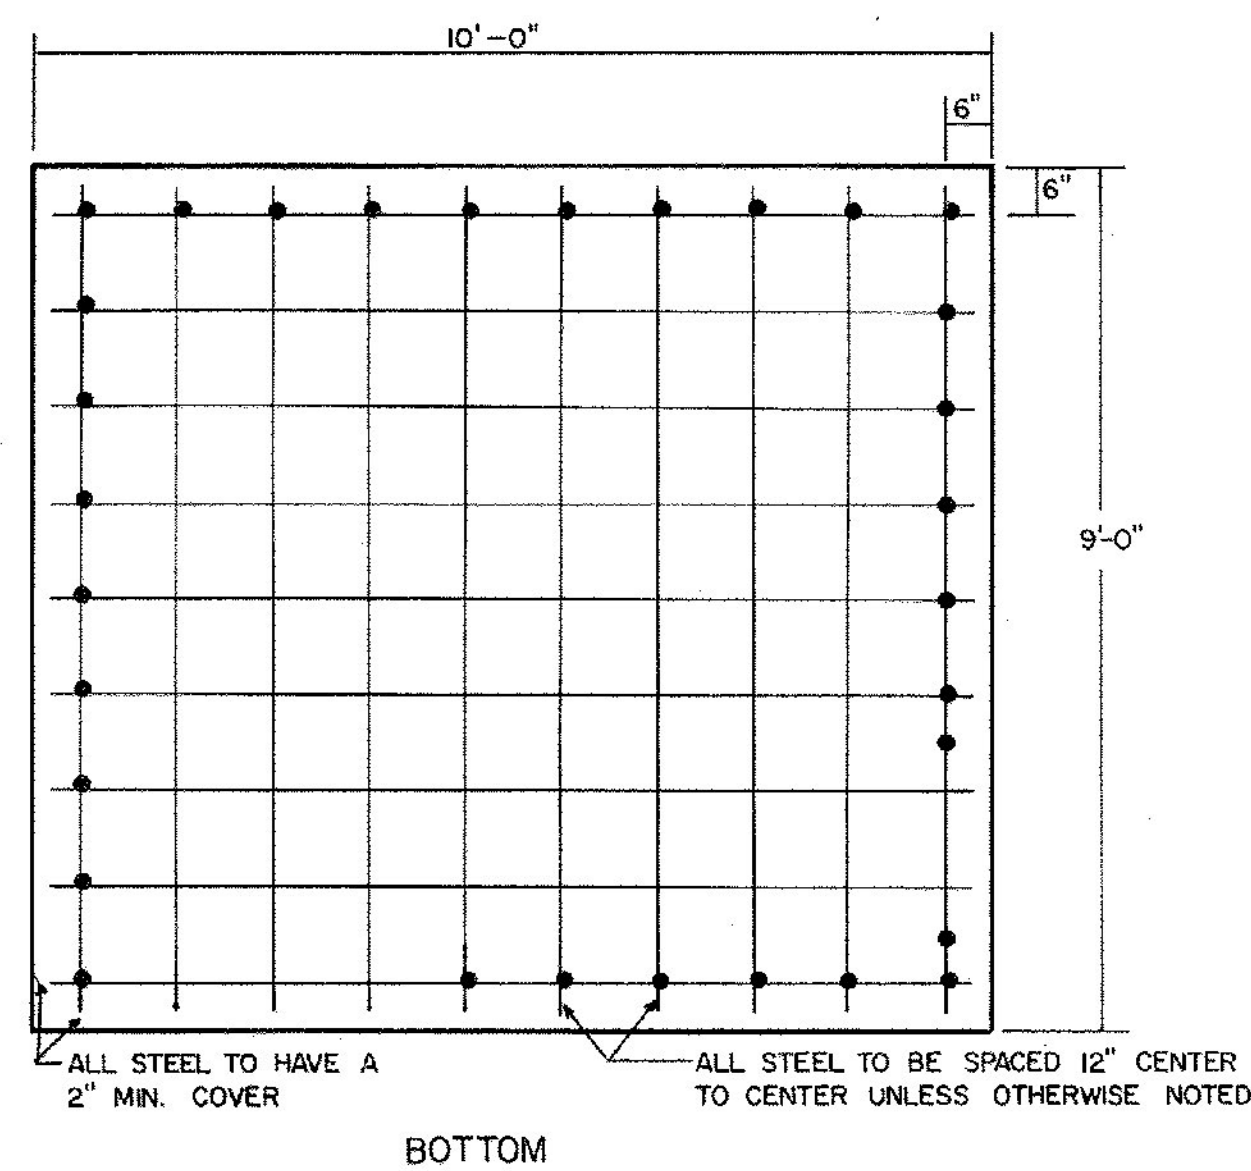