
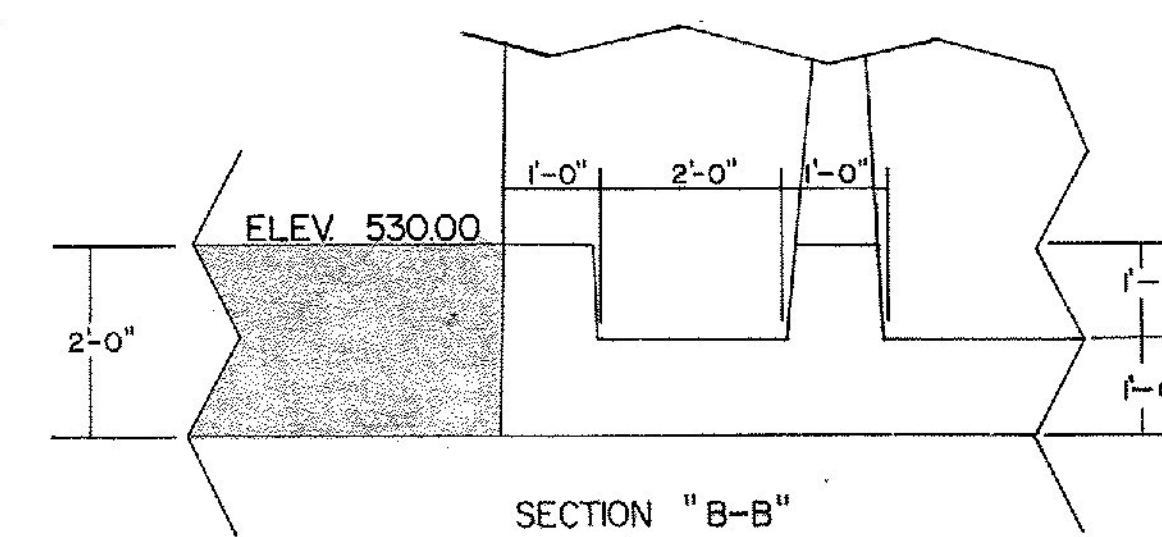
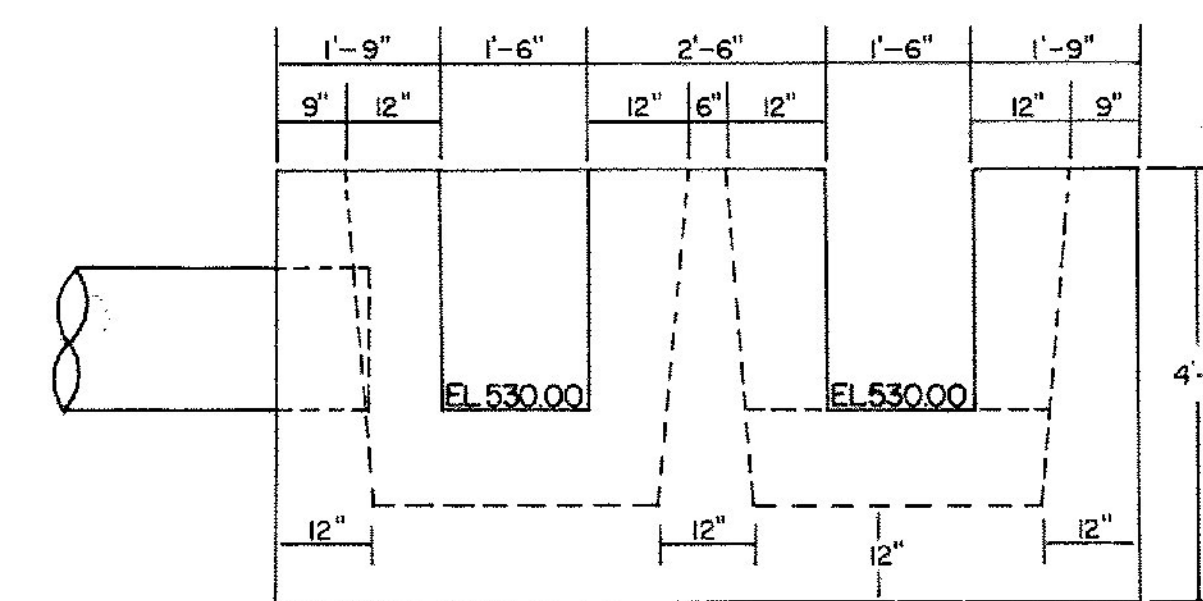
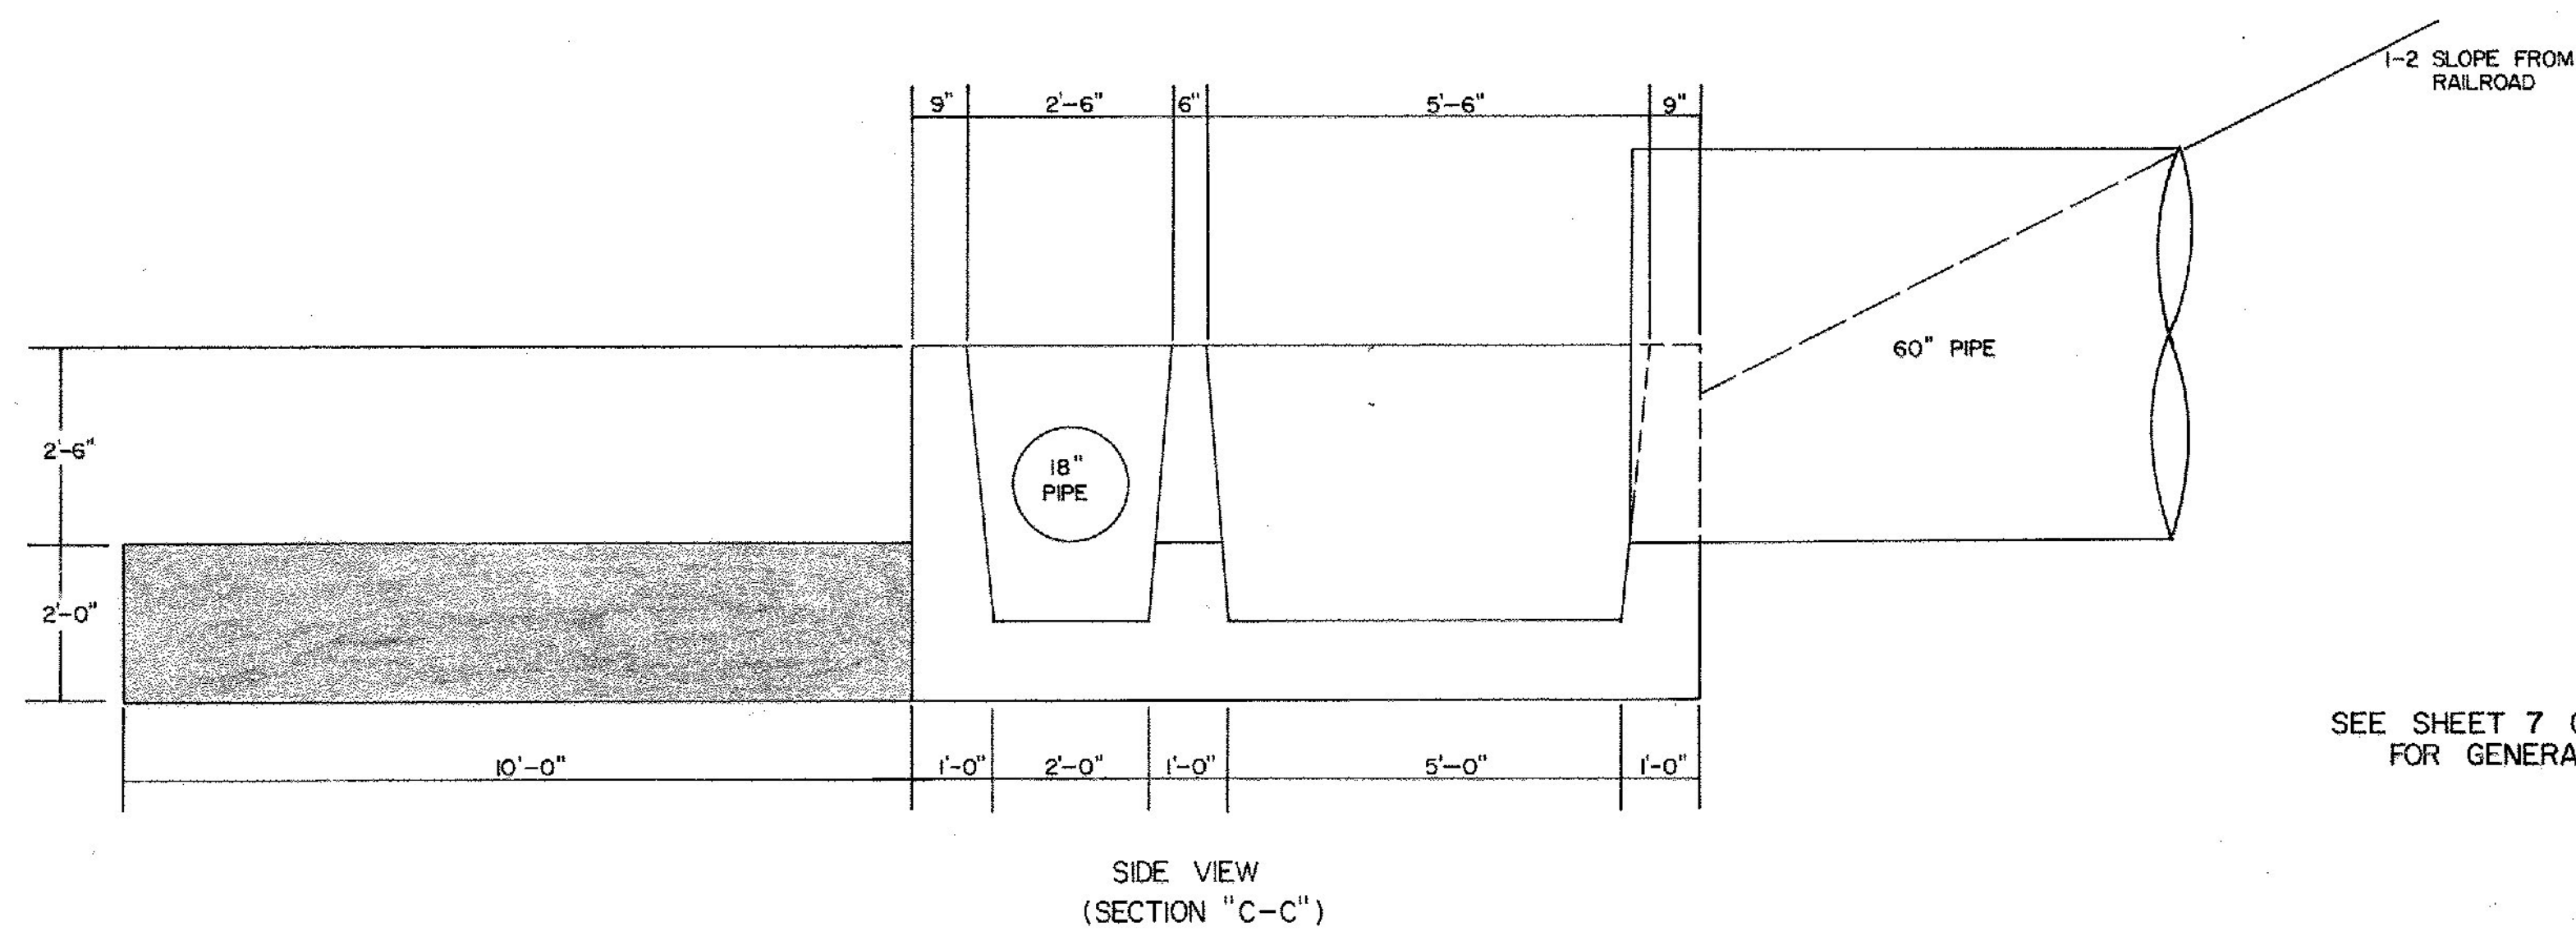
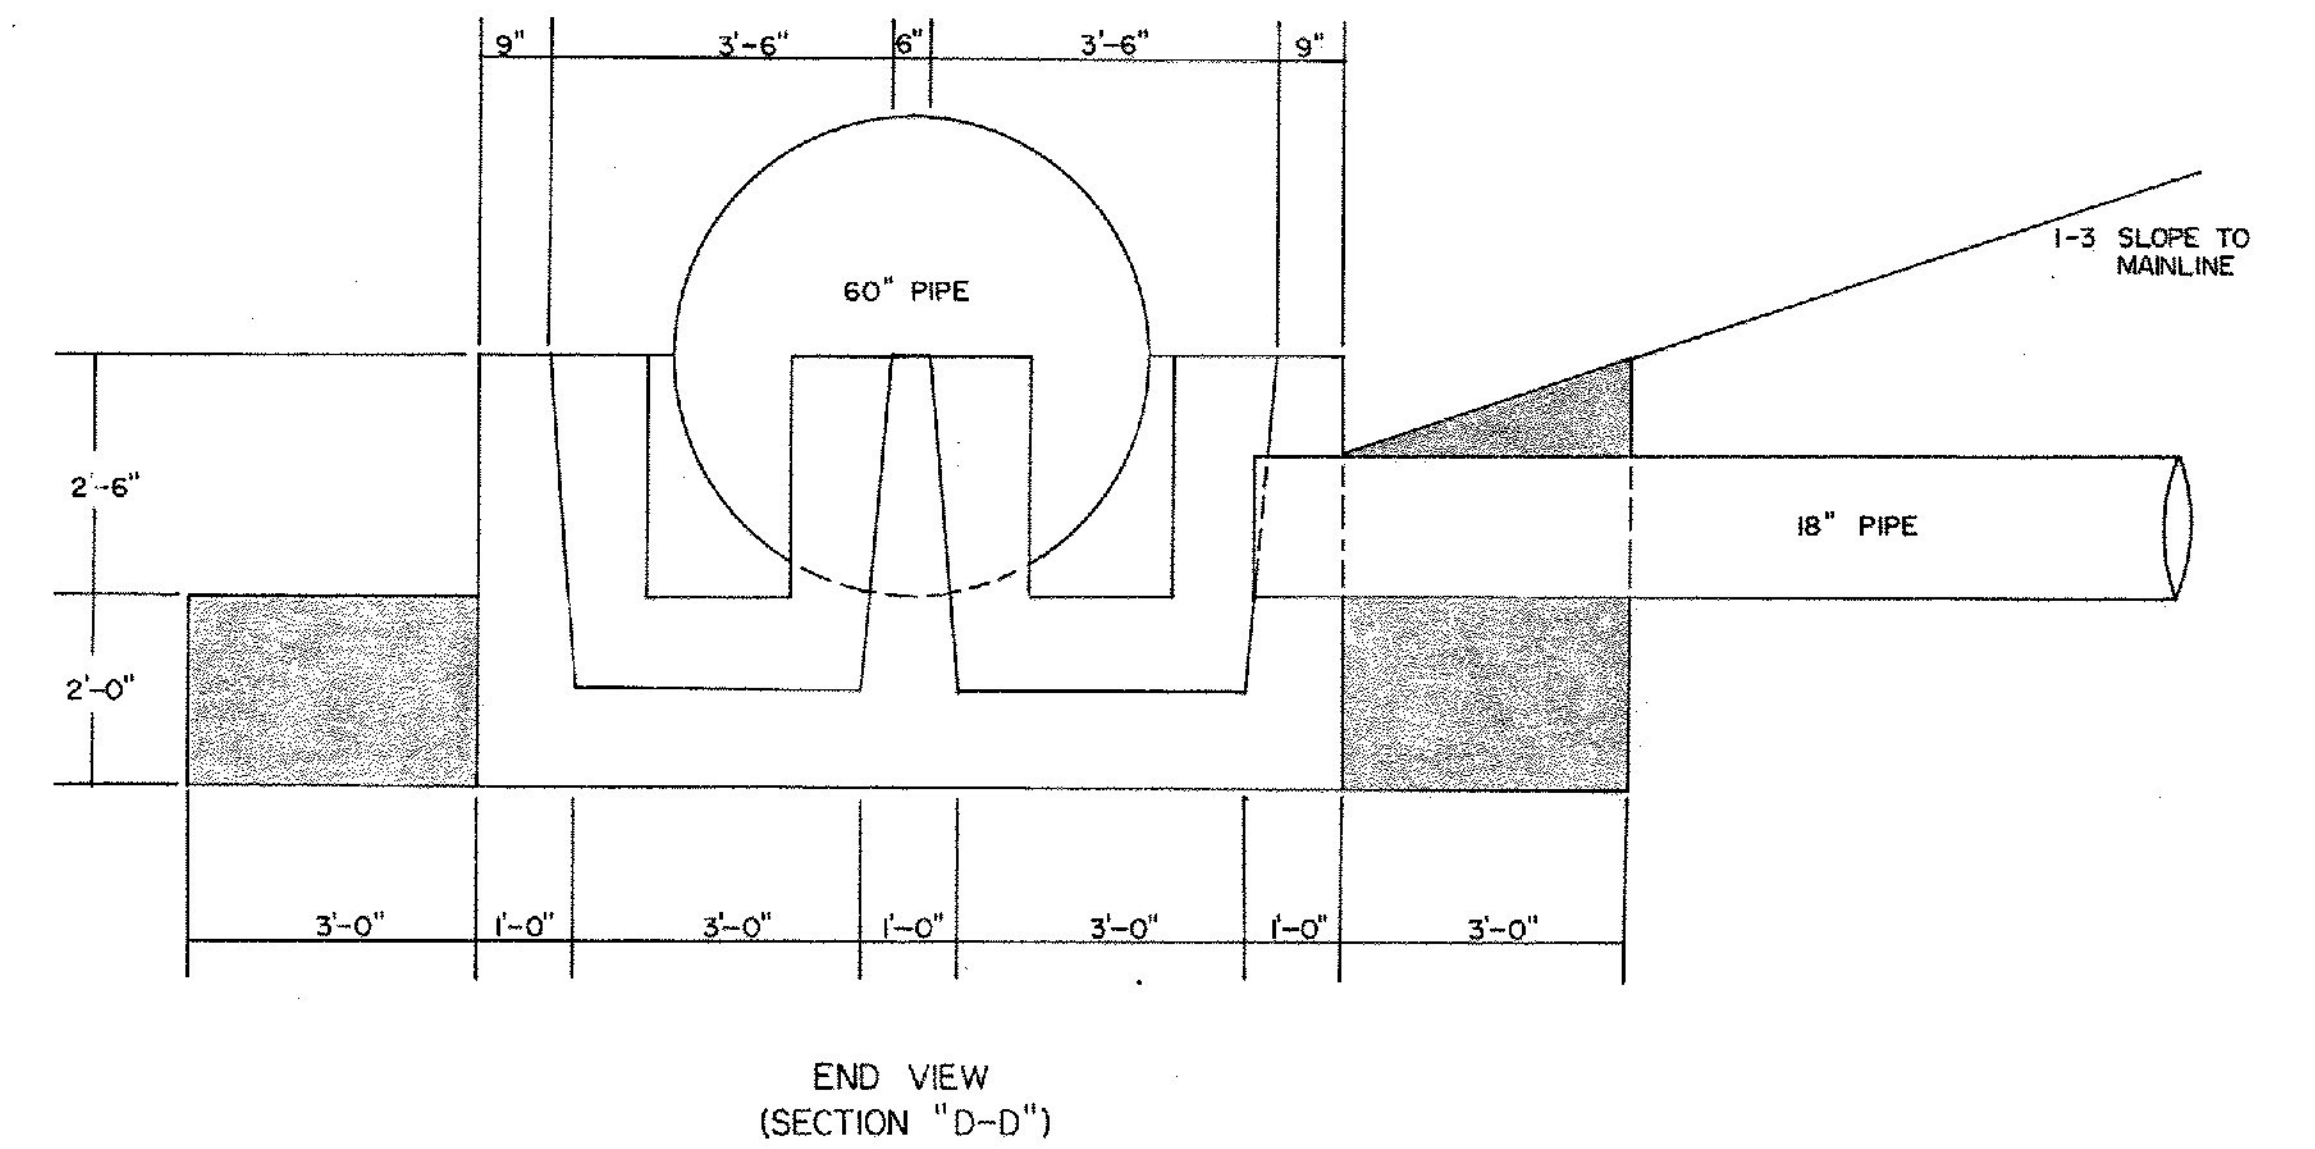


# MOD. OUTLET AT 972+27 LT.

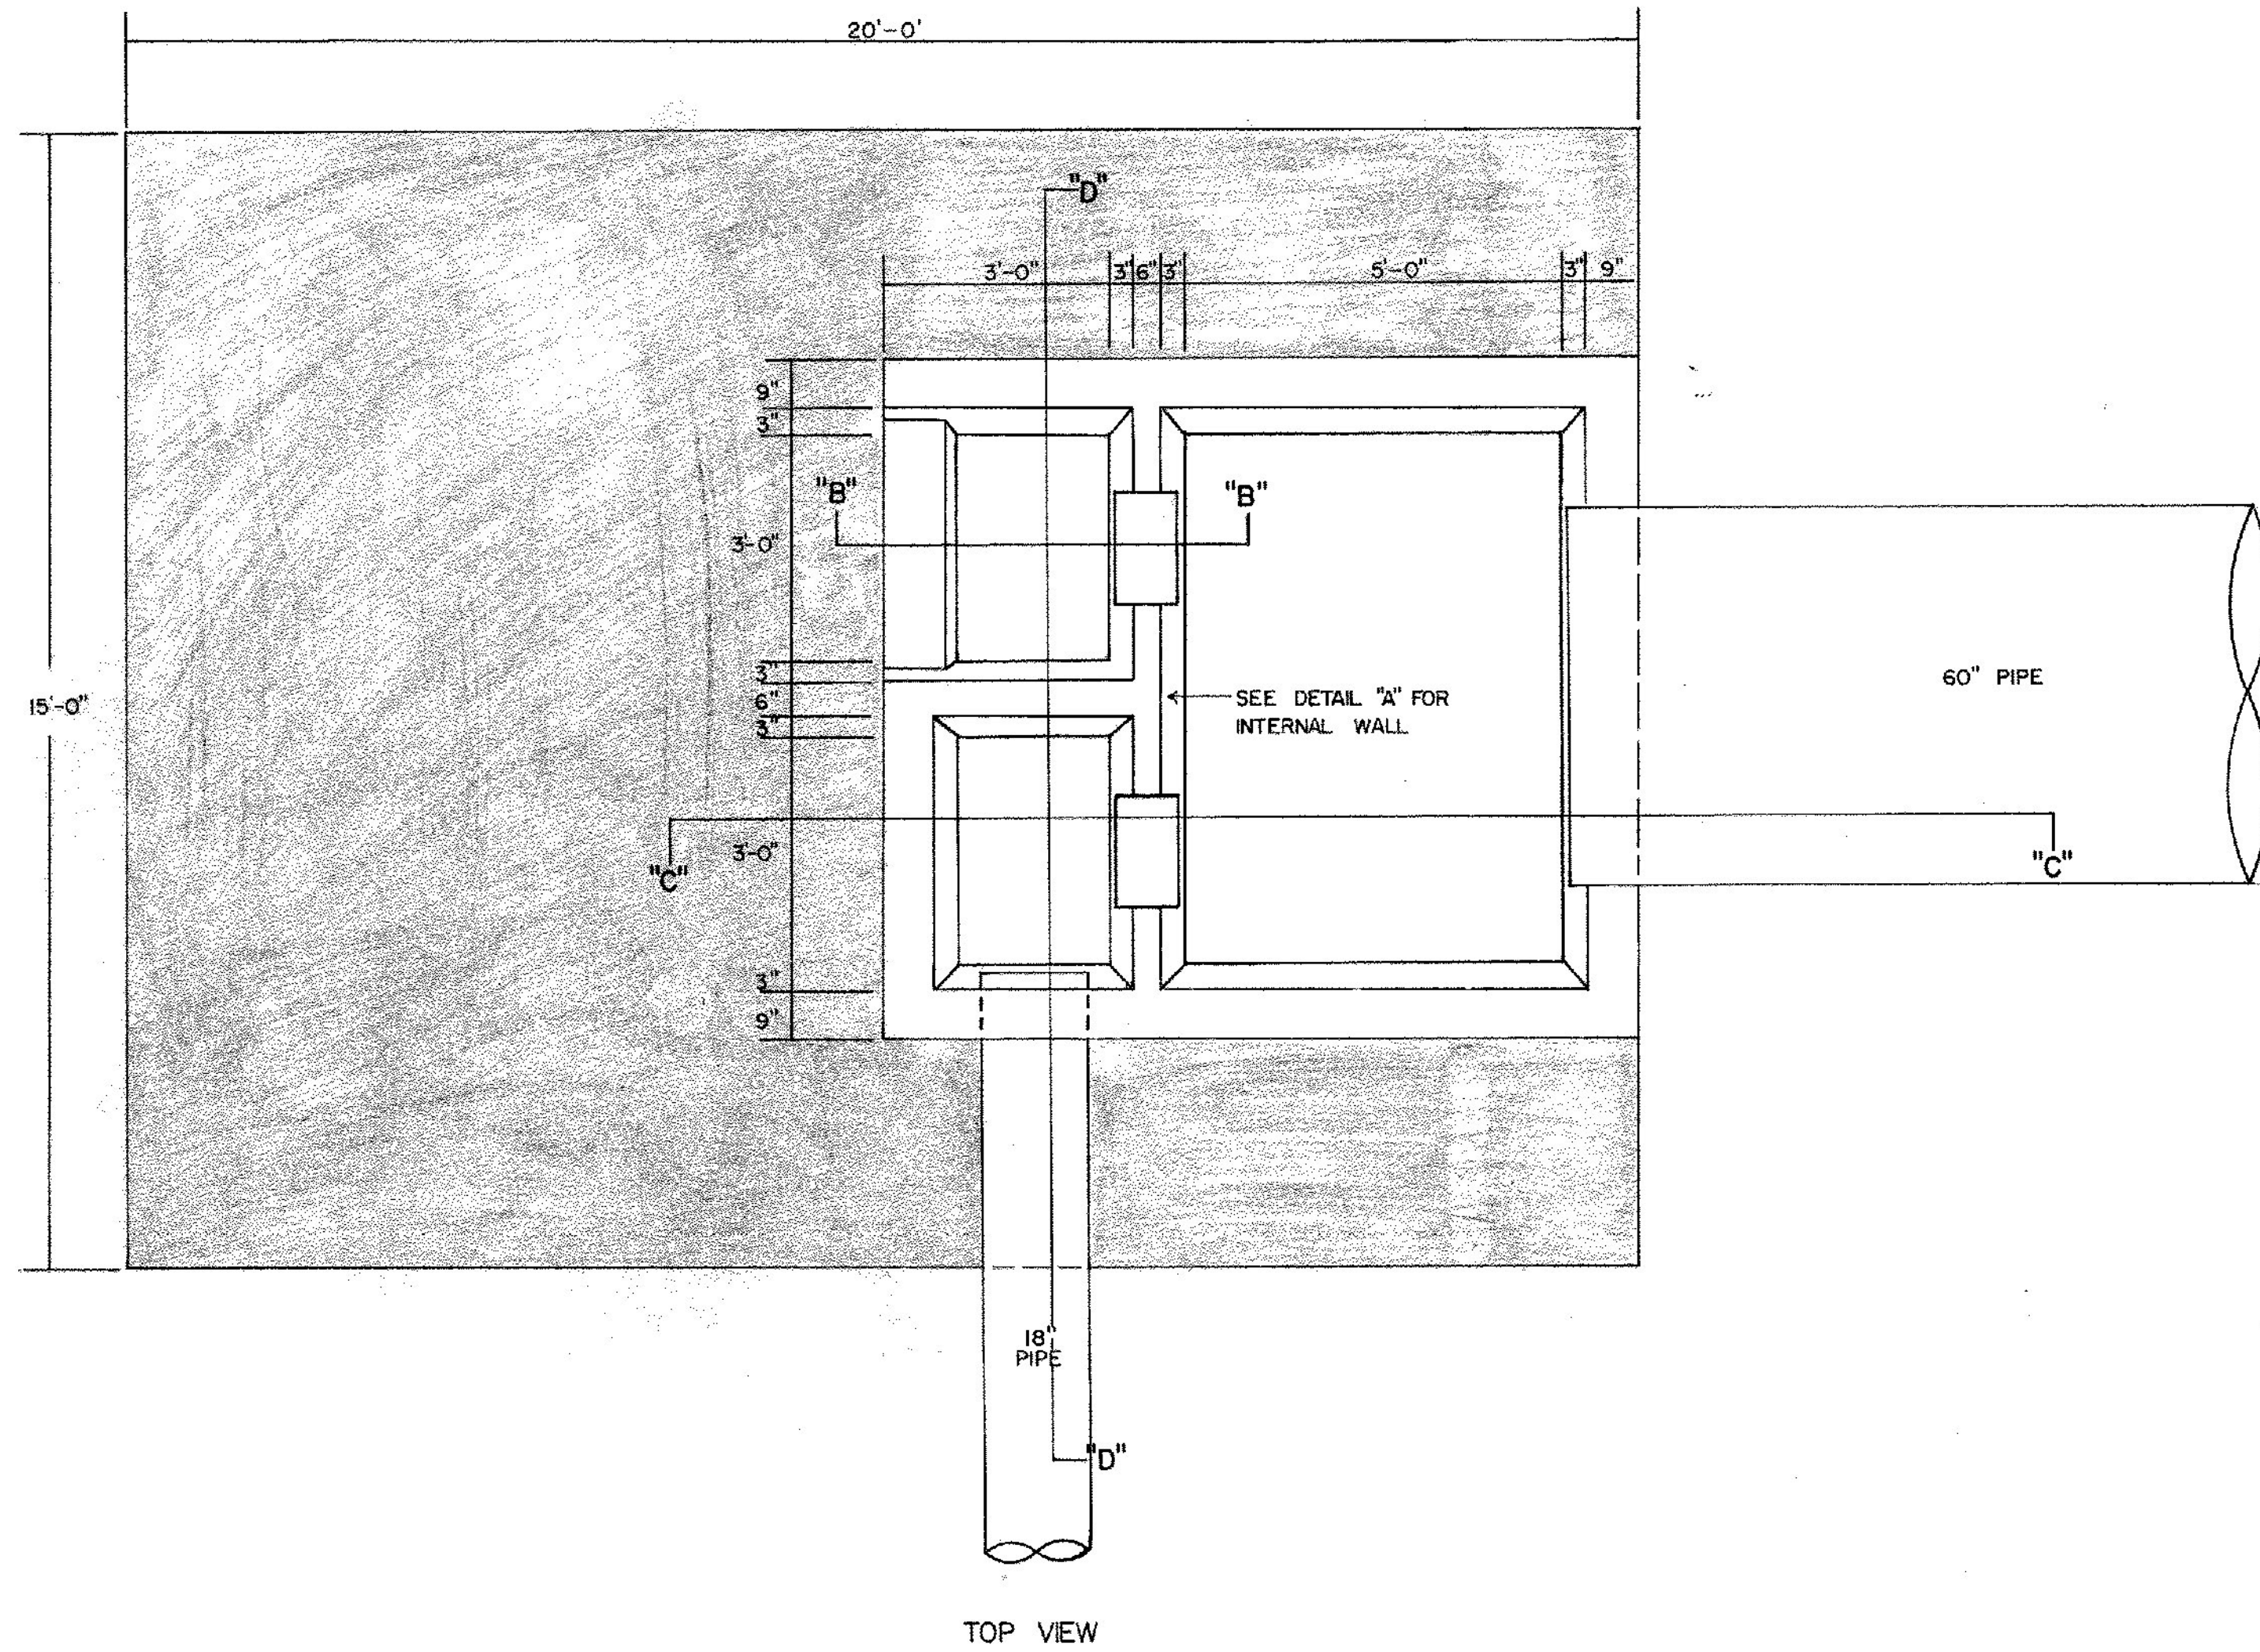

NOTES: SHADED AREA TO BE TYPE I STONE FILL, ITEM 613.10.  
PIPES TO BE ANCHORED TO THE CONCRETE AS SHOWN ON VERMONT DEPARTMENT OF STANDARDS D-2

SEE SHEET 7 OF SHEETS FOR GENERAL NOTES