


GUARD RAIL, STANDARD STEEL BEAM W/ STEEL POSTS, TYPE II, 6'-3" SPACING
 EB 972+00 TO 972+78 RT.
 EB 974+67± TO 987+00 RT.
 WB 972+00± TO 972+28± LT.
 WB 974+17± TO 987+00 LT.

APPROACH RAILING
 EB 972+78 TO 973+05± RT.
 EB 972+00 TO 973+00± RT.
 EB 974+40 TO 974+67± RT.
 EB 974+40 TO 975+52± LT.
 WB 972+00 TO 972+55± RT.
 WB 972+28 TO 972+55± LT.
 WB 973+90± TO 974+17± LT.
 WB 973+90± TO 976+15± RT.

WOVEN WIRE FENCE W/STEEL POSTS
 WB 972+00 TO 972+55 LT.
 EB 972+00 TO 973+05 RT.
 EB 974+40 TO 988+00 RT.
 WB 973+90 TO 988+00 LT.

TREATED TIMBER CURB
 EB 972+00 TO 973+05 RT.
 WB 972+00 TO 972+55 LT.
 WB 973+90 TO 988+00 LT.
 EB 974+40 TO 988+00 RT.

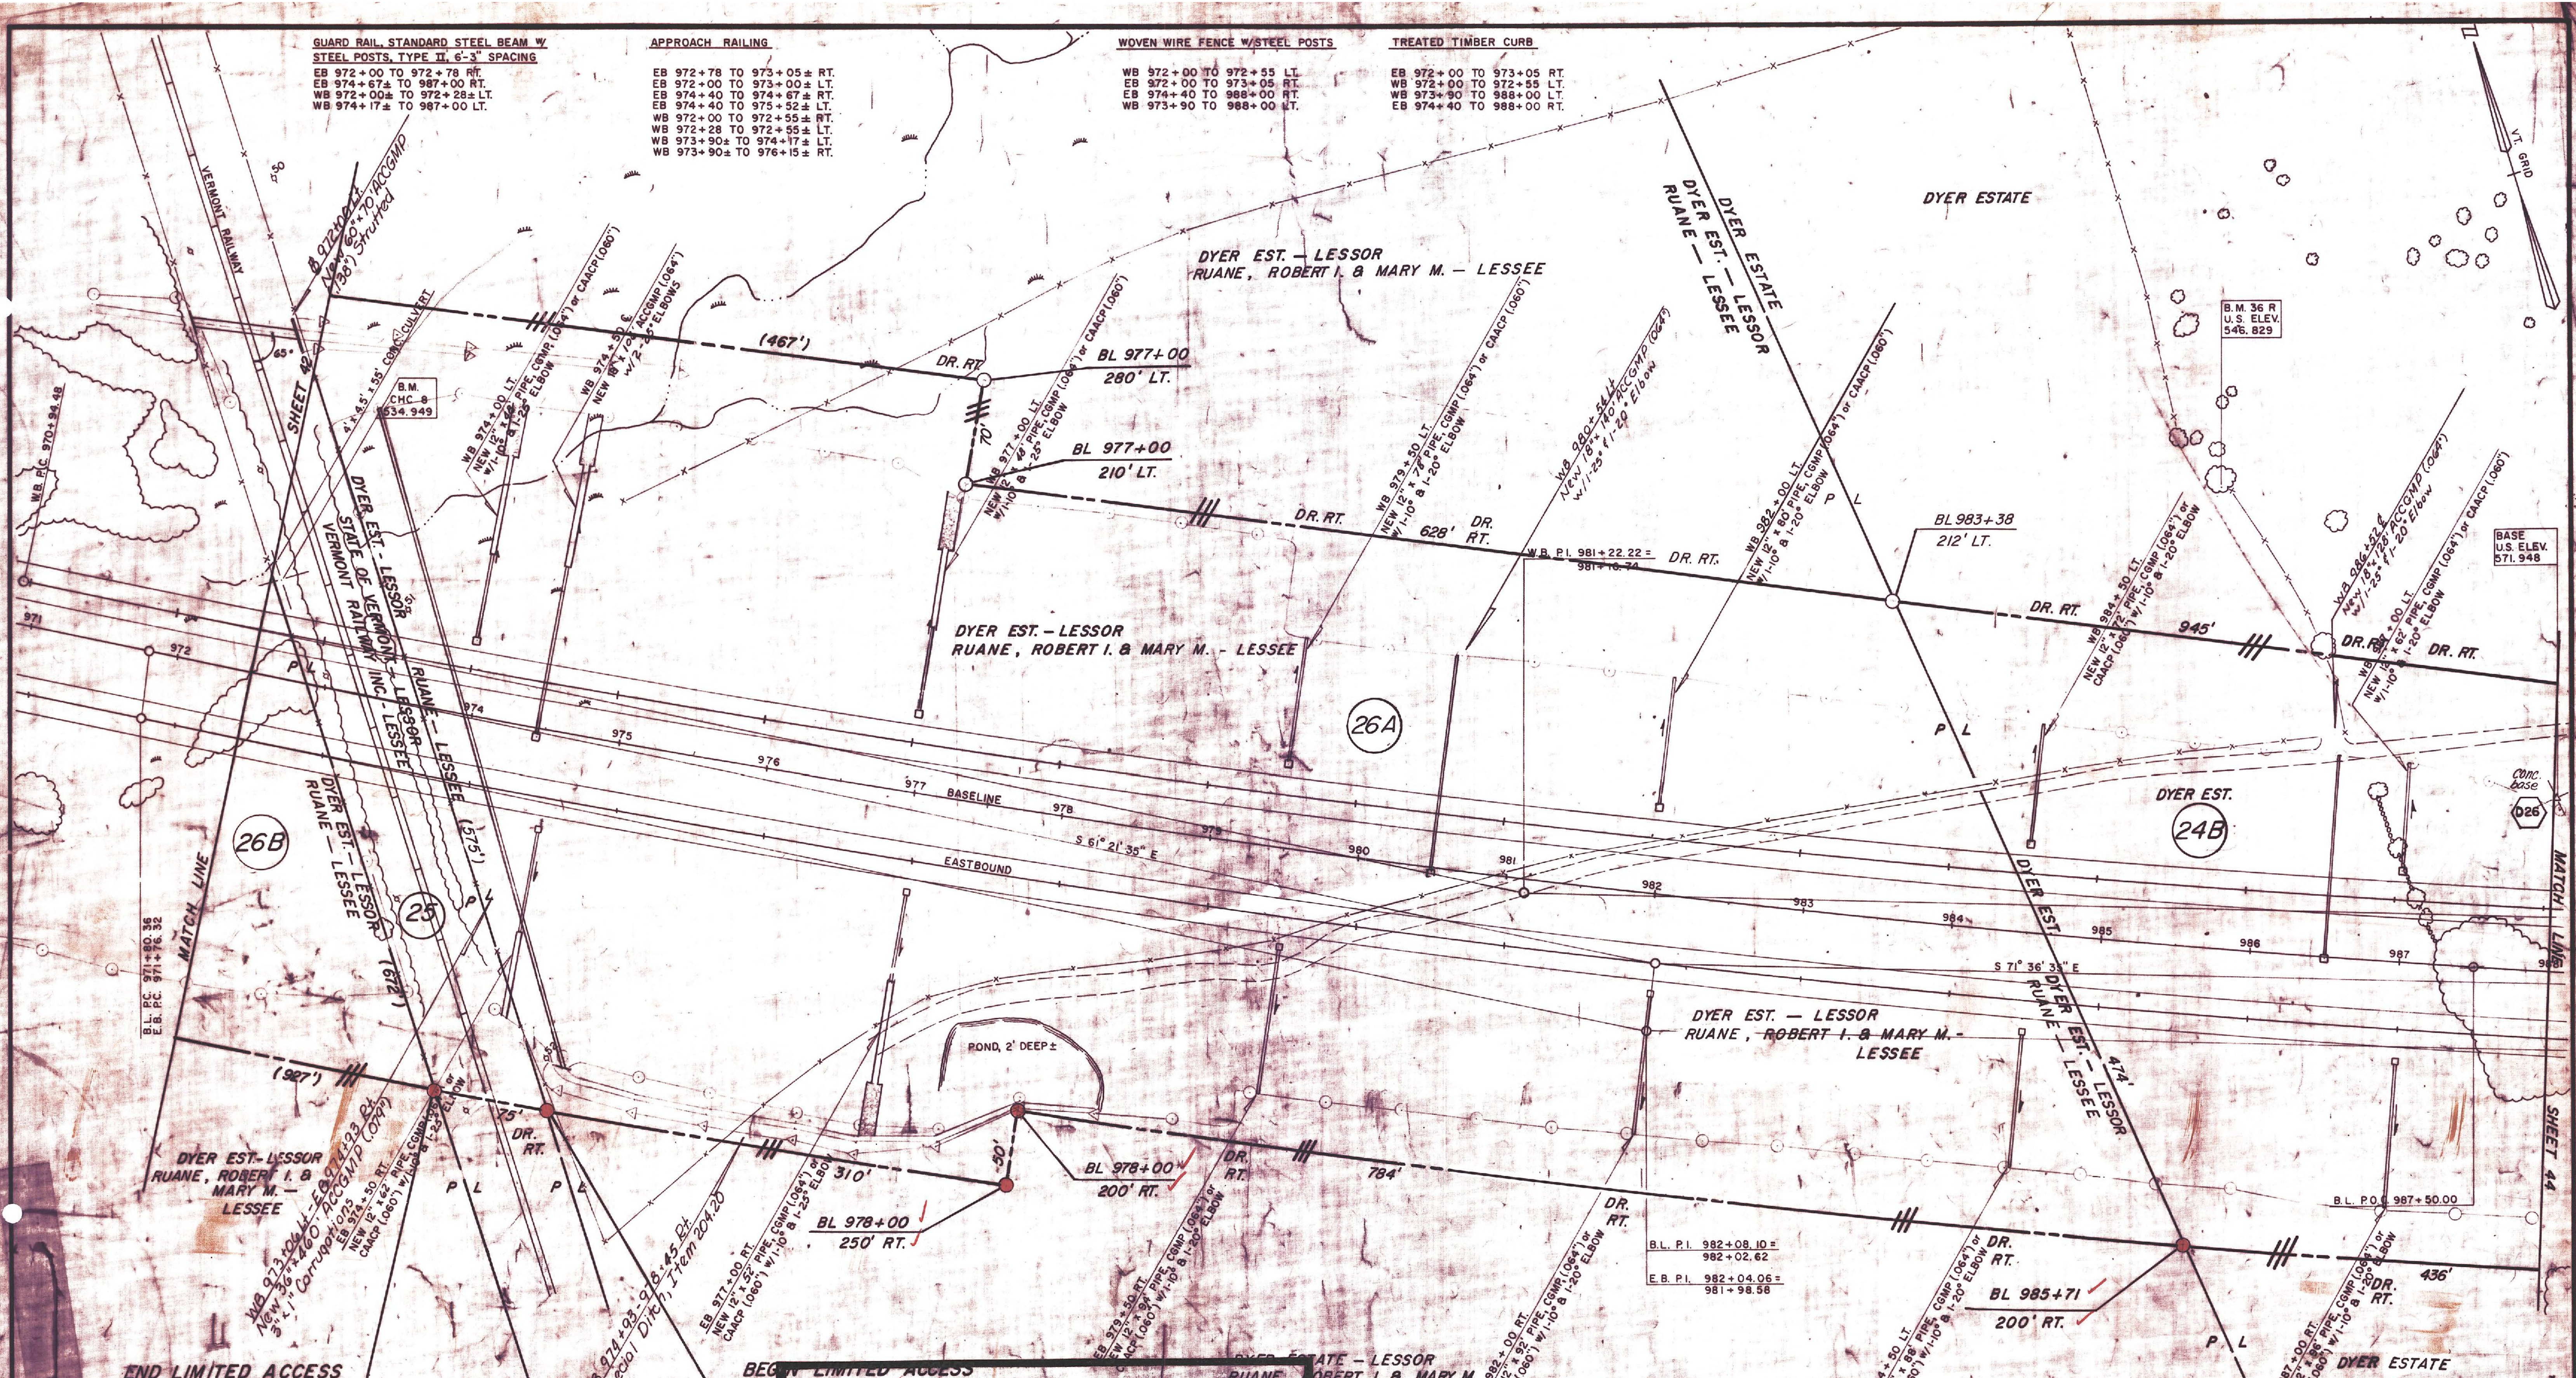

26B

26A

24B

026

END LIMITED ACCESS
 STA. BL 974+22
 250' RT.

BEGIN LIMITED ACCESS
 STA. BL 974+96
 250' RT.

THIS SHEET TO BE USED
 FOR ROW INFORMATION ONLY

UNCLASSIFIED CHANNEL EXCAVATION ITEM 203.27
 WB 972+37 TO 975+00 LT.

STONE FILL, TYPE I, ITEM 61310
 WB 972+37 TO 973+00 LT.

COUNTERWEIGHT BERM
 WB 972+00 TO 979+00 LT.
 EB 972+00 TO 979+00 RT.

A 10' 15" LT.
 D 0' 30"
 R 11459.16
 T 1027.74
 L 2050.00
 E 46.00
 DO NOT BANK

PLAN SCALE
 1" = 40'

ROW PLANS
 WEST RUTLAND-RUTLAND

SURVEYED BY FALL DATE JUNE 75
 DRAWN BY DZG DATE JULY 75
 TRACED BY DZG DATE JULY 75

PROJ. F NO. 020-1(11)
 ROW SHEET 43
 SHEET 47 OF 459