

SAND BORROW
 EB 891+00 ~ 892+00
 WB 891+00 ~ 892+00

WOVEN WIRE FENCE
 EB 891+00 RT ~ 892+00 RT
 WB 891+00 LT ~ 892+00 LT

BM 21 - R
 CH. ON BGL
 U.S. ELEV.
 757.052

BM 22 - R
 SITE M.
 U.S. ELEV.
 777.972

BL. POC. 887+80.00 =
 T.R. 22 P.O.T. 25+00.00
 455° 39'

MIXED HARD
 &
 SOFT WOODS

REV. WB. P.O.T. 891+50.00
 BL. PT. 890+04.80
 EG. = +148.90 = 890+01.94
 +50
 W.B. 891+00 ~ 892+00 RT
 New 6" x 8" X 20' UNDERDRAIN
 W/ FLUSHING BASIN @ 891+50 +50


REV. WB. P.O.T. 891+51.70
 BL. PT. 890+04.80
 EG. = +148.90 = 890+01.94
 +50
 W.B. 891+00 ~ 892+00 LT
 New 6" x 8" X 20' UNDERDRAIN
 W/ FLUSHING BASIN @ 891+50 +50

CURVE DATA

BL & EB	46° 49' 43 RT
D	1°
R	5729.58
T	2481.11
L	4682.86
E	514.14
Bank	.036 Ft./Ft.

DATUM
 VERTICAL _____
 HORIZONTAL _____

* DENOTES STAGE II ITEM

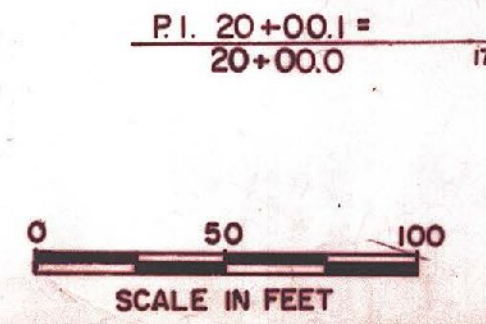

876+00 - 892+00
 WEST RUTLAND - RUTLAND

SURVEYED BY PHOTO DATE _____
 DRAWN BY _____ DATE _____
 TRACED BY RJM DATE 10/83

STAGE I CONSTRUCTION

PROJ. F-EGC-FNO. 020 - 1 (10)
 SHEET 61 OF 459

NOTE: FOR TIES SEE PROFILE SHEET