


PLAN  
 SURVEYED  
 ALIGNMENT CHECKED  
 NOTE BOOK RT. OF WAY CHECKED  
 NO.



PROFILE  
 SURVEYED  
 GRADES CHECKED  
 S.M. NOTED  
 STRUCTURE NOTATIONS CHECKED  
 NO.

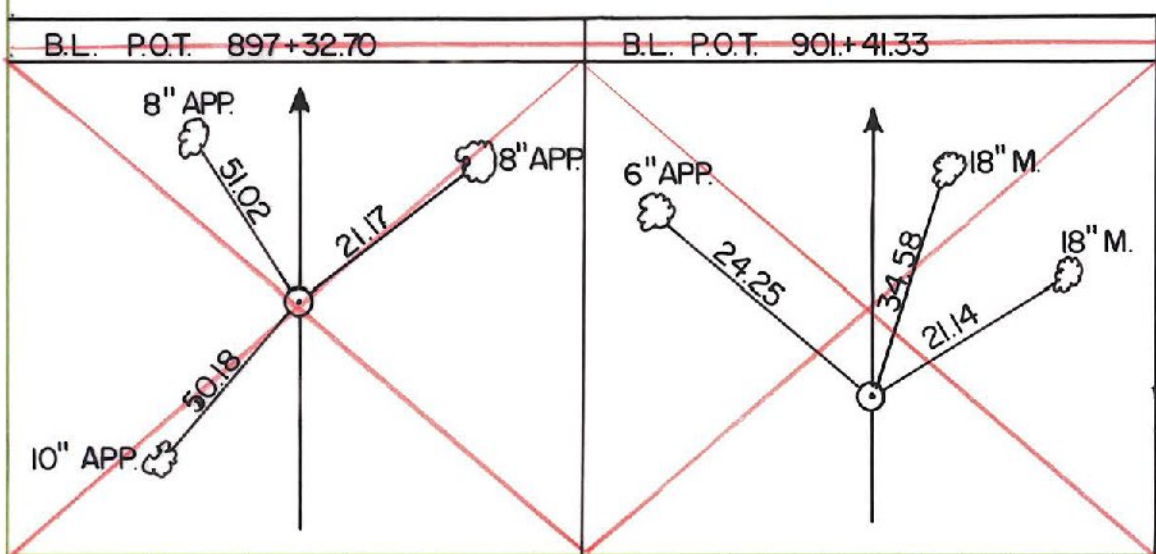