

SAND BORROW  
EB 908 +00 ~ 920 +75  
WB 908 +00 ~ 921 +50

EROSION MATTING  
EB Bench 908+00-911+00  
WB Bench 908+00-909+00

WOVEN WIRE FENCE  
EB 908 +00 RT ~ EB 924 +00 RT  
WB 914 +00 LT ~ WB 924 +00 LT


CHAIN LINK FENCE  
WB 908 +00 LT ~ WB 914 +00 LT

BL. 13° 42' 23" LT  
D 1°  
R 5,729.580  
T 688.58  
L 1,370.64  
E 41.23

EB. 13° 42' 23" LT  
D 0.992207°  
R 5,774.56  
T 694.02  
L 1,381.40  
E 41.56  
BANK 0.036 FT/FT

REV. WB. 13° 42' 23" LT  
D 1° 30'  
R 5,819.72  
T 459.07  
L 913.76  
E 27.49  
BANK 0.040 FT/FT

BM 28 RB  
512' 12" PINE  
125' RT WB 921+40  
Elev. 682.52

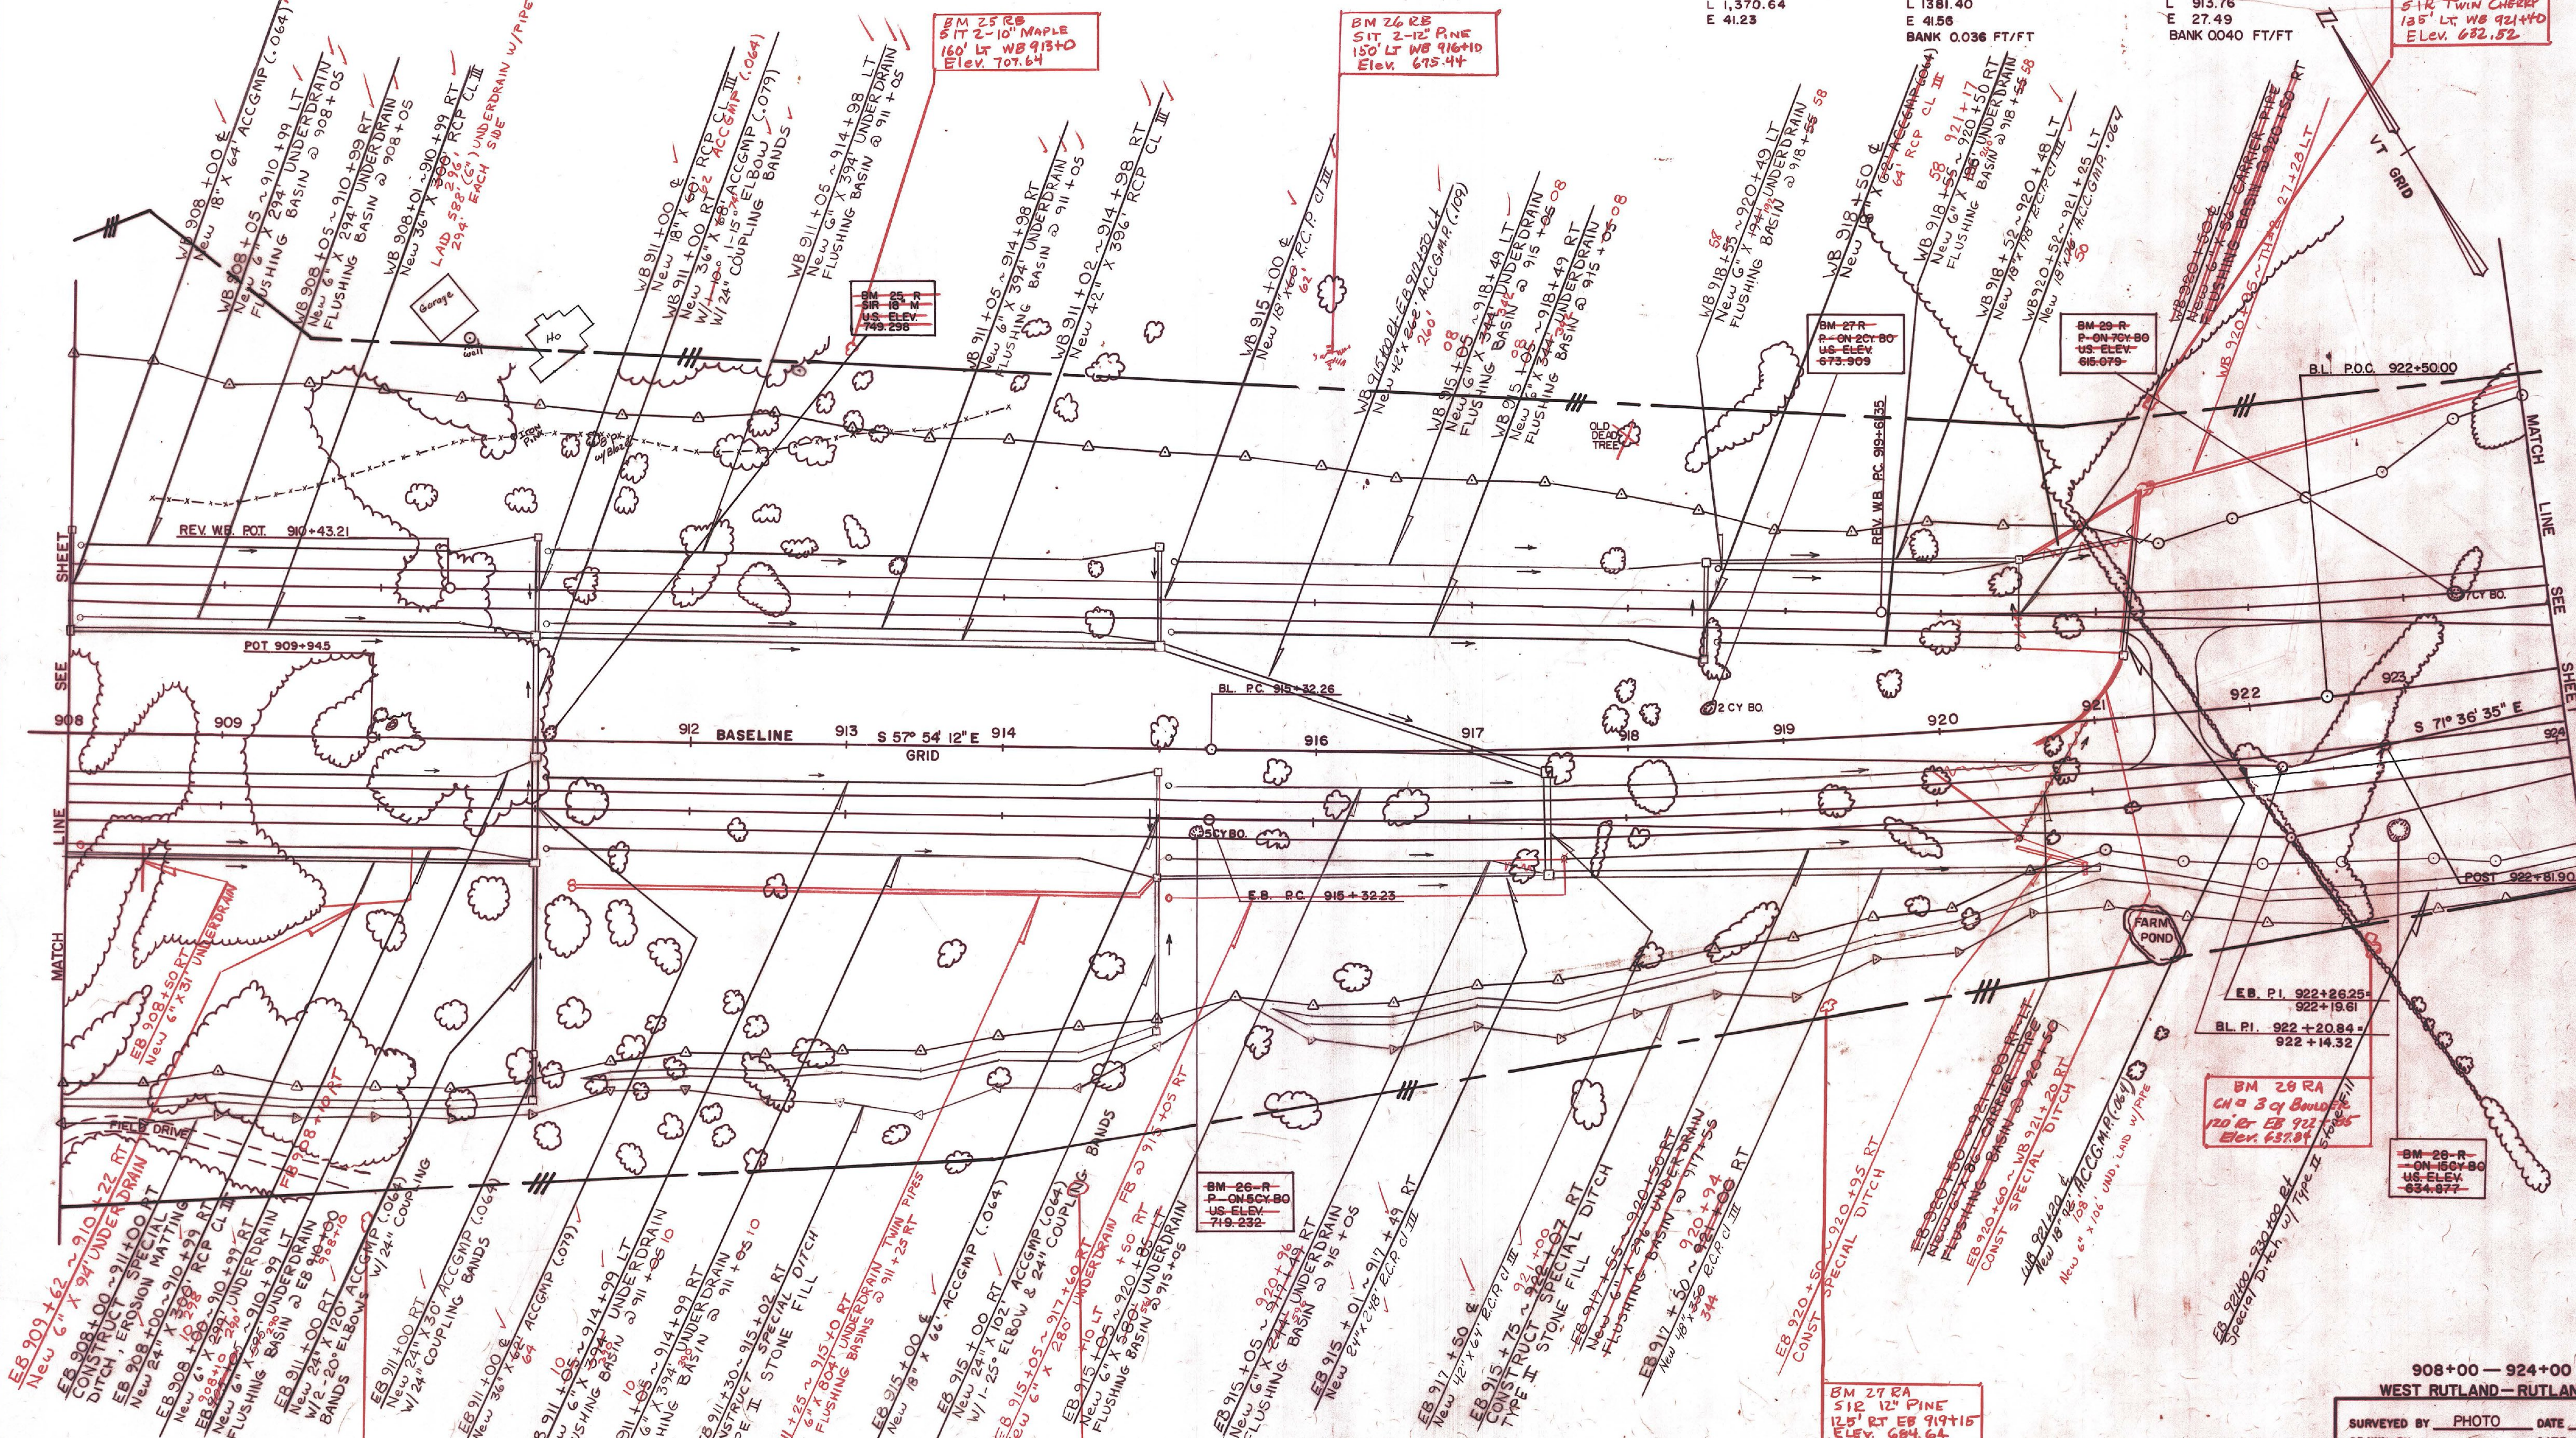

DATUM  
VERTICAL \_\_\_\_\_  
HORIZONTAL \_\_\_\_\_

BM 25 RA  
512' 16" MAPLE  
310' RT EB 909+75  
ELEV. 780.81

BM 26 RA  
CH # 2 CY BOULDER  
240' RT EB 914+50  
Elev. 742.48

BM 27 RA  
512' 12" PINE  
125' RT EB 919+15  
Elev. 684.64

BM 28 RA  
CH # 3 CY BOULDER  
120' RT EB 922+55  
Elev. 657.84

BM 28-R  
CH # 3 CY BOULDER  
120' RT EB 922+55  
US. ELEV. 654.877

\* DENOTES STAGE I ITEM

0 50 100  
SCALE IN FEET

NOTE: FOR TIES SEE PROFILE SHEET

908+00 - 924+00  
WEST RUTLAND - RUTLAND

SURVEYED BY PHOTO DATE \_\_\_\_\_  
DRAWN BY \_\_\_\_\_ DATE \_\_\_\_\_  
TRACED BY RJM DATE 9/83

STAGE I CONSTRUCTION

PROJ. F-EGC-FNO. 020-1(10)  
SHEET 65 OF 459