
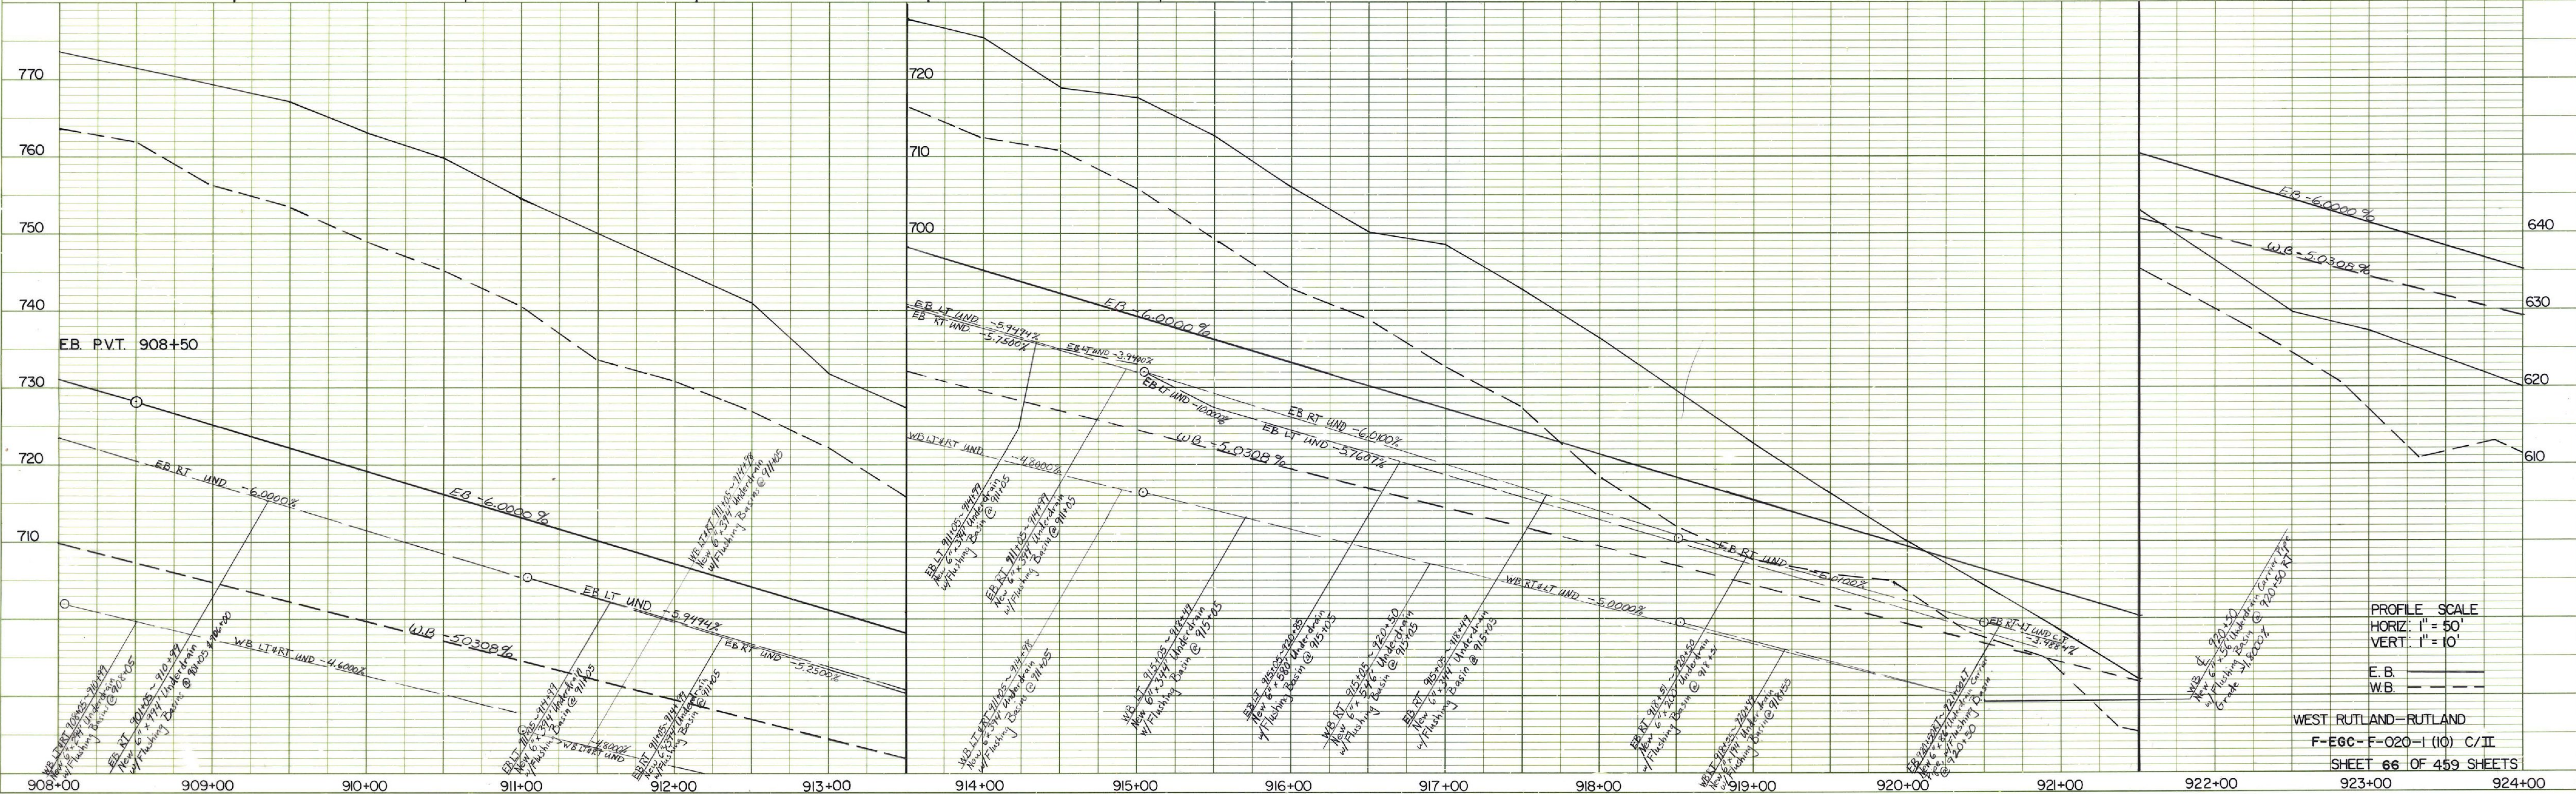


PLAN
 SUBMITTED: _____
 PLOTTED: _____
 ALIGNMENT CHECKED: _____
 RT. OF WAY CHECKED: _____
 NO. _____

PROFILE
 SUBMITTED: _____
 PLOTTED: _____
 GRADES CHECKED: _____
 STRUCTURE NOTATIONS CHKD: _____
 NO. _____

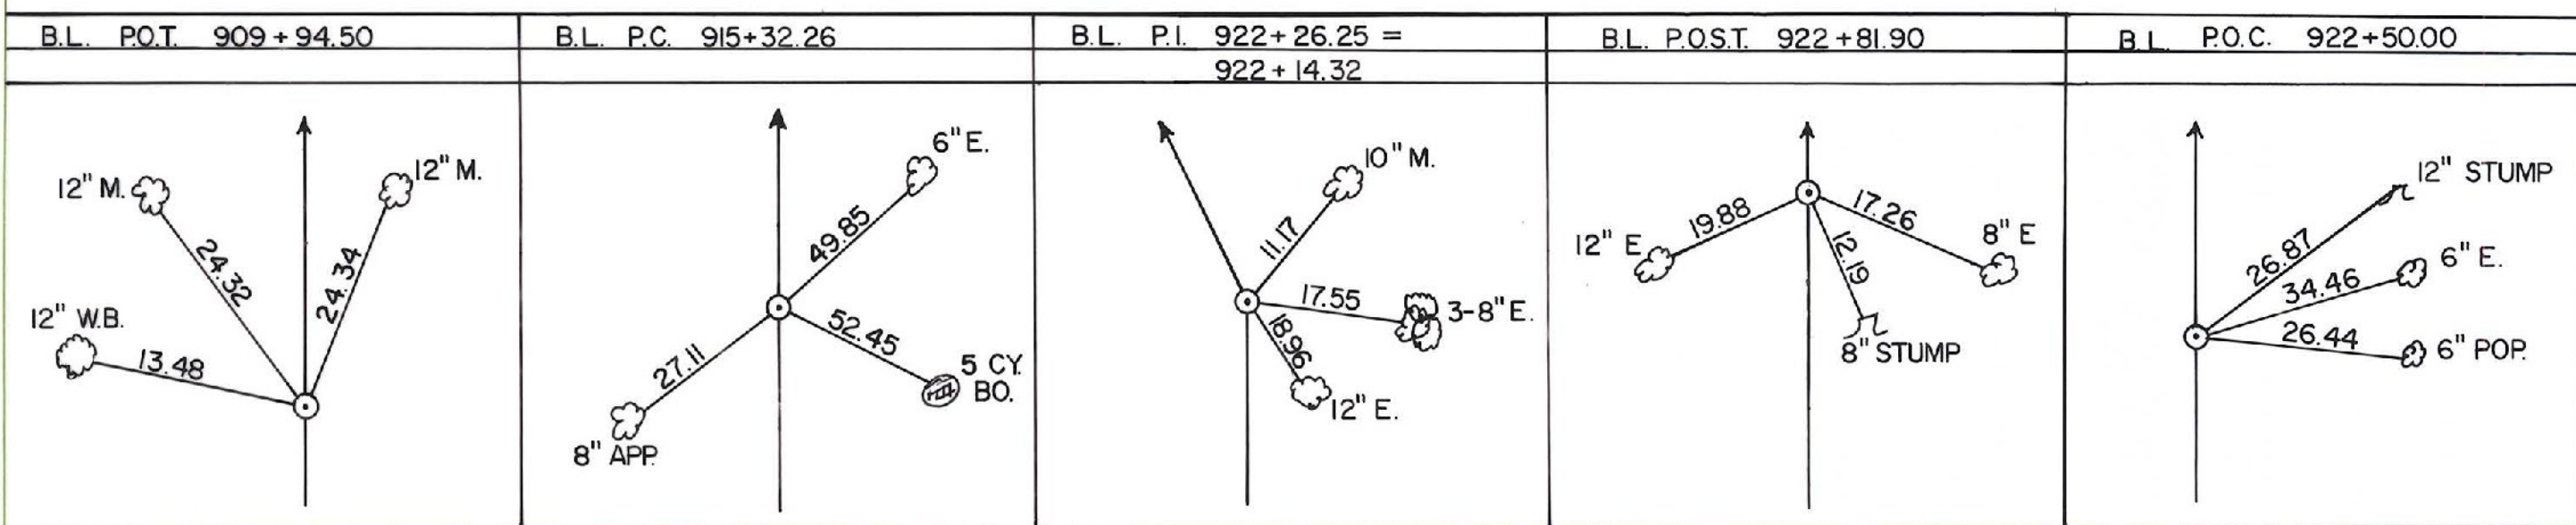

BRUNING 44-131 54278

PROFILE SCALE
 HORIZ: 1" = 50'
 VERT: 1" = 10'
 E.B. _____
 W.B. _____
 WEST RUTLAND - RUTLAND
 F-EGC-F-020-1 (10) C/II
 SHEET 66 OF 459 SHEETS