

BLASTED ROCK FILL (Rock Borrow)
 EB 935+75 ~ 940+00
 WB 935+00 ~ 940+00

BM-CHC-7
 ONLY X ON PLANS
 U.S. ELEV.
 543.806

TBM 3 D
 MARBLE MKR.
 30' LT. 30+90
 ELEV. 546.04


* GUARD RAIL STD. STEEL BEAM W/ WOOD POSTS, TYPE II

EB 928+24 RT ~ 929+74 RT
 EB 928+76 LT ~ 929+51 LT
 EB 932+56 LT ~ 933+06 LT
 EB 932+78 RT ~ 933+78 RT
 WB 925+37 LT ~ 929+12 LT
 WB 928+89 RT ~ 929+39 RT
 WB 932+53 LT ~ 940+00 LT
 WB 932+79 RT ~ 933+79 RT

TBM 2-D
 S.I. POLE
 30' RT. 29+40
 ELEV. 547.01

BM #3 RB
 CHC PAX ST BRIDGE ABUT
 240' LT WB 935+85
 ELEV. 533.72

BM #3
 S.I. POLE
 U.S. ELEV.
 524.166

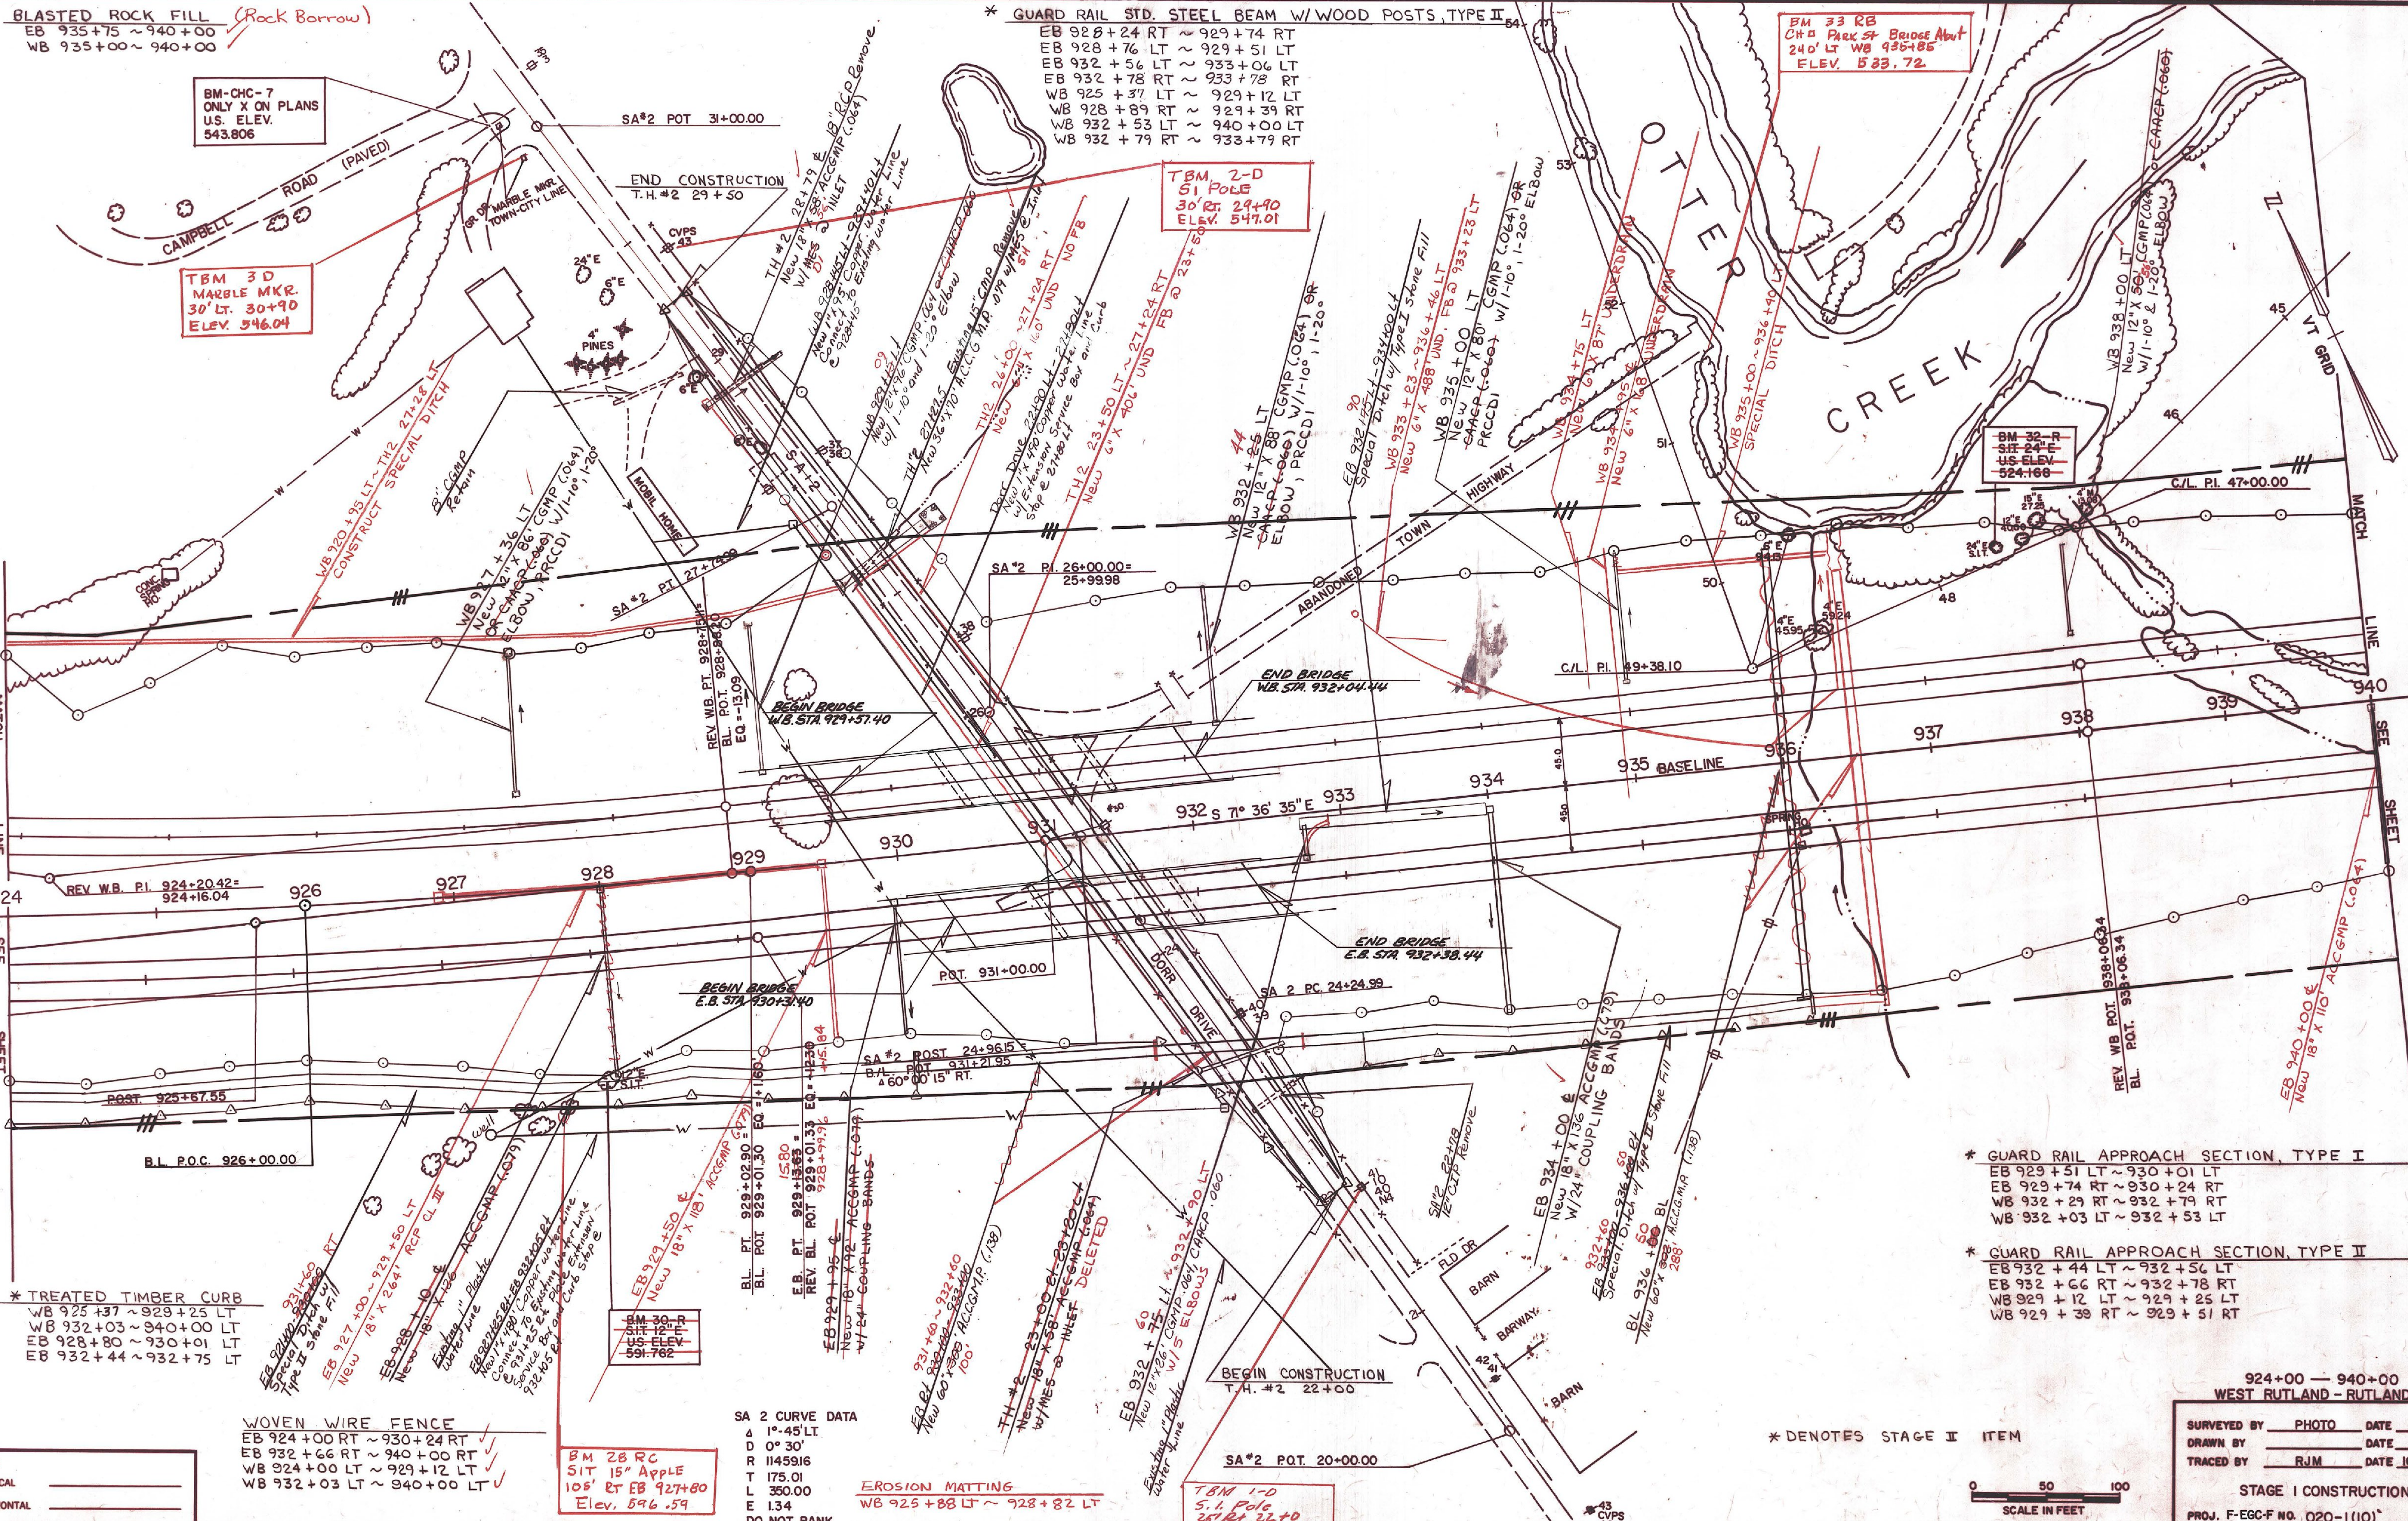

* TREATED TIMBER CURB
 WB 925+37 ~ 929+25 LT
 WB 932+03 ~ 940+00 LT
 EB 928+80 ~ 930+01 LT
 EB 932+44 ~ 932+75 LT

WOVEN WIRE FENCE
 EB 924+00 RT ~ 930+24 RT
 EB 932+66 RT ~ 940+00 RT
 WB 924+00 LT ~ 929+12 LT
 WB 932+03 LT ~ 940+00 LT

BM 28 RC
 S.I. POLE
 105' RT EB 927+80
 Elev. 546.59

SA 2 CURVE DATA
 Δ 1° 45' LT
 D 0° 30'
 R 1145916
 T 175.01
 L 350.00
 E 1.34
 DO NOT BANK

EROSION MATTING
 WB 925+88 LT ~ 928+82 LT

TBM 1-D
 S.I. POLE
 25' RT 22+0
 Elev. 551.74

* GUARD RAIL APPROACH SECTION, TYPE I
 EB 929+51 LT ~ 930+01 LT
 EB 929+74 RT ~ 930+24 RT
 WB 932+29 RT ~ 932+79 RT
 WB 932+03 LT ~ 932+53 LT

* GUARD RAIL APPROACH SECTION, TYPE II
 EB 932+44 LT ~ 932+56 LT
 EB 932+66 RT ~ 932+78 RT
 WB 929+12 LT ~ 929+25 LT
 WB 929+39 RT ~ 929+51 RT

* DENOTES STAGE II ITEM

SCALE IN FEET
 0 50 100

NOTE: FOR TIES SEE PROFILE SHEET

924+00 - 940+00
 WEST RUTLAND - RUTLAND

| | | |
|-------------|-------|------------|
| SURVEYED BY | PHOTO | DATE |
| DRAWN BY | | DATE |
| TRACED BY | RJM | DATE 10/83 |

STAGE I CONSTRUCTION
 PROJ. F-EGC-F NO. 020-1(10)
 SHEET 67 OF 459