


PLAN	SURVEYED ALIGNED RT. OF WAY CHECKED	DATE
		BY
PLAN	NOTE BOOK NO.	DATE
		BY

PROFILE	SURVEYED GRADES CHECKED STRUCTURE NOTATING CHK'D	DATE
		BY
PROFILE	NOTE BOOK NO.	DATE
		BY

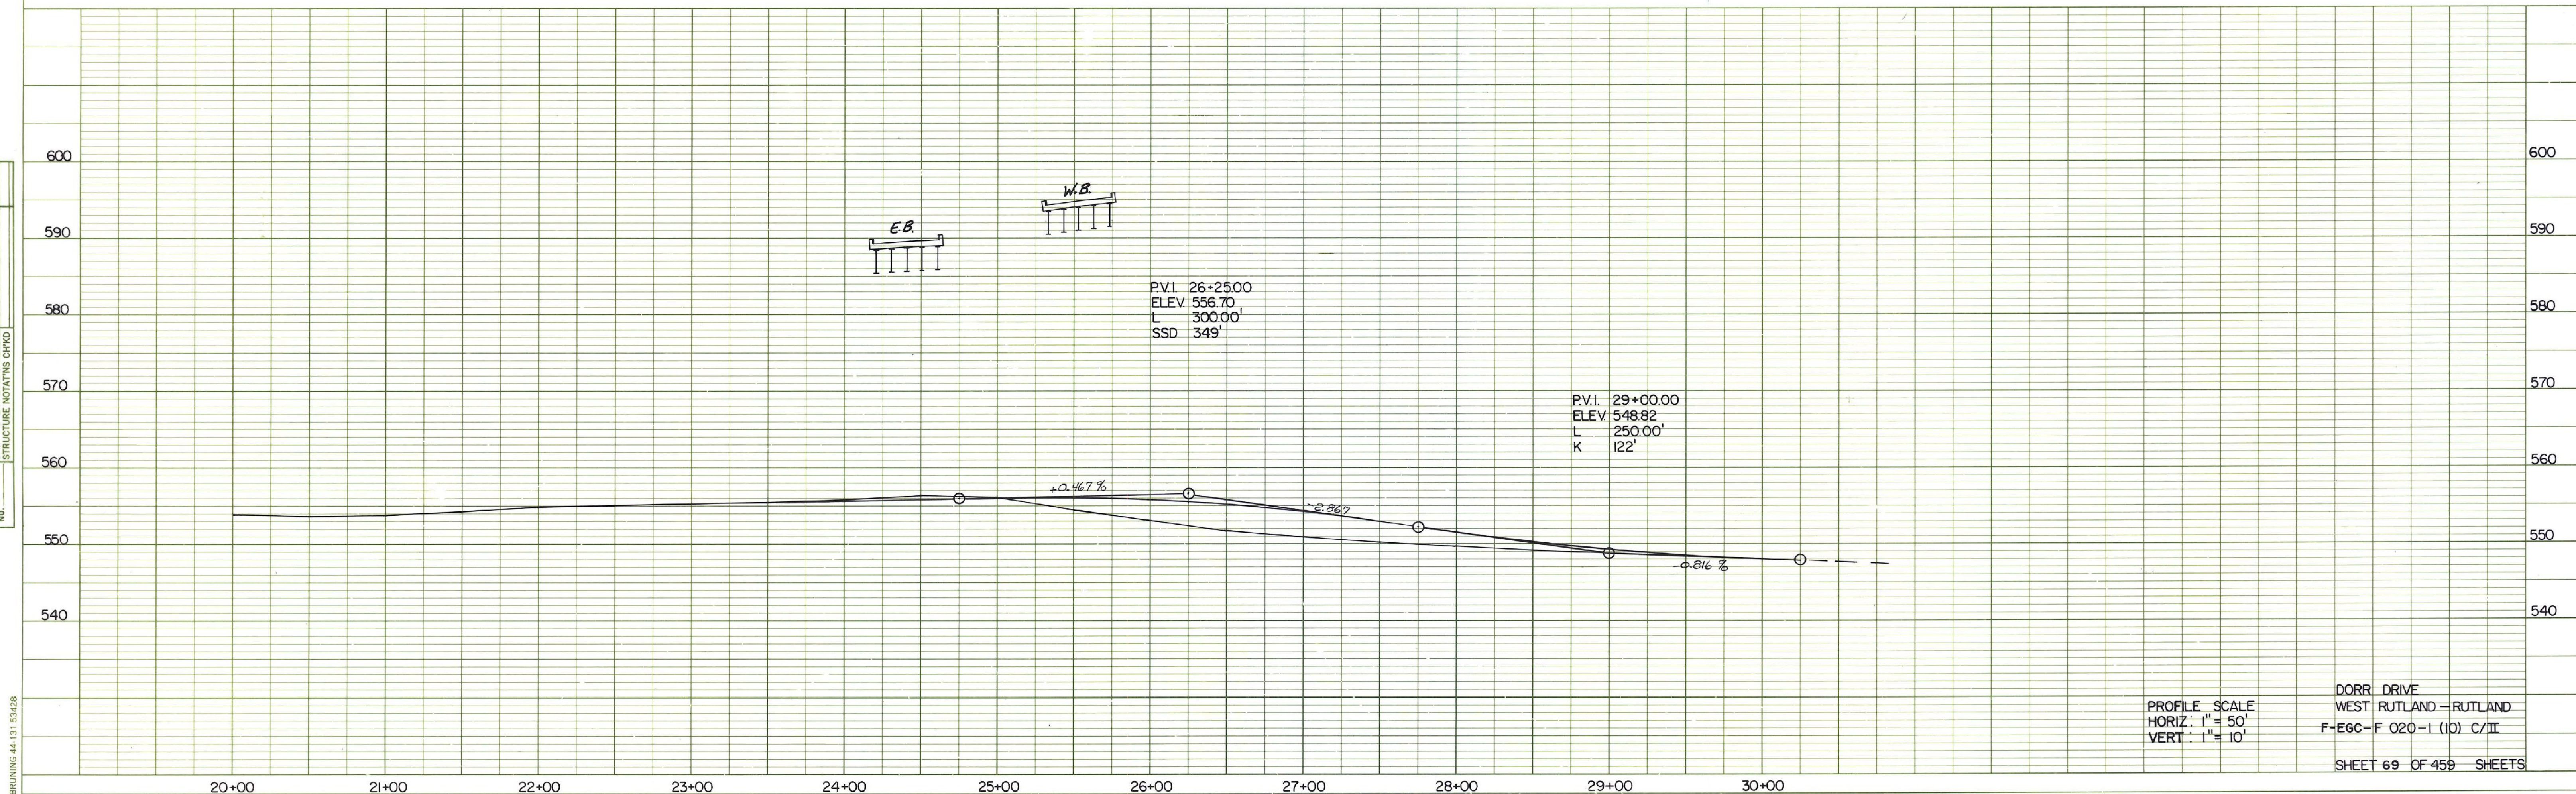

BRUNING 44-131 53428

PLATE 1 SINGLE PLAN - PROFILE
 CHARLES BRUNING CO.
 MADE IN U.S.A.

PROFILE SCALE
 HORIZ: 1" = 50'
 VERT: 1" = 10'

DORR DRIVE
 WEST RUTLAND - RUTLAND
 F-EGC-F 020-1 (10) C/II

SHEET 69 OF 459 SHEETS