
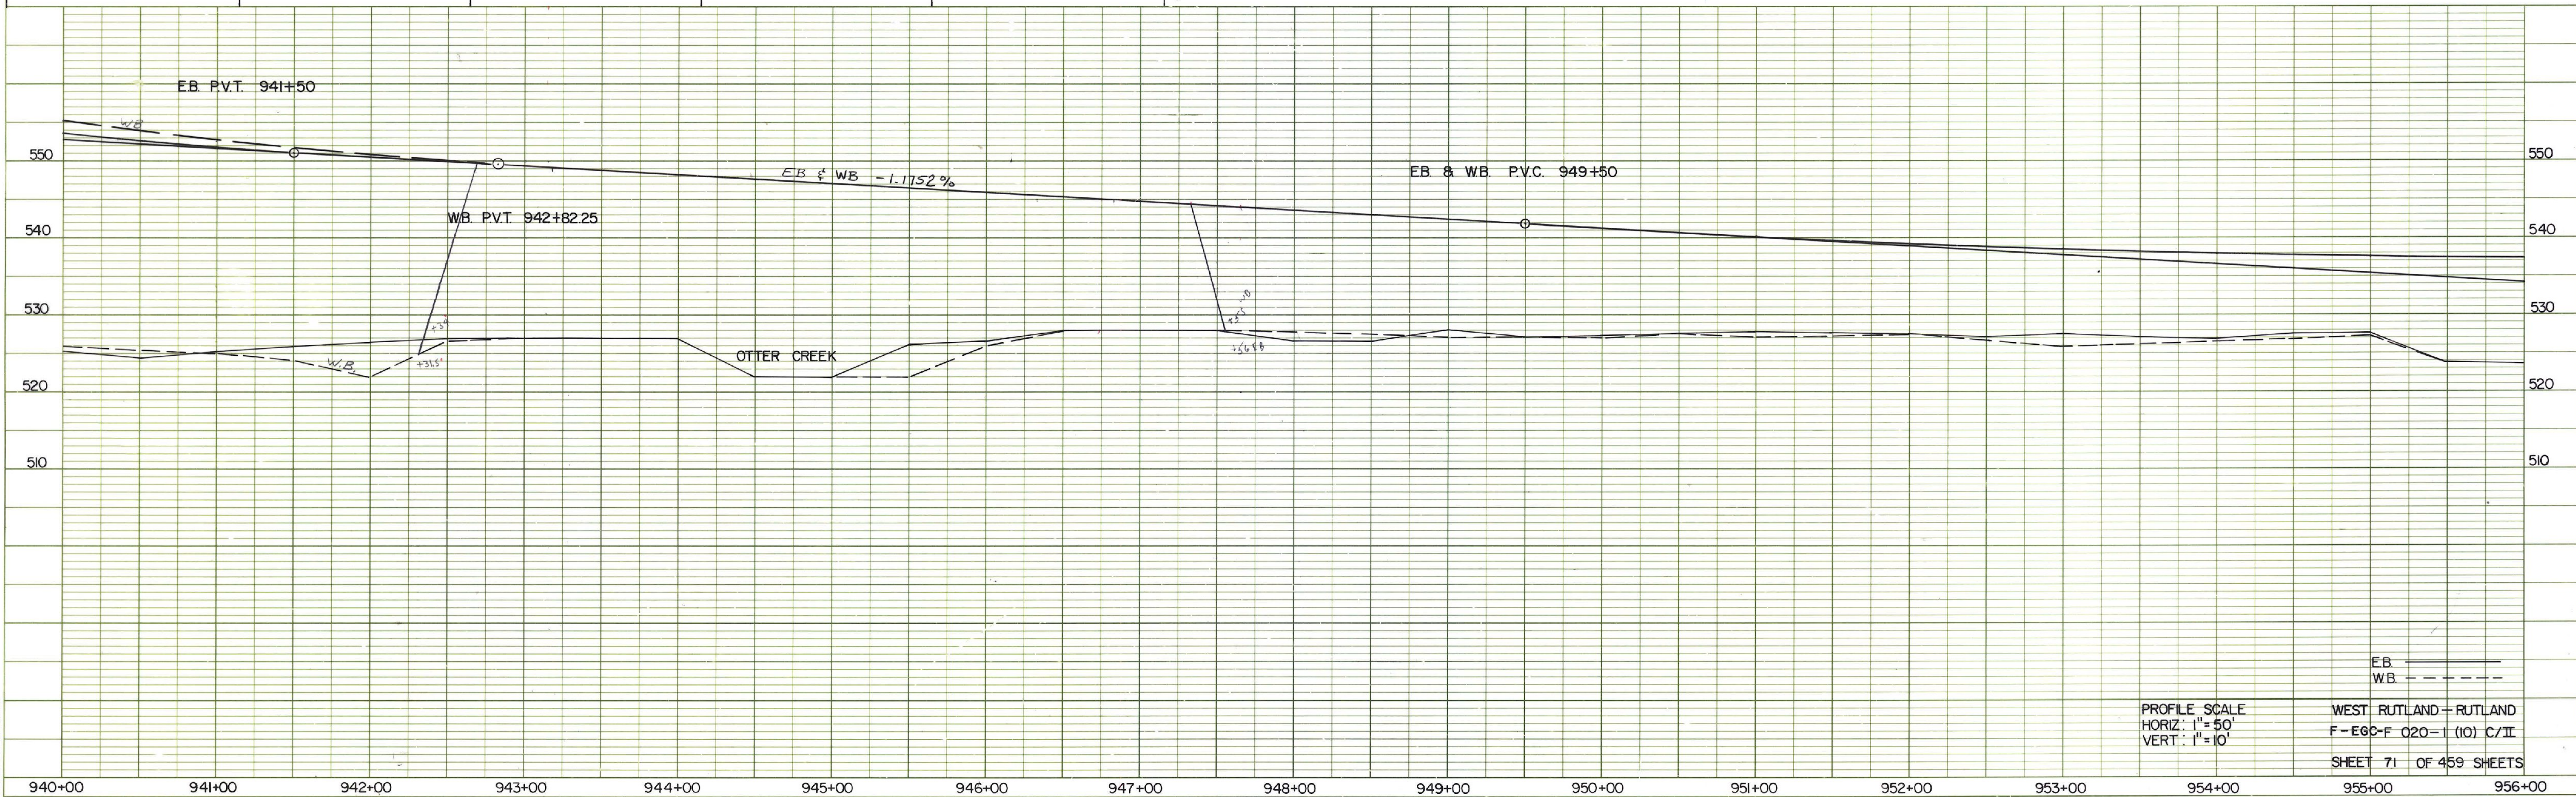


PLAN
 SURVEYED
 PLOTTED
 ALIGNMENT CHECKED
 (1) OF (1) CHECKED
 NOTE BOOK NO.

PROFILE
 SURVEYED
 GRADES CHECKED
 STRUCTURE NOTATIONS CHKD
 NOTE BOOK NO.

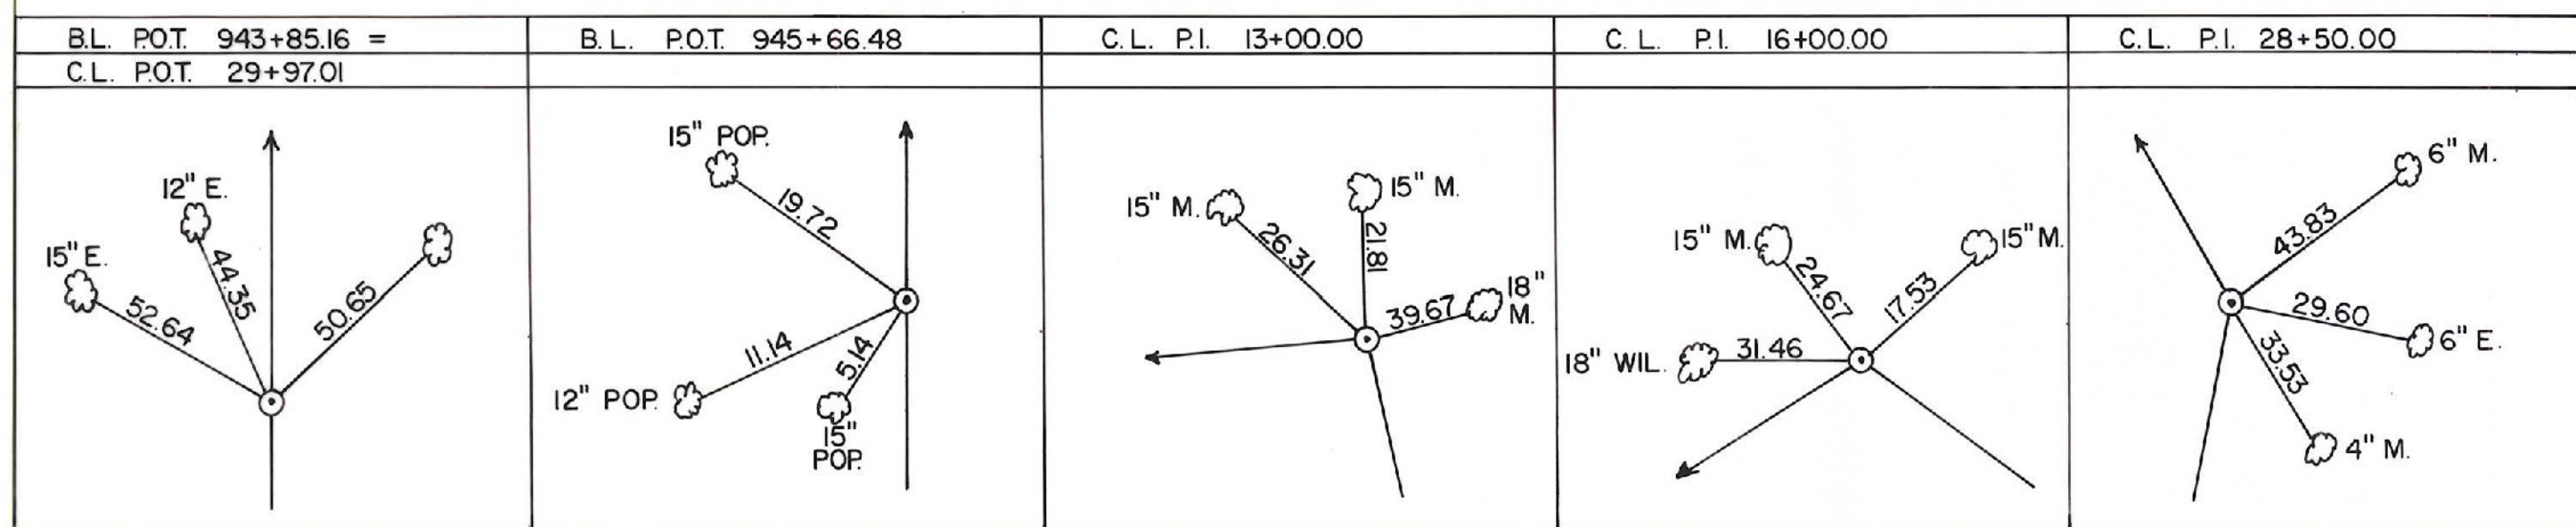

EB —————
 WB - - - - -
 PROFILE SCALE
 HORIZ: 1" = 50'
 VERT: 1" = 10'
 WEST RUTLAND - RUTLAND
 F-EGC-F 020-1 (10) C/II
 SHEET 71 OF 459 SHEETS