

Δ 10° 15' RT  
 D 0° 30'  
 R 11459.16  
 T 1027.74  
 L 2050.00  
 E 46.00  
 DO NOT BANK  
 FOR WB & EB CURVES

SETTLEMENT PLATFORM, TYPE II  
 BL 966+00  
 BL 972+00

MUCK EXCAVATION  
 EB 956+00 ~ 972+00  
 WB 956+00 ~ 972+00

BLASTED ROCK FILL  
 EB 956+00 ~ 972+00  
 WB 956+00 ~ 972+00


WOVEN WIRE FENCE  
 EB 956+00 RT ~ 972+00 RT  
 WB 956+00 LT ~ 971+47 LT

BM 35 RB  
 SI POLE 78 A  
 220' LT WB 962+48  
 ELEV. 538.41

BM 35 R  
 SIT 12' POP  
 U.S. ELEV.  
 532.920

WB. PI. 958+41.86 =  
 958+36.38  
 BL. PI. 959+27.74 =  
 959+22.26  
 EB. PI. 959+23.70 =  
 959+18.22

B.M. 34 R  
 SIT 18' BLCH.  
 U.S. ELEV.  
 527.729

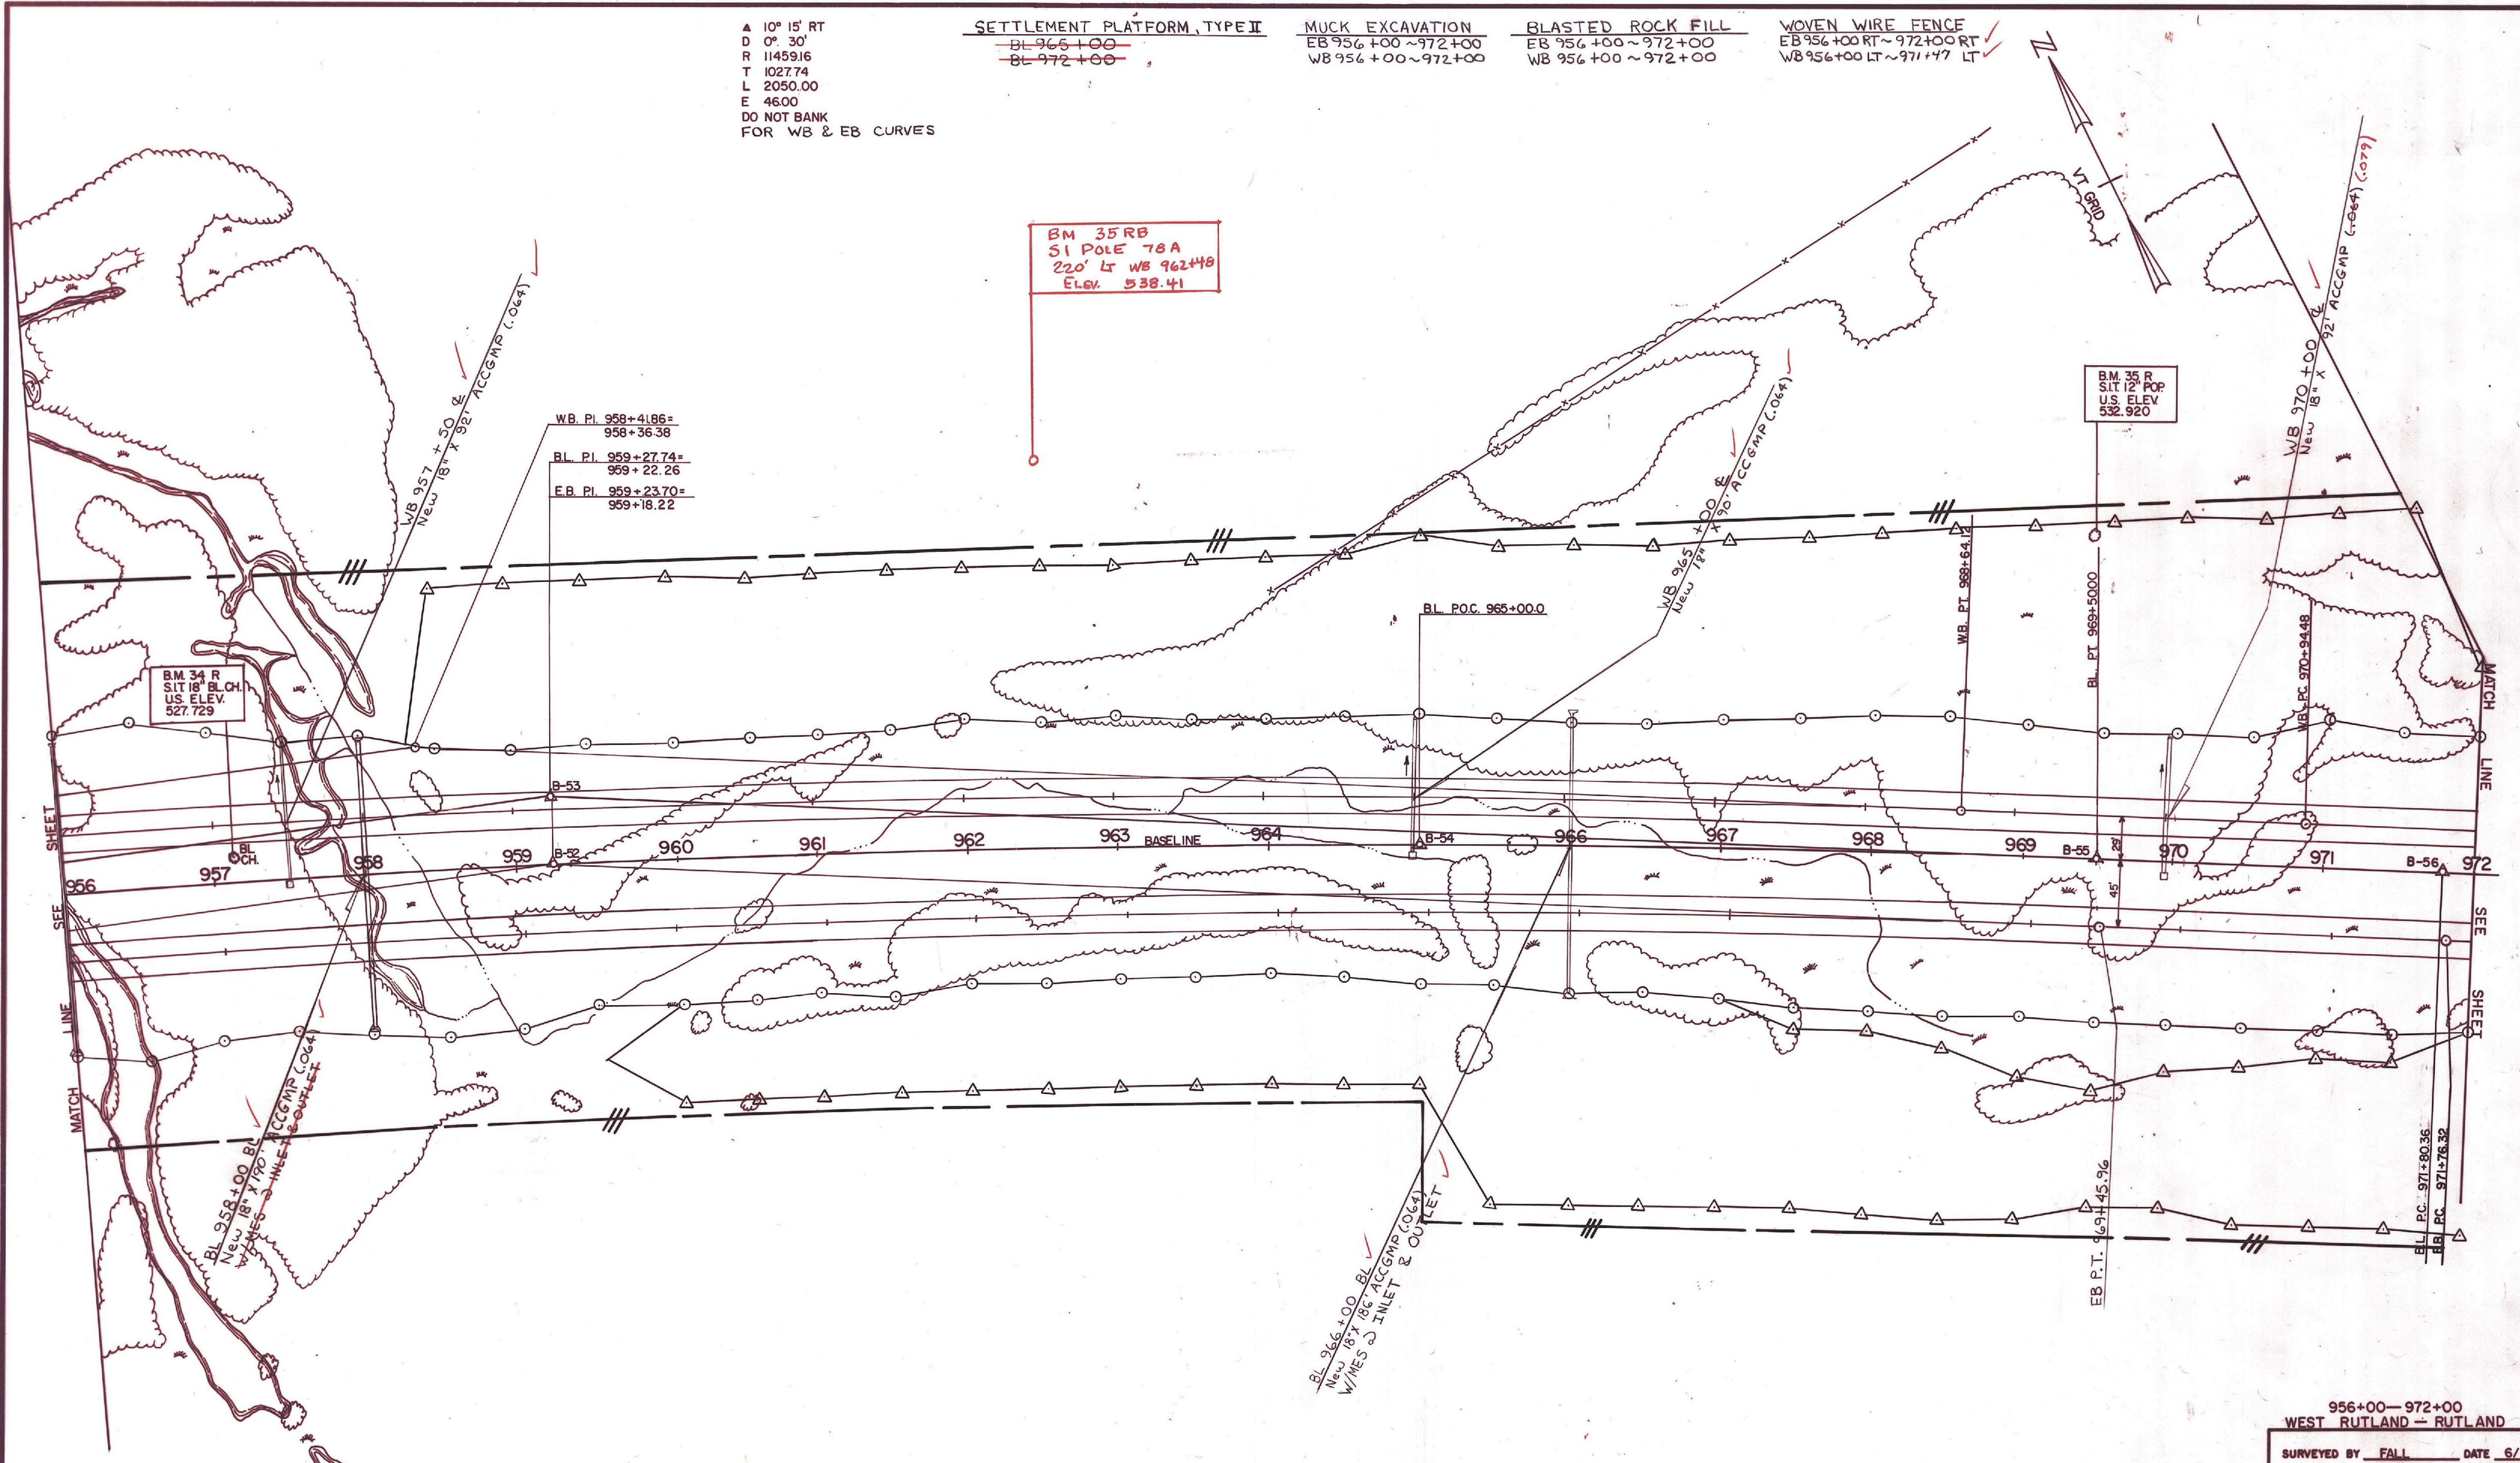

DATUM  
 VERTICAL \_\_\_\_\_  
 HORIZONTAL \_\_\_\_\_

0 50 100  
 SCALE IN FEET

956+00—972+00  
 WEST RUTLAND — RUTLAND  
 SURVEYED BY FALL DATE 6/75  
 DRAWN BY DZG DATE 7/75  
 TRACED BY RJM DATE 10/83  
 STAGE I CONSTRUCTION  
 PROJ. F-EGC-FNO. 020-1 (10)  
 SHEET 72 OF 459