


DATE _____
 BY _____
 SURVEYED _____
 PLOTTED _____
 ALIGNMENT CHECKED _____
 RT. OF WAY CHECKED _____
 PLAN
 NOTE BOOK NO. _____



DATE _____
 BY _____
 SURVEYED _____
 GRADES CHECKED _____
 STRUCTURE NOTATIONS CHK'D _____
 PROFILE
 NOTE BOOK NO. _____

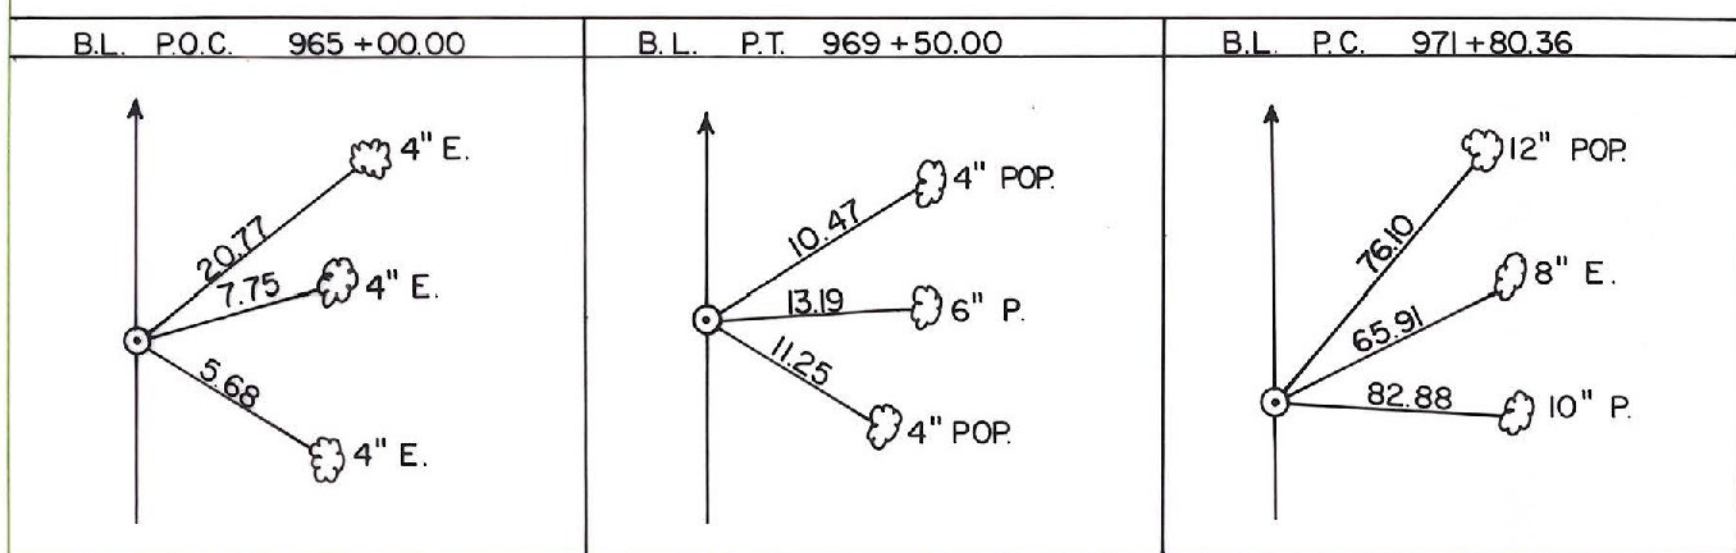