


PLAN
 SURVEYED...
 ALIGNMENT CHECKED...
 RT. OF WAY CHECKED...
 NO. ...

PROFILE
 SURVEYED...
 GRADES CHECKED...
 STRUCTURE, RETAINING CURBS...
 NO. ...

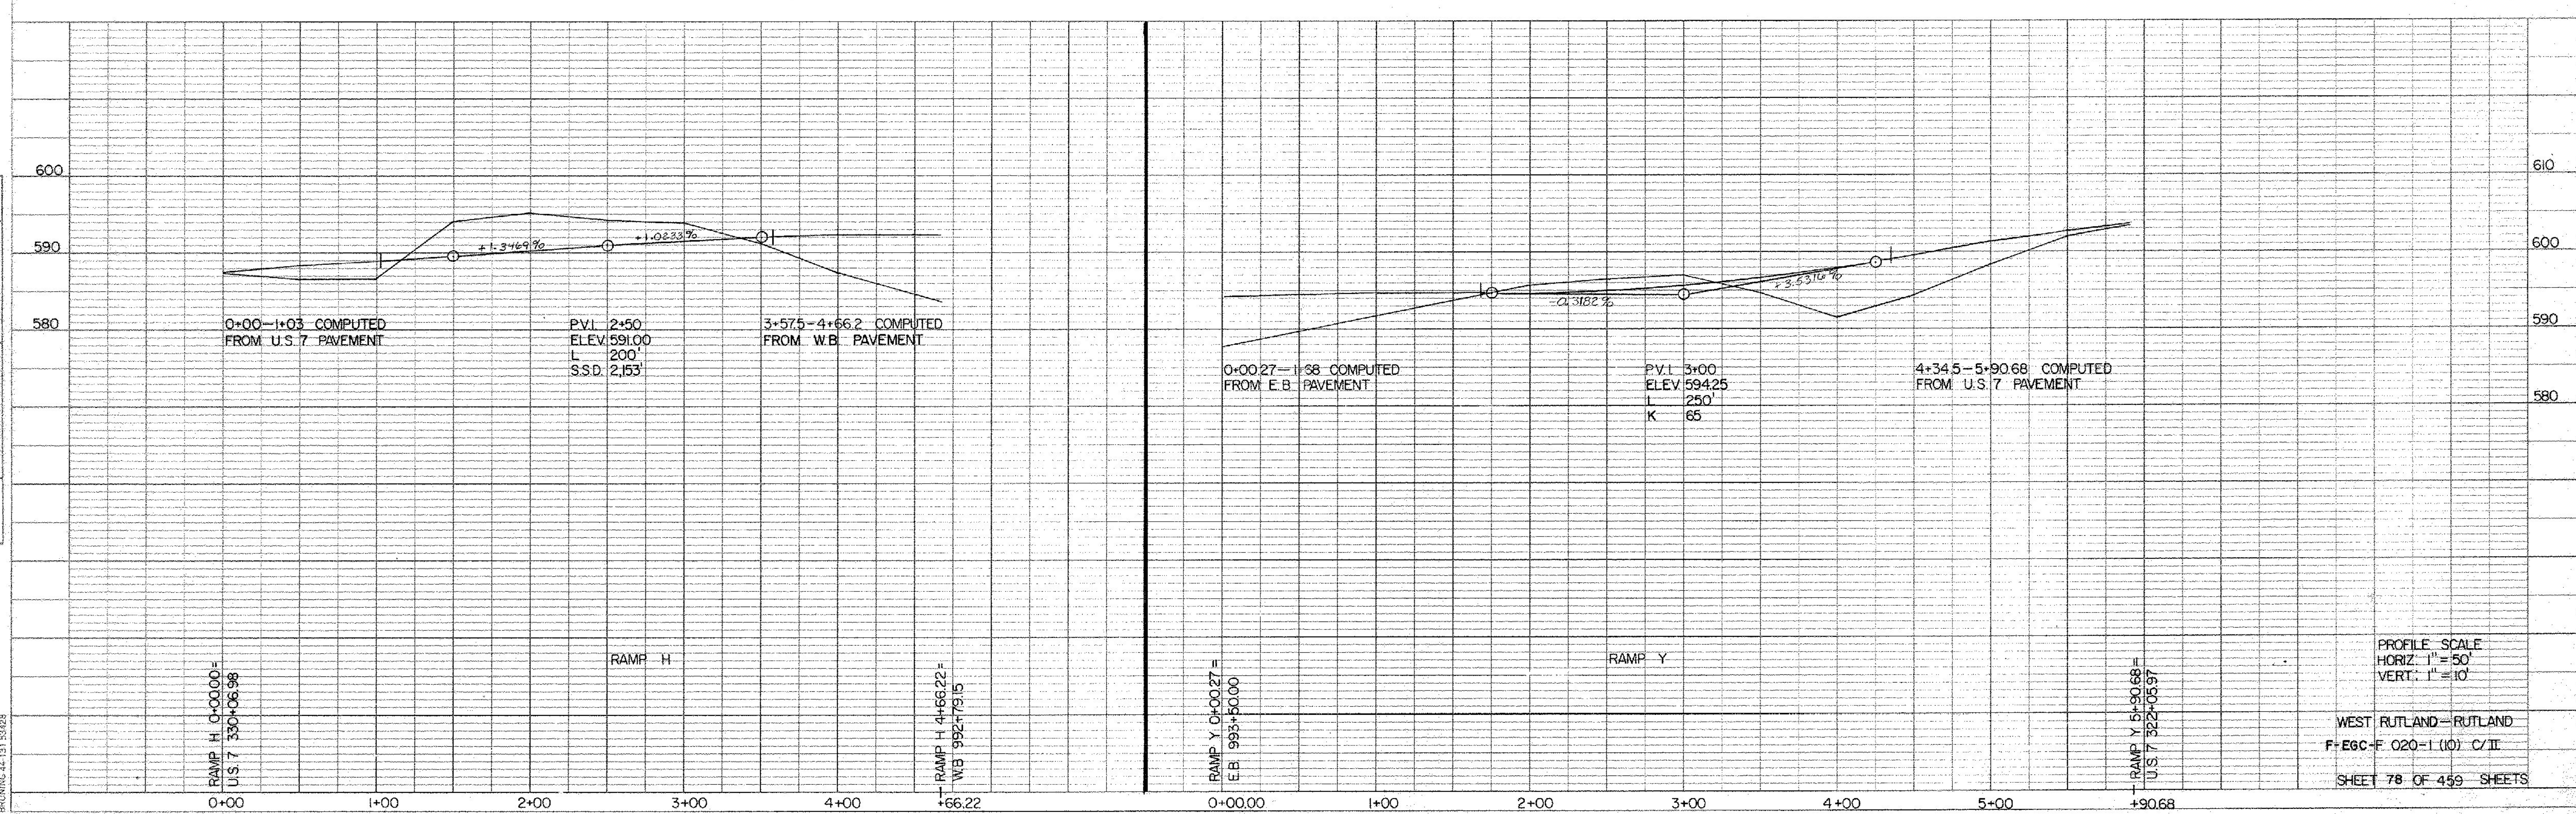

BRUNING 44-131 53428

PLATE 1 SINGLE PLAN - PROFILE
 CHARLES BRUNING CO.
 MADE IN U.S.A.

PROFILE SCALE
 HORIZ: 1" = 50'
 VERT: 1" = 10'
 WEST RUTLAND - RUTLAND
 F-EGC-F 020-1 (10) C/II
 SHEET 78 OF 459 SHEETS