


PLAN
SCALE: 1" = 10'-0"

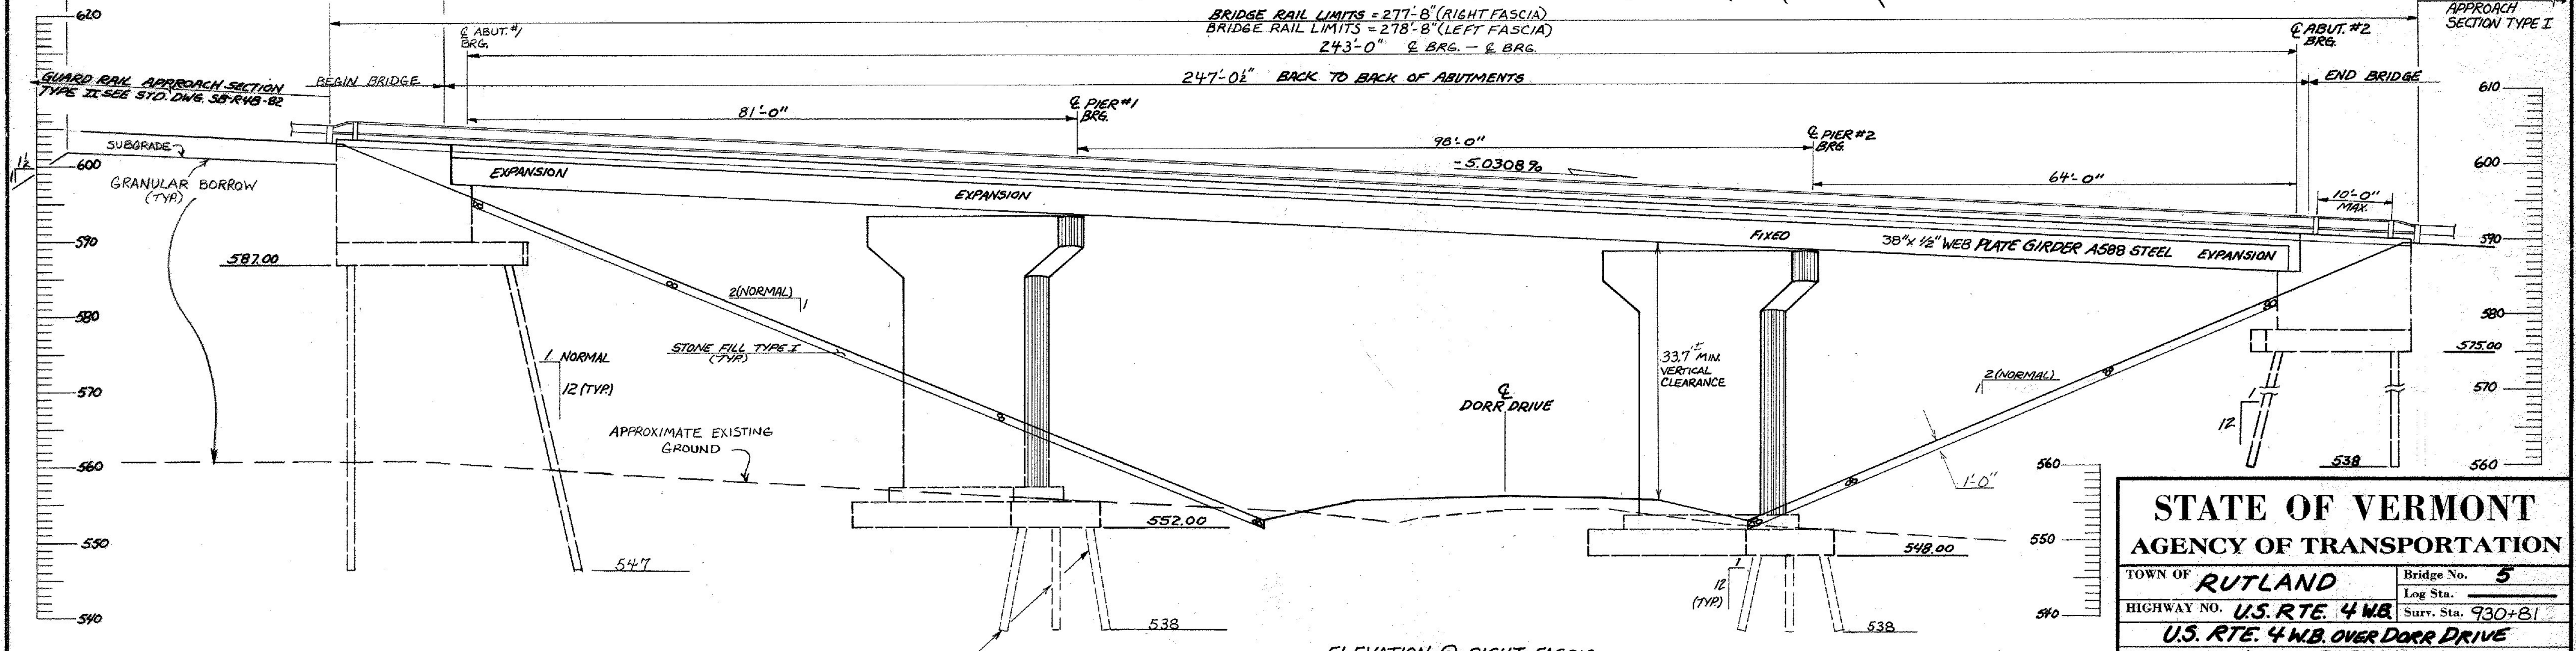

ELEVATION @ RIGHT FASCIA
SCALE: 1" = 10'-0"

STATE OF VERMONT	
AGENCY OF TRANSPORTATION	
TOWN OF RUTLAND	Bridge No. 5
HIGHWAY NO. U.S. RTE. 4 W.B.	Log Sta. _____
U.S. RTE. 4 W.B. OVER DORR DRIVE	
PLAN AND ELEVATION	
Designed by J.B. MCCARTHY	Drawn by L.C. GATES
Checked by J.B. MCCARTHY date 3/83	Bridge Design Supervisor F.W. BOLKUM date 4/83
PROJECT WEST RUTLAND-RUTLAND	PROJECT NO. F-EGG-F-020-100
Bridge Sheet No. BR 504	Sheet 94 of 459

NOTE: FOR LENGTH OF PILES UNDER ABUTTS, SEE SHEET BR-518. FOR LENGTH OF PILES UNDER PIERS SEE SHEETS BR-519 & BR-520.

BR-6