


PLAN
SCALE: 1" = 10'-0"

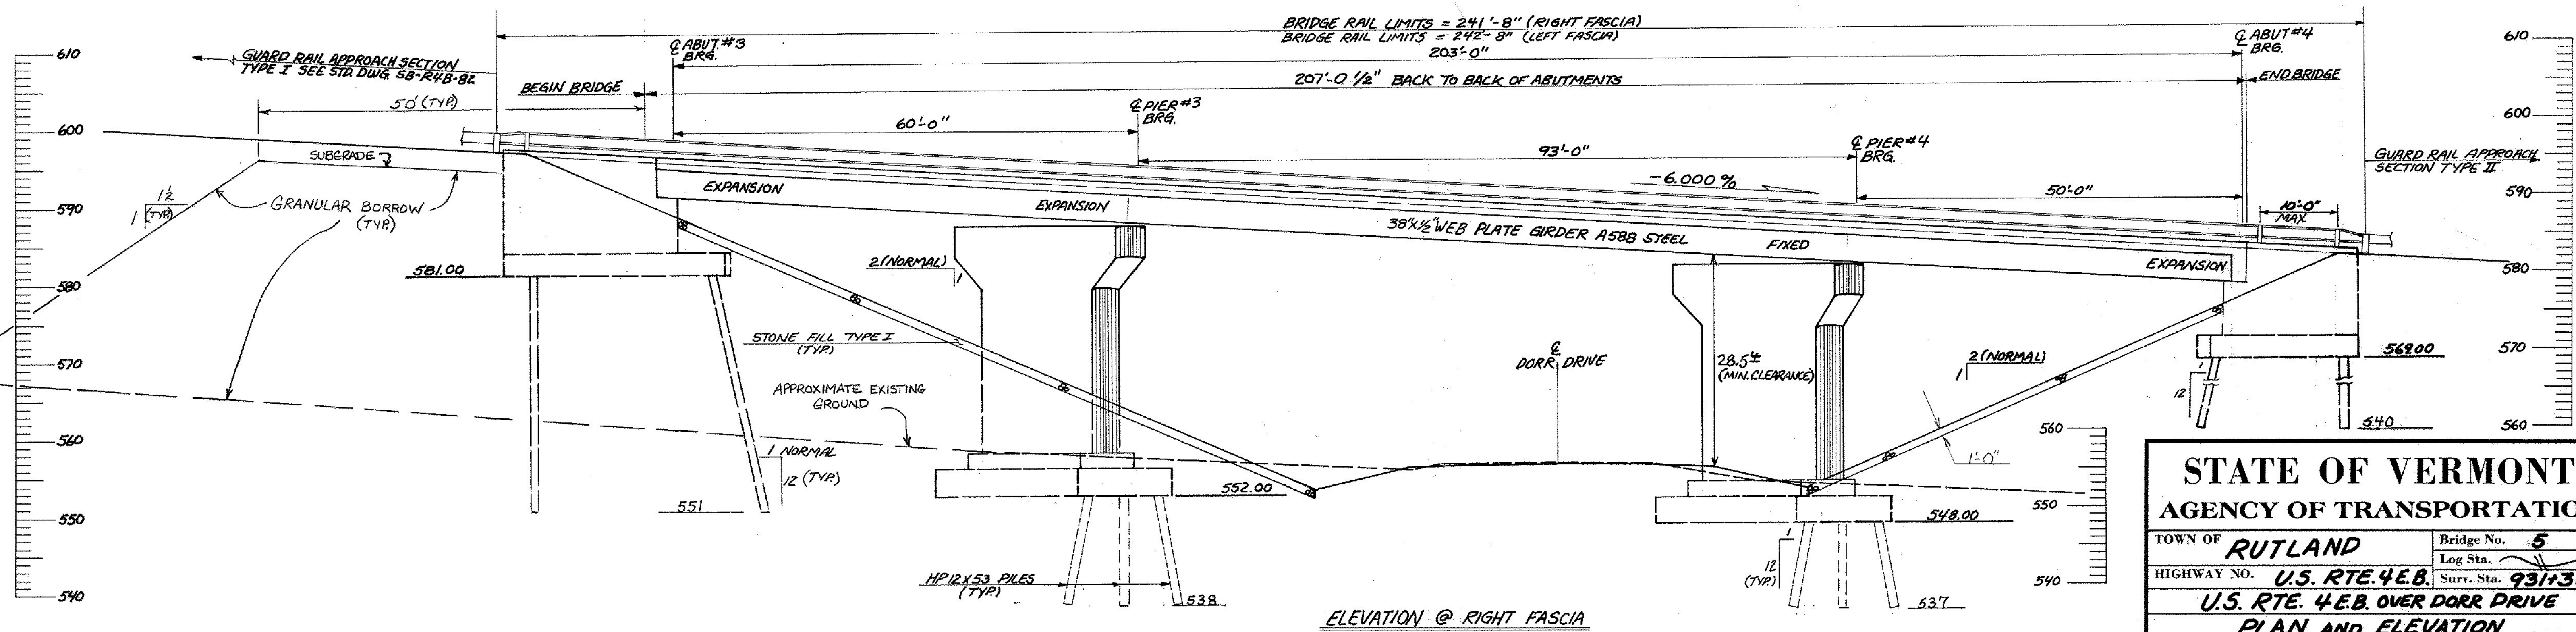

ELEVATION @ RIGHT FASCIA
SCALE: 1" = 10'-0"

NOTE: FOR LENGTH OF PILES UNDER ABUTS, SEE SHEET BR-57B.
FOR LENGTH OF PILES UNDER PIERS SHEETS BR-57A & BR-52D.

STATE OF VERMONT	
AGENCY OF TRANSPORTATION	
TOWN OF RUTLAND	Bridge No. 5
HIGHWAY NO. U.S. RTE. 4 E.B.	Log Sta. 931+35
U.S. RTE. 4 E.B. OVER DORR DRIVE	
PLAN AND ELEVATION	
Designed by J.B. MCCARTHY	Drawn by L.C. GATES
Checked by J.B. MCCARTHY date 3/83	Bridge Design Supervisor F.W. BOLKUM date 4/83
PROJECT WEST RUTLAND - RUTLAND	PROJECT NO. F-EGC-F-020-1(10)
Bridge Sheet No. BR 505	Sheet 95 of 459