
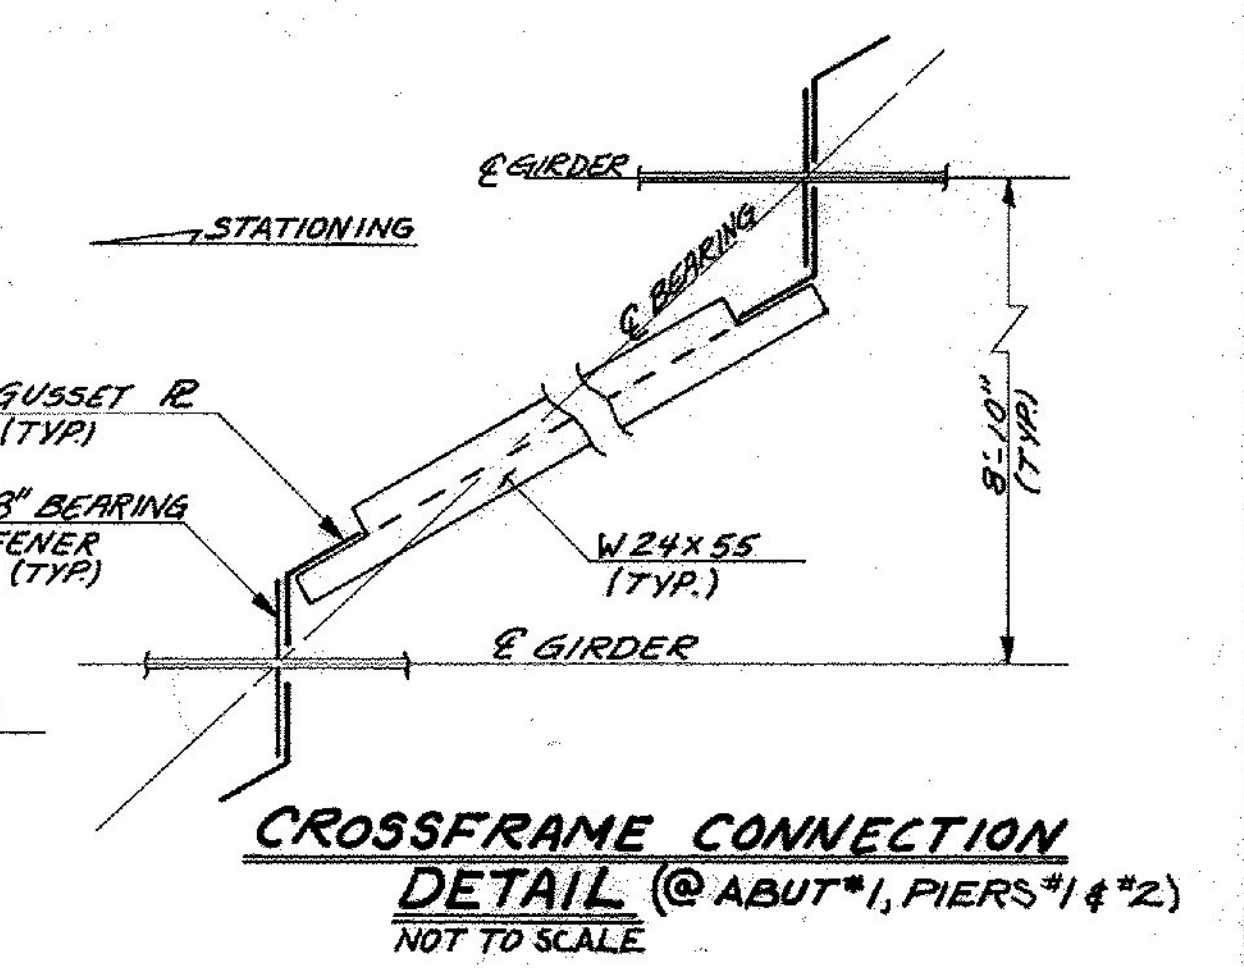
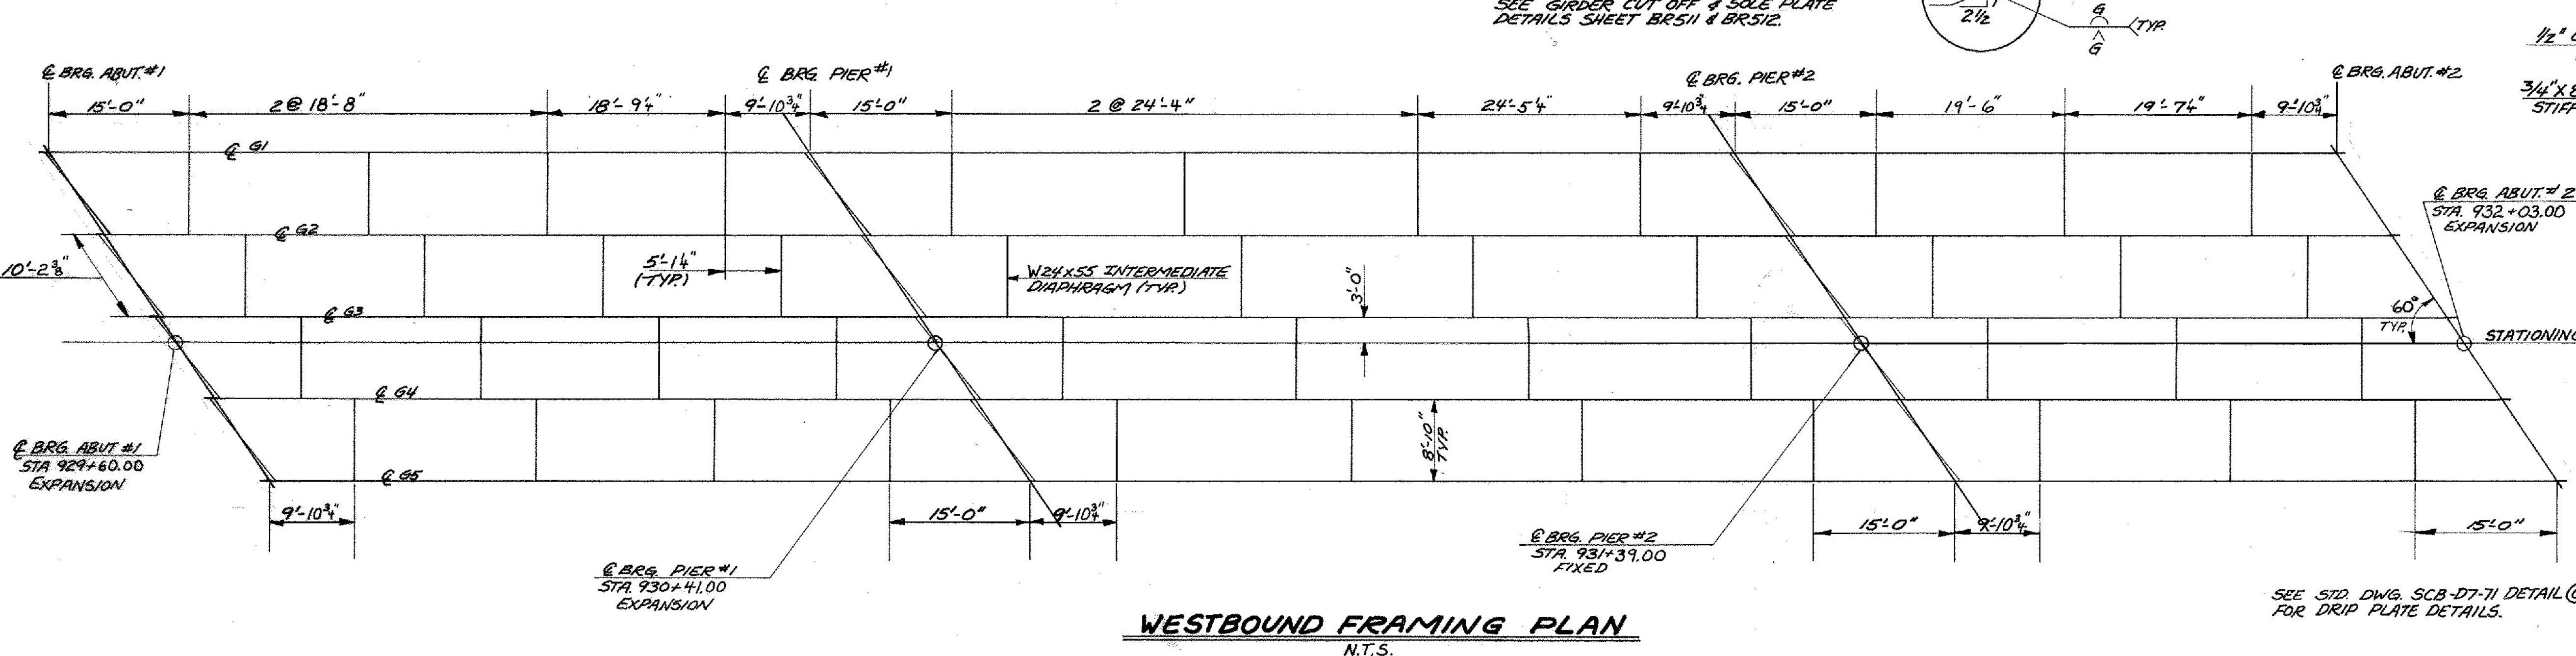


- NOTES**
1. CUT THE ENDS OF THE GIRDERS TO BE VERTICAL IN THE ERECTED POSITION.
 2. CAMBER TOLERANCE AT ANY POINT SHALL NOT EXCEED (-0) OR 1/8" (DISTANCE TO NEAREST SUPPORT) / 70

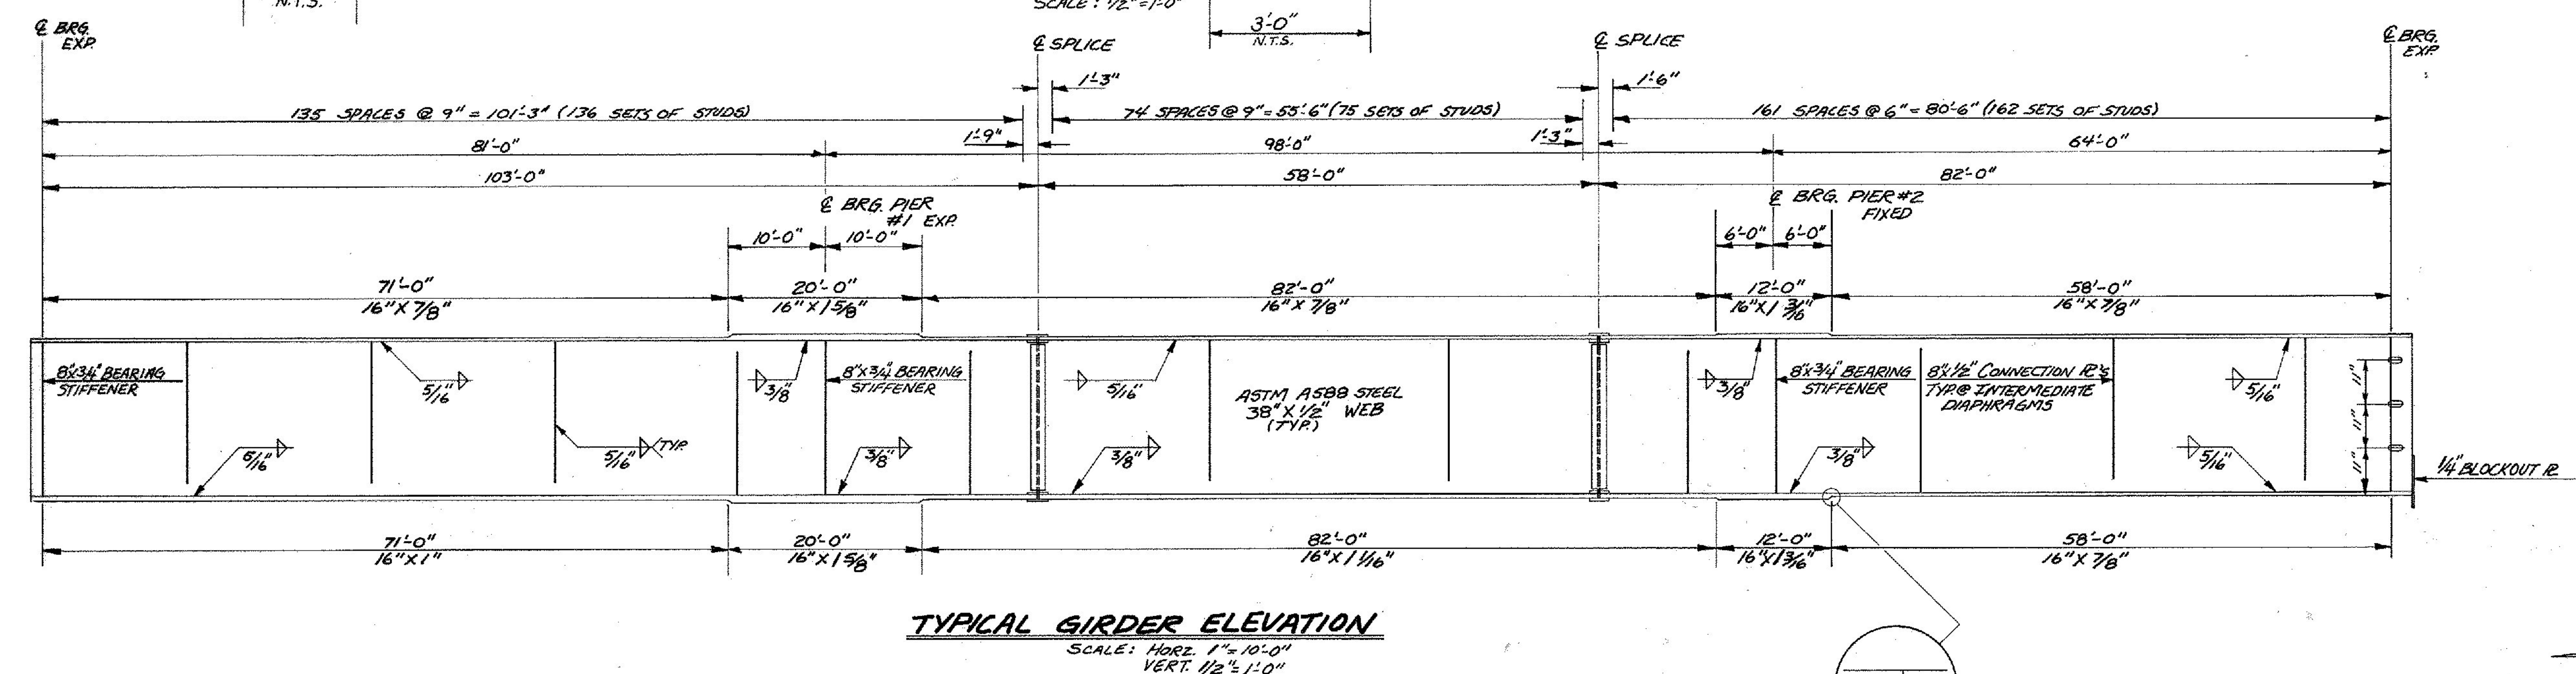

STATE OF VERMONT	
AGENCY OF TRANSPORTATION	
TOWN OF RUTLAND	Bridge No. 5
HIGHWAY NO. U.S. RTE. 4 W.B.	Log Sta. _____
	Surv. Sta. 930+81
U.S. RTE. 4 W.B. OVER DORR DRIVE	
SUPERSTRUCTURE DETAILS	
Designed by J.B. MCCARTHY	Drawn by L.C. GATES
Checked by G.S. ROGERS	Bridge Design Supervisor
date 8/2/83	F.W. Balkum date 12/83
PROJECT WEST RUTLAND-RUTLAND	PROJECT NO. F-EGG-F-020-11(10)
Bridge Sheet No. BR 506	Sheet 96 of 459

BR-6