


TYPICAL BRIDGE SECTION
SCALE: 1/2" = 1'-0"

STA. 956+50
FG. EL. 533.50
1400' V.C.
WB - 1.1754% +0.8889%
EB - 1.1754% +0.8519%
N.T.S.

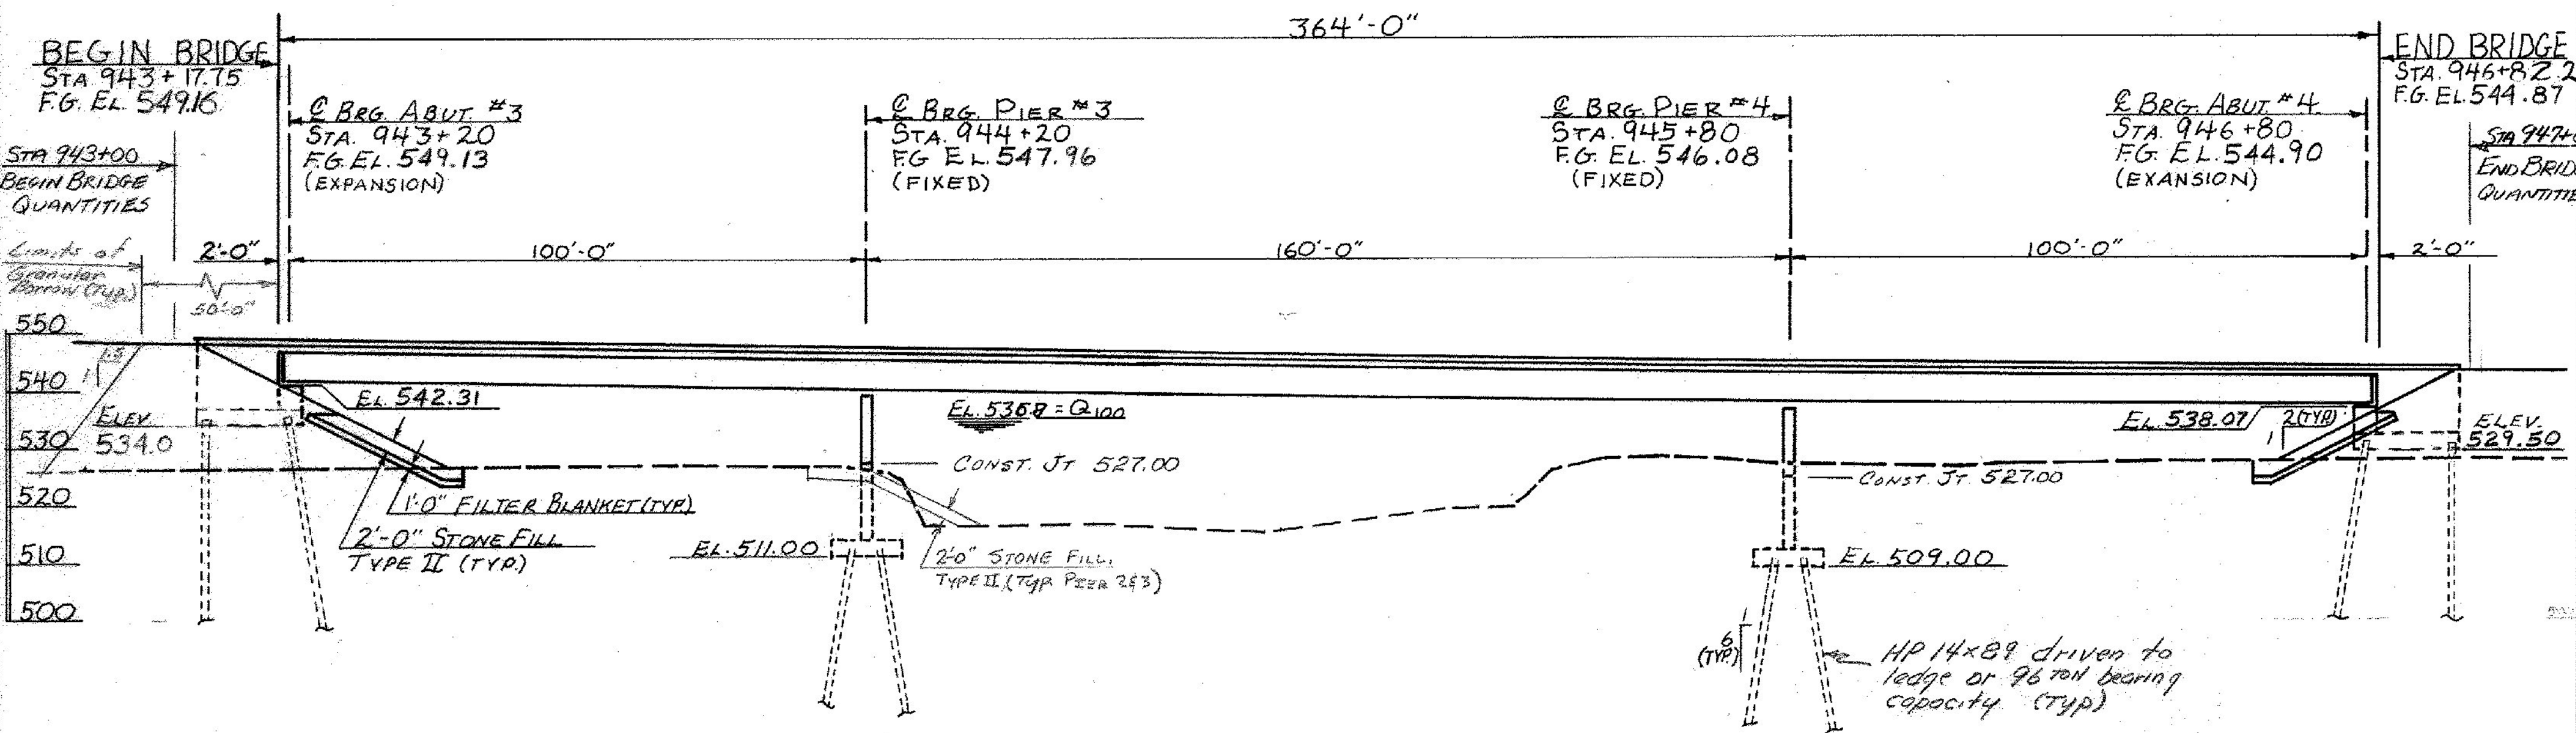

EASTBOUND ELEVATION ALONG RIGHT FASCIA
SCALE: 1" = 20'-0"

EXISTING STRUCTURE	
1. STRUCTURE TYPE	OVERALL LENGTH
2. SPAN LENGTH(S) CENTER TO CENTER OF BEARINGS	INVENTORY RATING
3. CLEAR SPAN LENGTH(S) NORMAL TO STREAM	
4. WATERWAY AREA OF FULL OPENING NORMAL TO STREAM	VERTICAL CLEARANCE ABOVE STREAMBED
5. WATER SURFACE ELEVATION @ 2.33	WATER SURFACE ELEVATION @
6. WATER SURFACE ELEVATION AT FLOOD OF RECORD	YEAR ESTIMATED DISCHARGE
7. DOES ALL WATER PASS THROUGH EXISTING STRUCTURE? IF NOT, AT WHAT FREQUENCY AND ELEVATION DOES RELIEF OCCUR?	
8. TYPE OF SUBSTRUCTURE FOUNDATION MATERIAL	
9. DISPOSITION OF STRUCTURE	

NEW STRUCTURE	
1. STRUCTURE TYPE	OVERALL LENGTH
2. SPAN LENGTH(S) CENTER TO CENTER OF BEARINGS	
3. VERTICAL CLEARANCE ABOVE STREAMBED OR ROAD UNDER	
4. CLEAR SPAN LENGTH(S) NORMAL TO STREAM	
5. WATERWAY AREA OF FULL OPENING (NORMAL TO STREAM)	
6. ARE PROVISIONS TO BE MADE FOR PUBLIC UTILITIES?	

STRUCTURE GEOMETRY:

1. STRUCTURE TYPE 3 SPAN CONTINUOUS COMPOSITE PLATE GIRDER (A588) OVERALL LENGTH 364'-0"

2. SPAN LENGTH(S) CENTER TO CENTER OF BEARINGS 100'-0" ; 160'-0" ; 100'-0"

3. VERTICAL CLEARANCE ABOVE STREAMBED OR ROAD UNDER

4. CLEAR SPAN LENGTH(S) NORMAL TO STREAM 98'-0" ; 158'-0" ; 98'-0"

5. WATERWAY AREA OF FULL OPENING (NORMAL TO STREAM) 5200 SF. (520 S.M.)

6. ARE PROVISIONS TO BE MADE FOR PUBLIC UTILITIES? No

HYDRAULIC DATA:

Q 2.33	6,000 cfs	WATER ELEVATION	529.1	VELOCITY	2.6 FPS
Q 10	11,000 cfs	WATER ELEVATION	531.9	VELOCITY	3.5 FPS
Q 25	14,500 cfs	WATER ELEVATION	533.5	VELOCITY	4.0 FPS
Q 50	17,000 cfs	WATER ELEVATION	534.6	VELOCITY	4.3 FPS
Q 100	22,000 cfs	WATER ELEVATION	536.8	VELOCITY	4.7 FPS

2. DRAINAGE AREA 242 SQ. MI. CHARACTER OF TERRAIN ROLLING TO MOUNTAINOUS

3. ARE THERE OBJECTIONS TO A PIER IN THE STREAM? No

4. DOES STREAM REACH ITS MAXIMUM HIGH WATER ELEVATION RAPIDLY? No IS ORDINARY RISE RAPID? No

5. NATURE OF NATURAL STREAMBED SAND AND SILT

6. ESTIMATED SCOUR DEPTH 2'-6" COMMENT ON: DRIFT SLIGHT ICE MODERATE

7. WILL ALL WATER PASS THROUGH NEW STRUCTURE? YES IF NOT, WHAT FREQUENCY AND ELEVATION WILL RELIEF OCCUR? N.A.

8. VERTICAL CLEARANCE ABOVE ROAD 5'-0" @ ABUT. # 4

9. ALLOWABLE WATER SURFACE ELEVATION 538.0 LIMITED BY LOW BEAM @ ABUT. # 4

10. IS DESIGN STAGE AFFECTED BY UPSTREAM OR DOWNSTREAM CONDITIONS? No IF YES, DESCRIBE

11. AVERAGE DAILY LOW FLOW 200 CFS DEPTH 5' AVERAGE DAILY HIGH FLOW 650 CFS DEPTH 8'

12. STREAMBANK OR CHANNEL PROTECTION REQUIRED YES - STONE FILL TYPE II W/ GRAVEL FILTER BLANKET

13. DISTANCE TO EXISTING UPSTREAM STRUCTURE 1000' SPAN 20'-59" WATERWAY AREA OF FULL OPENING 0

14. DISTANCE TO EXISTING DOWNSTREAM STRUCTURE 4,000' SPAN 127'-80" WATERWAY AREA OF FULL OPENING 0

ALLOWABLE STRESSES:

1. DESIGN LIVE LOAD AASHTO H.S. 25

2. ALLOWABLE LOAD FOR SPREAD FOOTINGS ON SOIL NA ON LEDGE PILES TO LEDGE

3. ALLOWABLE LOAD FOR PILING 19.2 KIPS TYPE HP 14x89 ESTIMATED LENGTH SEE TABLE BELOW

4. ALLOWABLE STRESS FOR STRUCTURAL STEEL ASTM A 588 TENSION 27,000 P.S.I.

5. ALLOWABLE STRESS FOR REINFORCING STEEL GRADE 60 TENSION 24,000 P.S.I. COMPRESSION 20,000 P.S.I.

6. ALLOWABLE STRESS FOR CONCRETE CLASS A 3,500 P.S.I. CLASS B 3,500 P.S.I. CLASS C 1,400 P.S.I.

ESTIMATED PILE LENGTHS

WEST BOUND		EAST BOUND	
ABUTMENT # 1	110'	ABUTMENT # 3	100'
PIER # 1	100'	PIER # 3	90'
PIER # 2	140'	PIER # 4	140'
ABUTMENT # 2	160'	ABUTMENT # 4	160'

ADDITIONAL DESIGN CONSIDERATIONS

INDEX OF SHEETS

- BR 600 PRELIMINARY INFORMATION
- BR 601 BRIDGE QUANTITY SHEET
- BR 602 PLAN
- BR 603 BORING LOGS
- BR 604 BORING LOGS
- BR 605 BORING LOGS
- BR 606 BORING LOGS
- BR 607 FRAMING PLAN AND GIRDER ELEVATION
- BR 608 CAMBER DIAGRAM & GENERAL NOTES
- BR 609 CROSSFRAME & SCUPPER DETAILS
- BR 610 GIRDER SPLICE & APPROACH SLAB DETAILS
- BR 611 DECK REINFORCING, CURB & RAILING DETAILS
- BR 612 EXPANSION DAM DETAILS - I
- BR 613 EXPANSION DAM DETAILS - II
- BR 614 BEARING DEVICES
- BR 615 ABUTMENT # 1 & # 4 DETAILS
- BR 616 ABUTMENT # 2 & # 3 DETAILS
- BR 617 WINGWALL DETAILS
- BR 618 PIER DETAILS
- BR 619 REINFORCING STEEL SCHEDULE
- BR 620 REINFORCING STEEL SCHEDULE
- BR 621 CHANNEL X-SECTIONS

LANE LOAD CONTROLS 46 TONS INVENT.

STRESS LEVELS	LOAD RATING (TONS)						
	H	HS	3S2	6 AXLE	3A. STR.	4A. STR.	5A. SEMI
INVENTORY	50	55					
0.55 Fy - POSTED	75	82	91		77	79	87
0.67 Fy - OPERATING			110	121			

STATE OF VERMONT
AGENCY OF TRANSPORTATION

TOWN OF RUTLAND Bridge No. 6
Log Sta. 945+00

HIGHWAY NO. U.S. 4 Surv. Sta. 945+00

RECOMMENDED FOR APPROVAL Warren B. Jones 4/25/83 STRUCTURES ENGINEER DATE

RECOMMENDED FOR APPROVAL R. Egan 4/27/83 CHIEF OF DESIGN DATE

APPROVED BY Arthur J. Good 4/27/83 DIRECTOR OF ENGINEERING & CONSTRUCTION DATE

PRELIMINARY INFORMATION

U.S. 4 OVER OTTER CREEK

Designed by G.V. SULLAK Drawn by S. BASCOM

Checked by RP GENDRON date 2-25-83 Bridge Design Supervisor R.S. HAUPT date

PROJECT WEST RUTLAND-RUTLAND PROJECT NO. F020-1(10)

Bridge Sheet No. BR600 Sheet 118 of 459