



GIRDER SPLICE ELEVATION
SCALE 1" = 1'-0"

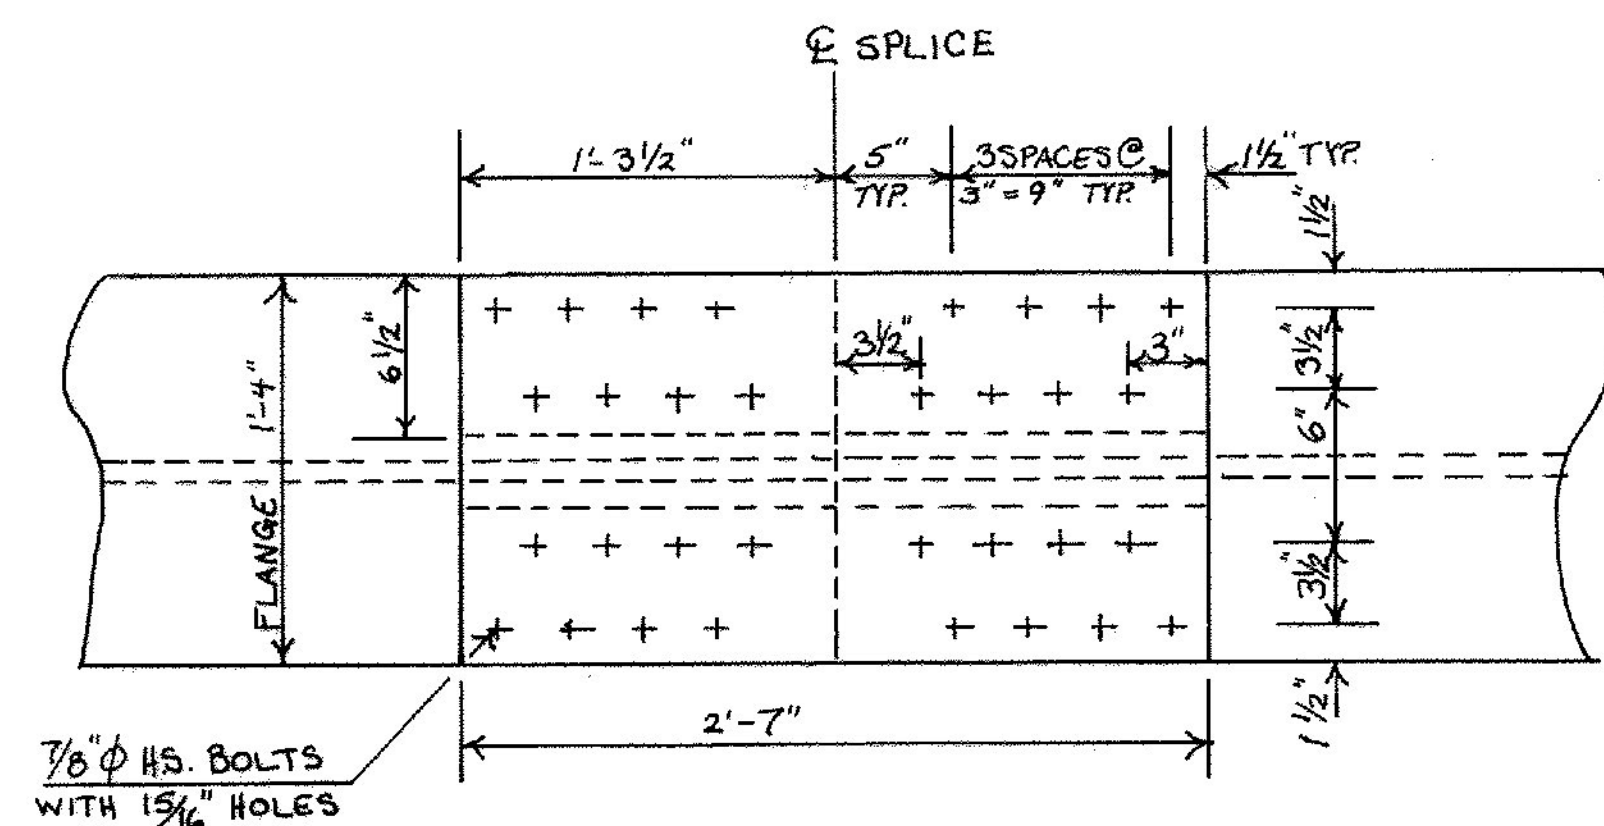


GIRDER FLANGE SPLICE - PLAN
SCALE 1 1/2" = 1'-0"

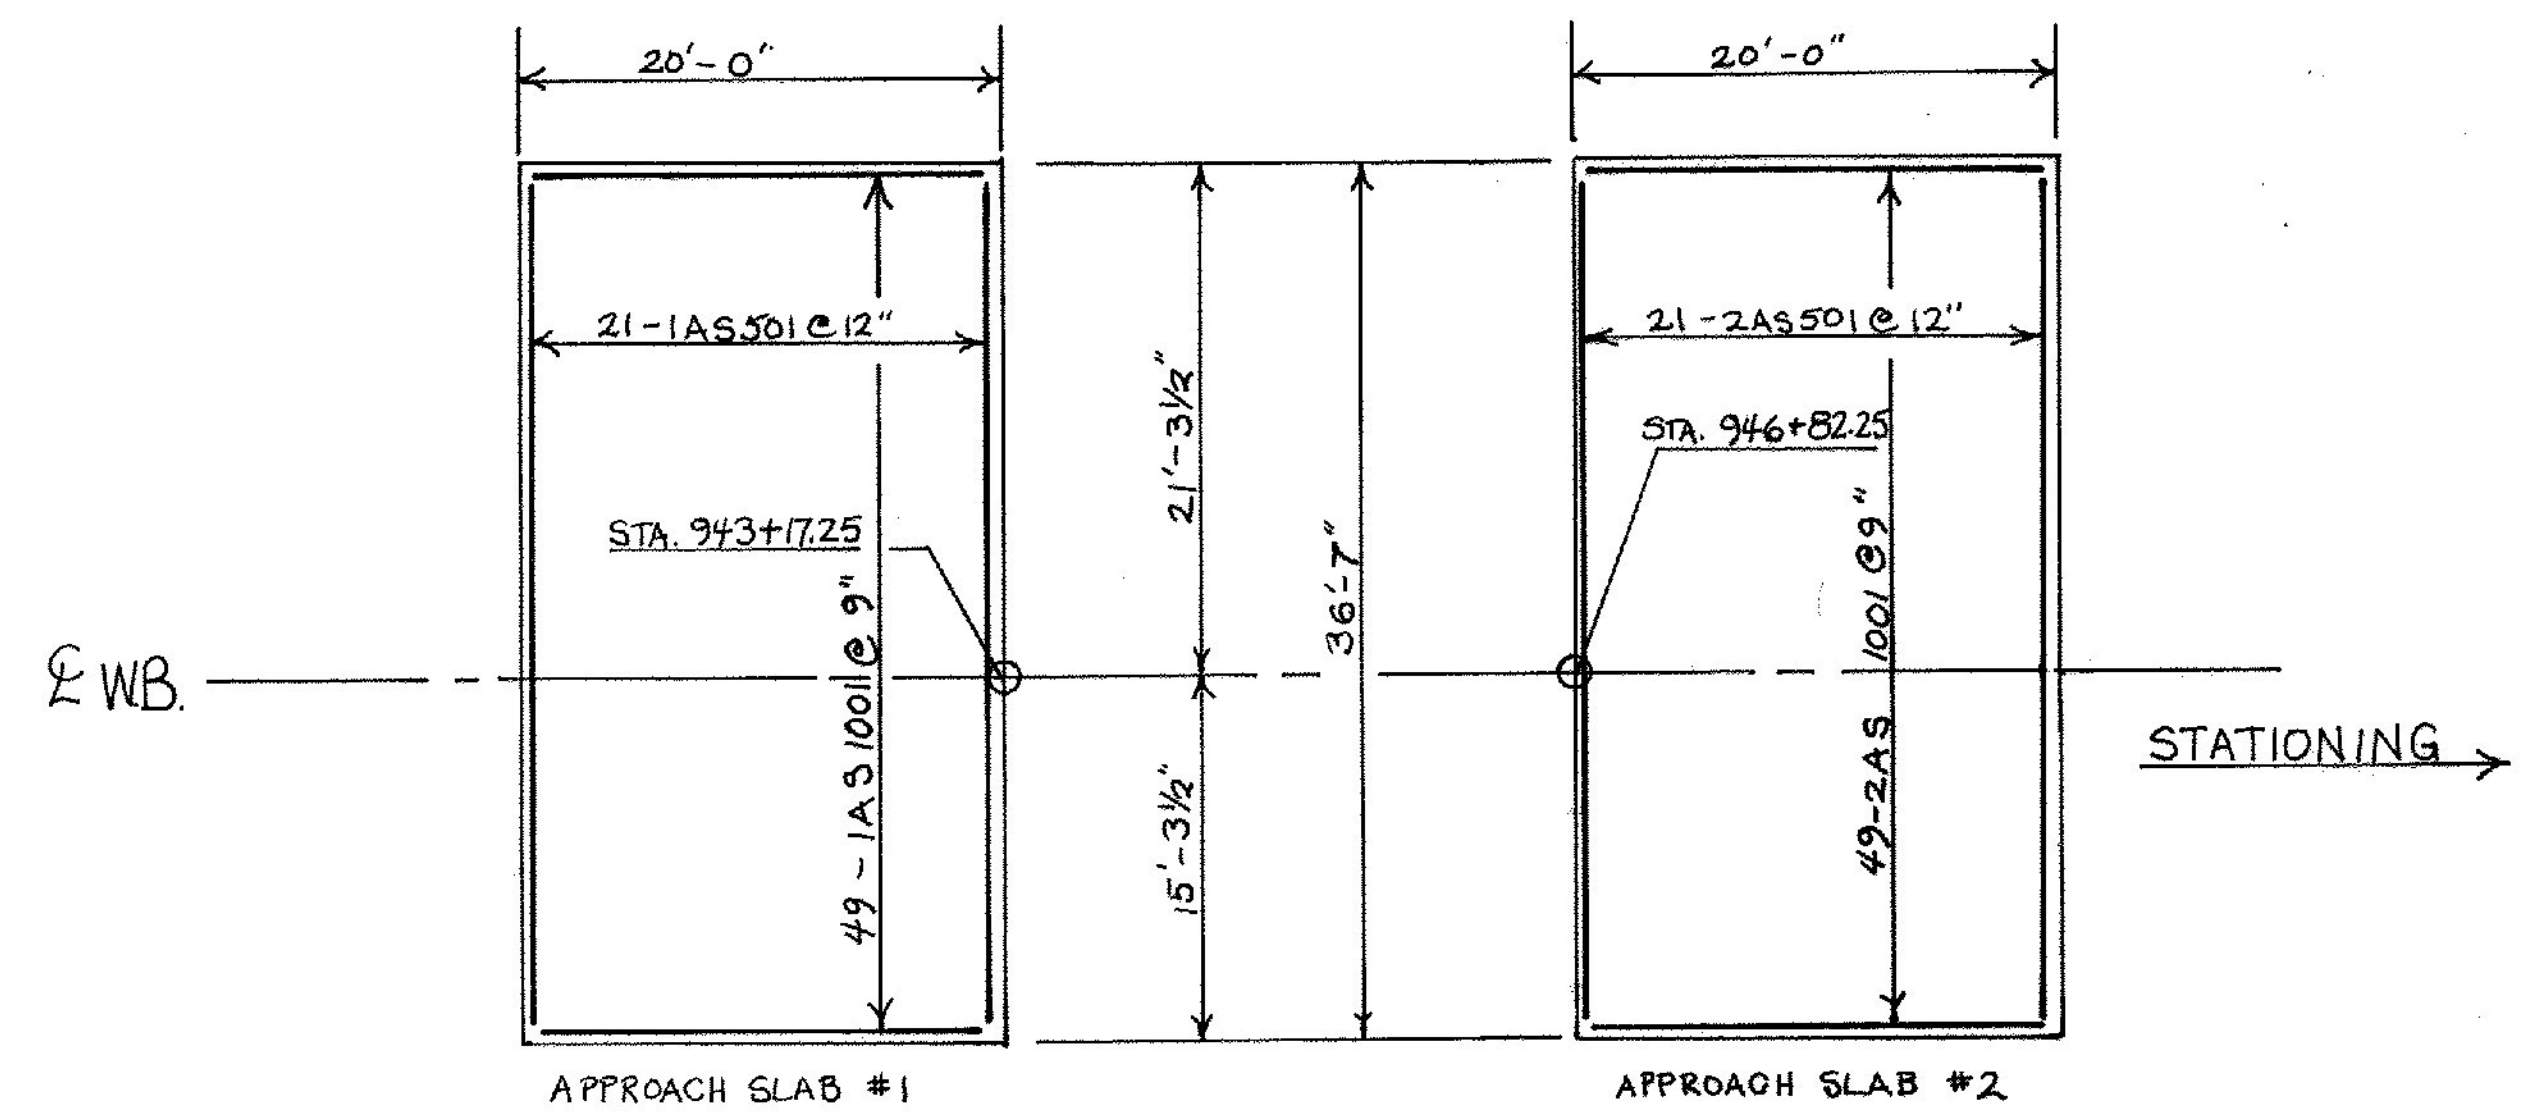

APPROACH SLAB LAYOUT *

SCALE 1/8" = 1'-0"

* APPROACH SLABS E.B. SAME EXCEPT OPPOSITE HAND AND BAR PREFIX 3AS & 4AS

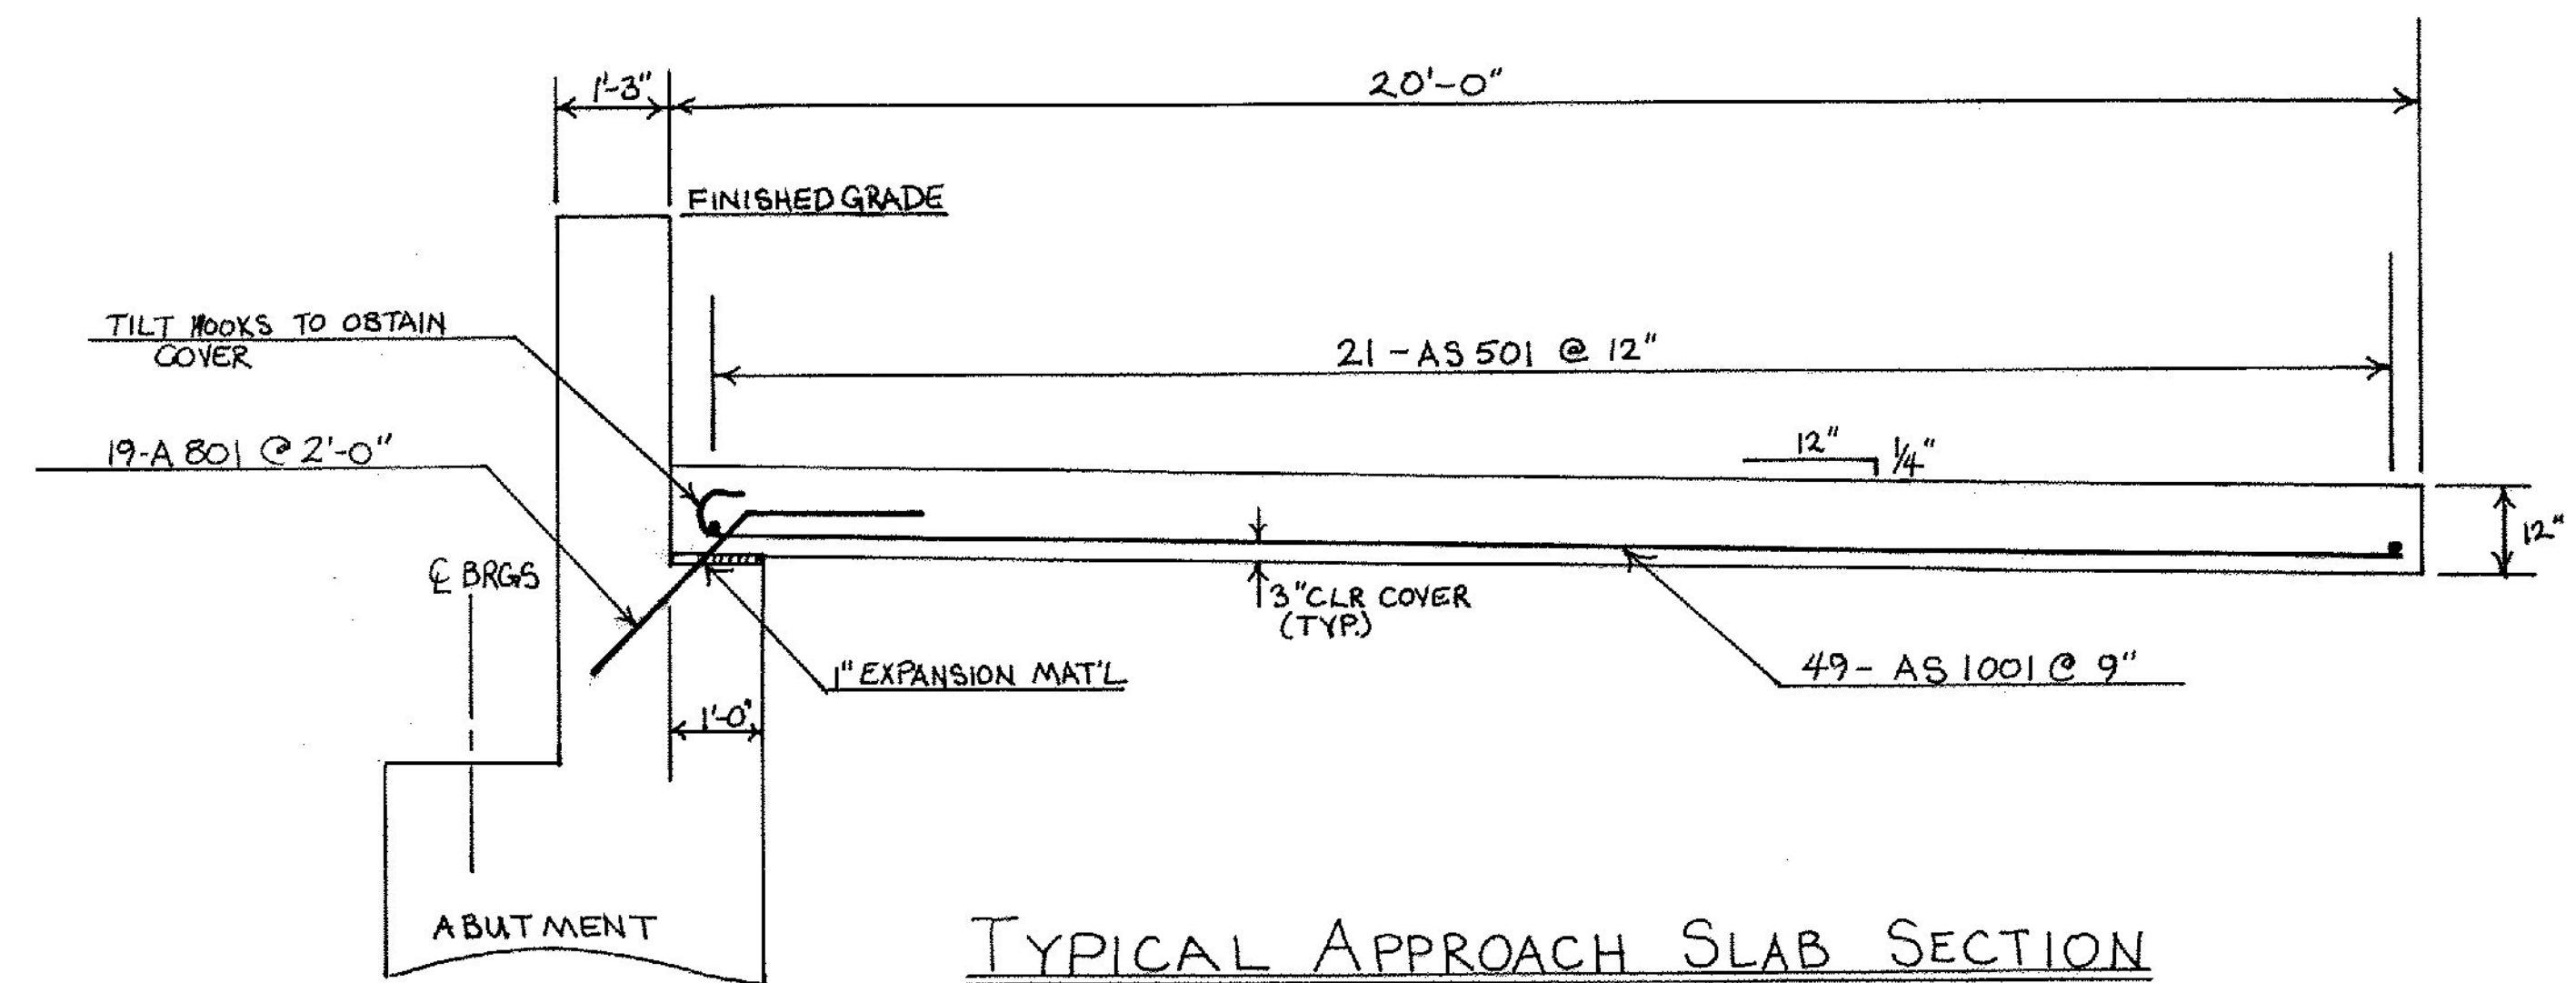

TYPICAL APPROACH SLAB SECTION

SCALE 1/2" = 1'-0"

STATE OF VERMONT
AGENCY OF TRANSPORTATION

TOWN OF RUTLAND	Bridge No. 6
HIGHWAY NO. US 4	Log Sta.
	Surv. Sta. 945+00
GIRDER SPLICE & APPROACH SLAB DETAILS	
U.S. 4 BR 6 OVER OTTER CREEK	
Designed by R.P. GENDRON	Drawn by S. JUNG
Checked by A. Elwood date 8-83	Bridge Design Supervisor R.S. HAUPT date
PROJECT WEST RUTLAND - RUTLAND	PROJECT NO. FO20-1(10)
Bridge Sheet No. BR 610	Sheet 128 of 459