
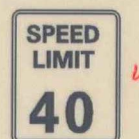

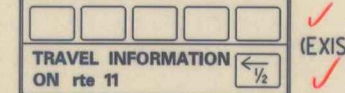
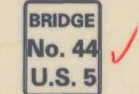
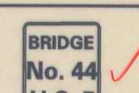
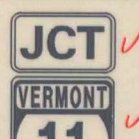
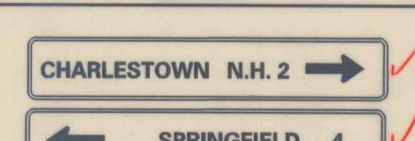





TRAFFIC SIGN SUMMARY SHEET		TRAFFIC SIGN SUMMARY SHEET																				SIGN							
MILEMARKER, STATION OR SIGN NUMBER	SIGN LEGEND	SIGN DIMENSIONS	NEW AND SALVAGED SIGNS				EXISTING POSTS				NEW SIGN POSTS												REMARKS	PLAN SHEET NUMBER	STD. SHEET NUMBER				
			'A'	'B'	SALV. SIGN	SALV. T.I.S.	RET.	DRILL	REM.	SALV.	NUMBER OF POSTS	FLANGED CHANNEL LBS./FT.			TUBULAR ALUMINUM		TUBULAR STEEL			W SHAPED STEEL		ETG. SIZE				SIGN FRAME			
												1.12	2.0	3.0	3.0"φ	4.0"φ	FOUN- DATION	3"φ	3.5"φ	4.0"φ	5.0"φ	POST SIZE	WEIGHT	24"	30"				
U.S. RTE 5 35 104+00 LT		24' X 30'			1						14'																		
U.S. RTE 5 35 104+00 RT		24' X 30'			1						14'																		
U.S. RTE 5 109+30 RT		6' X 8'	0.33								10'		20														E-138		
U.S. RTE 5 109+70 RT	 (EXISTING)	72" X 16" 72" X 16"				8.0																							
U.S. RTE 5 113+25 RT		6' X 8'	0.33								12'		27														E-134		
U.S. RTE 5 116+70 LT		6' X 8'	0.33								11'		22														E-134		
U.S. RTE 5 116+70 RT		24' X 15" 24' X 24"	2.2								14'																		
U.S. RTE 5 118+60 RT	 	72" X 10" 72" X 10" 24' X 24" 24' X 15"	5.0		2						18' 18'		54 54														E-123		
U.S. RTE 5 119+86 LT		6' X 8'	0.33								10'		20														E-138		
U.S. RTE 5 120+25 LT		24' X 30'			1						14'																		
SHEET TOTAL			SF.	SF.	EA.	SF.					LBS	LBS	LBS	LBS	LBS	LBS	LBS	LBS	LBS	LBS	LBS	LBS	LBS	LBS	LBS	LBS			
ITEM TOTAL			14.72		5	16.00						36	86	280	276														

FINAL POST LENGTHS ARE TO BE DETERMINED IN THE FIELD. POST SIZES ARE COMPUTED BASED ON INFORMATION FURNISHED ON THE STANDARD SHEETS. HOWEVER, WHEN DEALING WITH W-SHAPE STEEL POSTS (STD. E-161), CONSULT THE TRAFFIC DESIGN SECTION, VAOT.

**STATE OF VERMONT
AGENCY OF TRANSPORTATION**

Town Of SPRINGFIELD Bridge No. 44
 Checked By RAL Date 3/95 Bridge Design Supervisor P. PIERCE
 Highway No. U.S. ROUTE 5 Log Sta. Surv. Sta.
U.S. ROUTE 5 OVER BLACK RIVER
 TRAFFIC SIGN SUMMARY

Designed By JRM Drawn By RR/CJM
 PROJECT SPRINGFIELD PROJECT NO. BR5-RS 0113 (B)
 I.G.C. Info. U.S. 5/1945622/signsum.dgn Sheet 18 of 90
 Bridge Sheet No.

23-MAY-1996 1363