


NOTE:
 LOCATION OF SIGNS AND CHANNELIZING ITEMS IS APPROXIMATE. CONTRACTOR TO DETERMINE FINAL LOCATION IN THE FIELD, AS APPROVED BY ENGINEER.

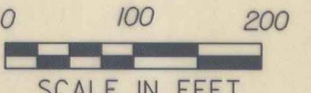

LEGEND
 [Hatched Box] PHASE I CONSTRUCTION

STATE OF VERMONT AGENCY OF TRANSPORTATION	
Town Of SPRINGFIELD	Bridge No. 44
Highway No. U.S. ROUTE 5	Log Sta. / Surv. Sta.
U.S. ROUTE 5 OVER BLACK RIVER	
TRAFFIC CONTROL PLAN	
Designed By JRM	Drawn By RR/CJM
Checked By RAL	Date 3/95
Bridge Design Supervisor P. PIERCE Date	
PROJECT SPRINGFIELD	PROJECT NO. BRS-RS 0113 (8)
U.S.C. Info. /usr5/1945622/trafcon1.dgn	
Bridge Sheet No.	Sheet 21 of 90