


NOTE:
 LOCATION OF SIGNS AND CHANNELIZING ITEMS IS APPROXIMATE. CONTRACTOR TO DETERMINE FINAL LOCATION IN THE FIELD, AS APPROVED BY ENGINEER.

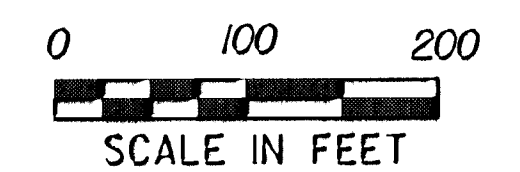

- LEGEND**
- COMPLETED PHASE I CONSTRUCTION
 - PHASE II CONSTRUCTION

STATE OF VERMONT AGENCY OF TRANSPORTATION			
Town Of	SPRINGFIELD	Bridge No.	44
Highway No.	U.S. ROUTE 5	Log Sta.	
		Surv. Sta.	
U.S. ROUTE 5 OVER BLACK RIVER			
TRAFFIC CONTROL PLAN			
Designed By	JRM	Drawn By	RR/CJM
Checked By	RAL	Bridge Design Supervisor	P. PIERCE
	Date	Date	Date
	3/95		
PROJECT	PROJECT NO.		
SPRINGFIELD	BRS-RS 0113 (8)		
I.G.C. Info.	/usr3/13145622/trafcon2.dgn		
Bridge Sheet No.	Sheet		22 of 90