


- NOTES:
- 1) UPON COMPLETION OF THE GRADING OPERATION FOR SIDESLOPE AREAS, THE CONTRACTOR SHALL IMMEDIATELY ESTABLISH VEGETATION IN ACCORDANCE WITH THE SEEDING REQUIREMENTS ON SHEET 2.
 - 2) UPON COMPLETION OF THE GRADING OPERATION FOR DITCHES FROM STA 104+50, LT. TO STA 111+00, LT. AND STA 121+50, RT. TO STA 13+00, RT., THE CONTRACTOR SHALL IMMEDIATELY LINE THE DITCH WITH STONE FILL AS INDICATED ON SHEET 13.
 - 5) SEE VAOT STD. DWGS. T-1 AND T-2 FOR TEMPORARY EROSION CONTROL DETAILS.

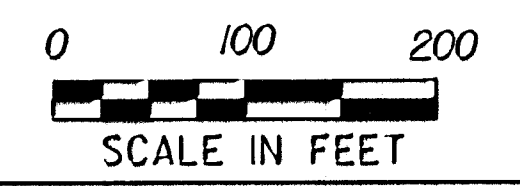

- LEGEND**
- COMPLETED PHASE I CONSTRUCTION
 - PHASE II CONSTRUCTION

STATE OF VERMONT AGENCY OF TRANSPORTATION			
Town Of	SPRINGFIELD	Bridge No.	44
Highway No.	U.S. ROUTE 5	Log Sta.	
		Surv. Sta.	
U.S. ROUTE 5 OVER BLACK RIVER			
EROSION CONTROL PLAN			
Designed By	JRM	Drawn By	RR/CJM
Checked By	RAL	Bridge Design Supervisor	P. PIERCE
	Date 3/95	Date	
PROJECT	SPRINGFIELD	PROJECT NO.	BRS-RS 0113 (8)
I.G.C. Info.	/usr3/1945622/erosion2.dgn		
Bridge Sheet No.		Sheet	25 of 90