


STA. 100+94 LT
END BRUCCING MATERIAL

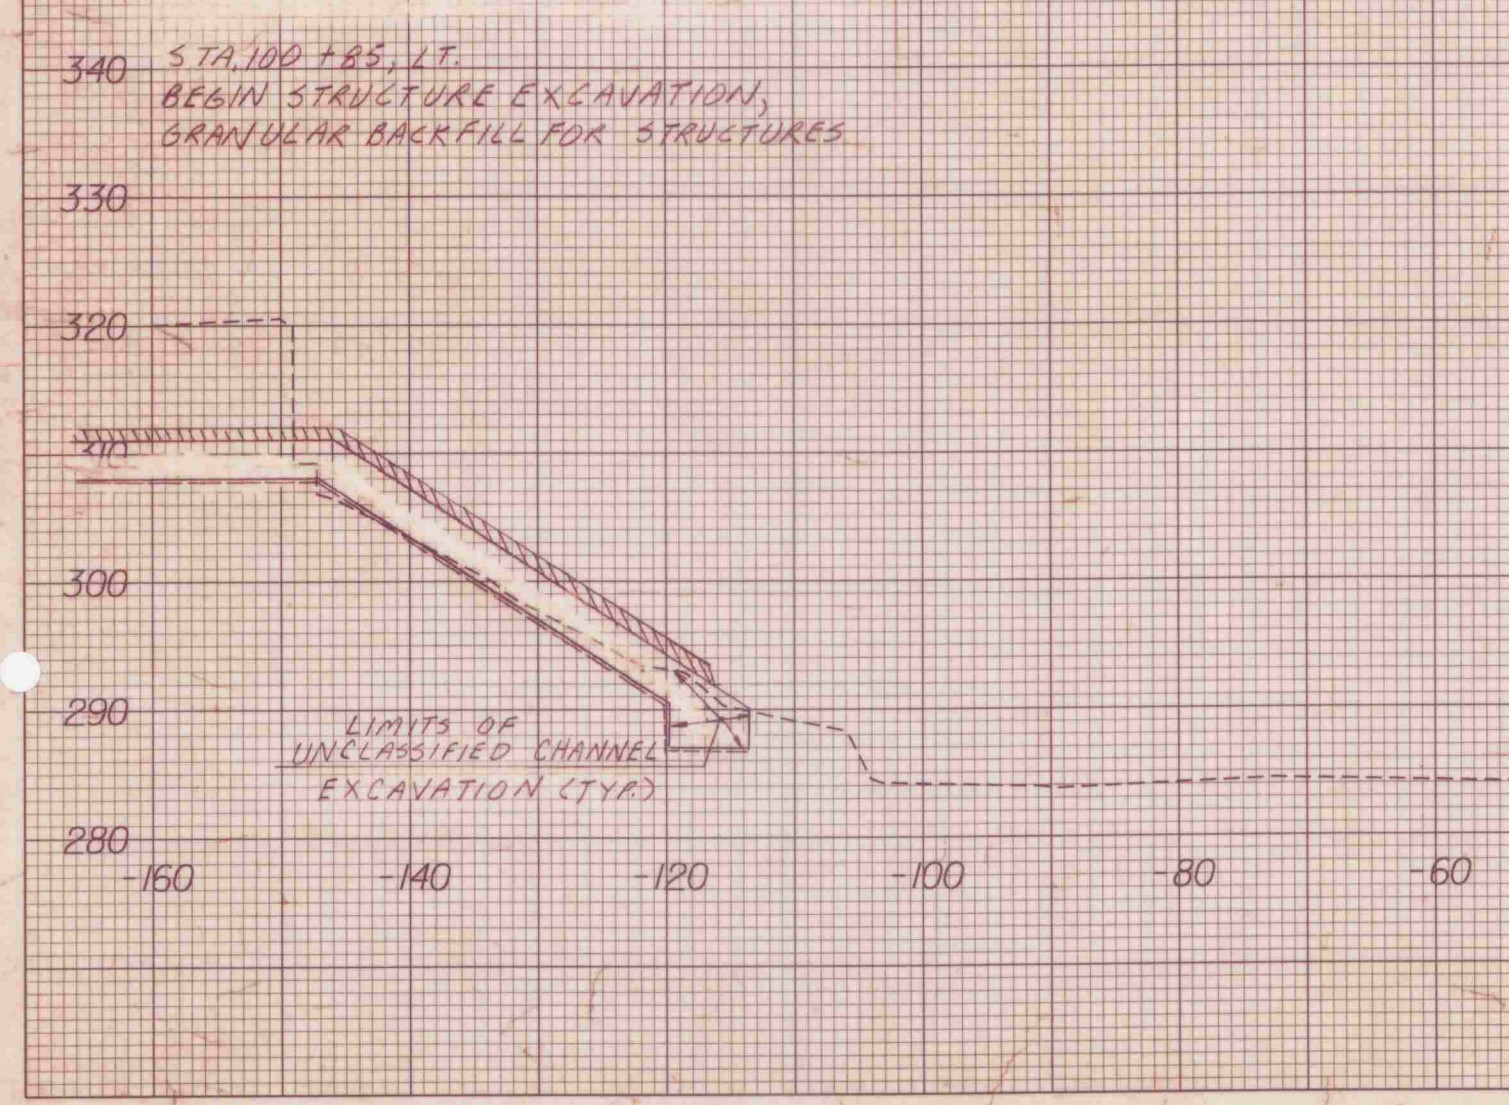

STA. 100+85 LT
BEGIN STRUCTURE EXCAVATION,
GRANULAR BACKFILL FOR STRUCTURES