
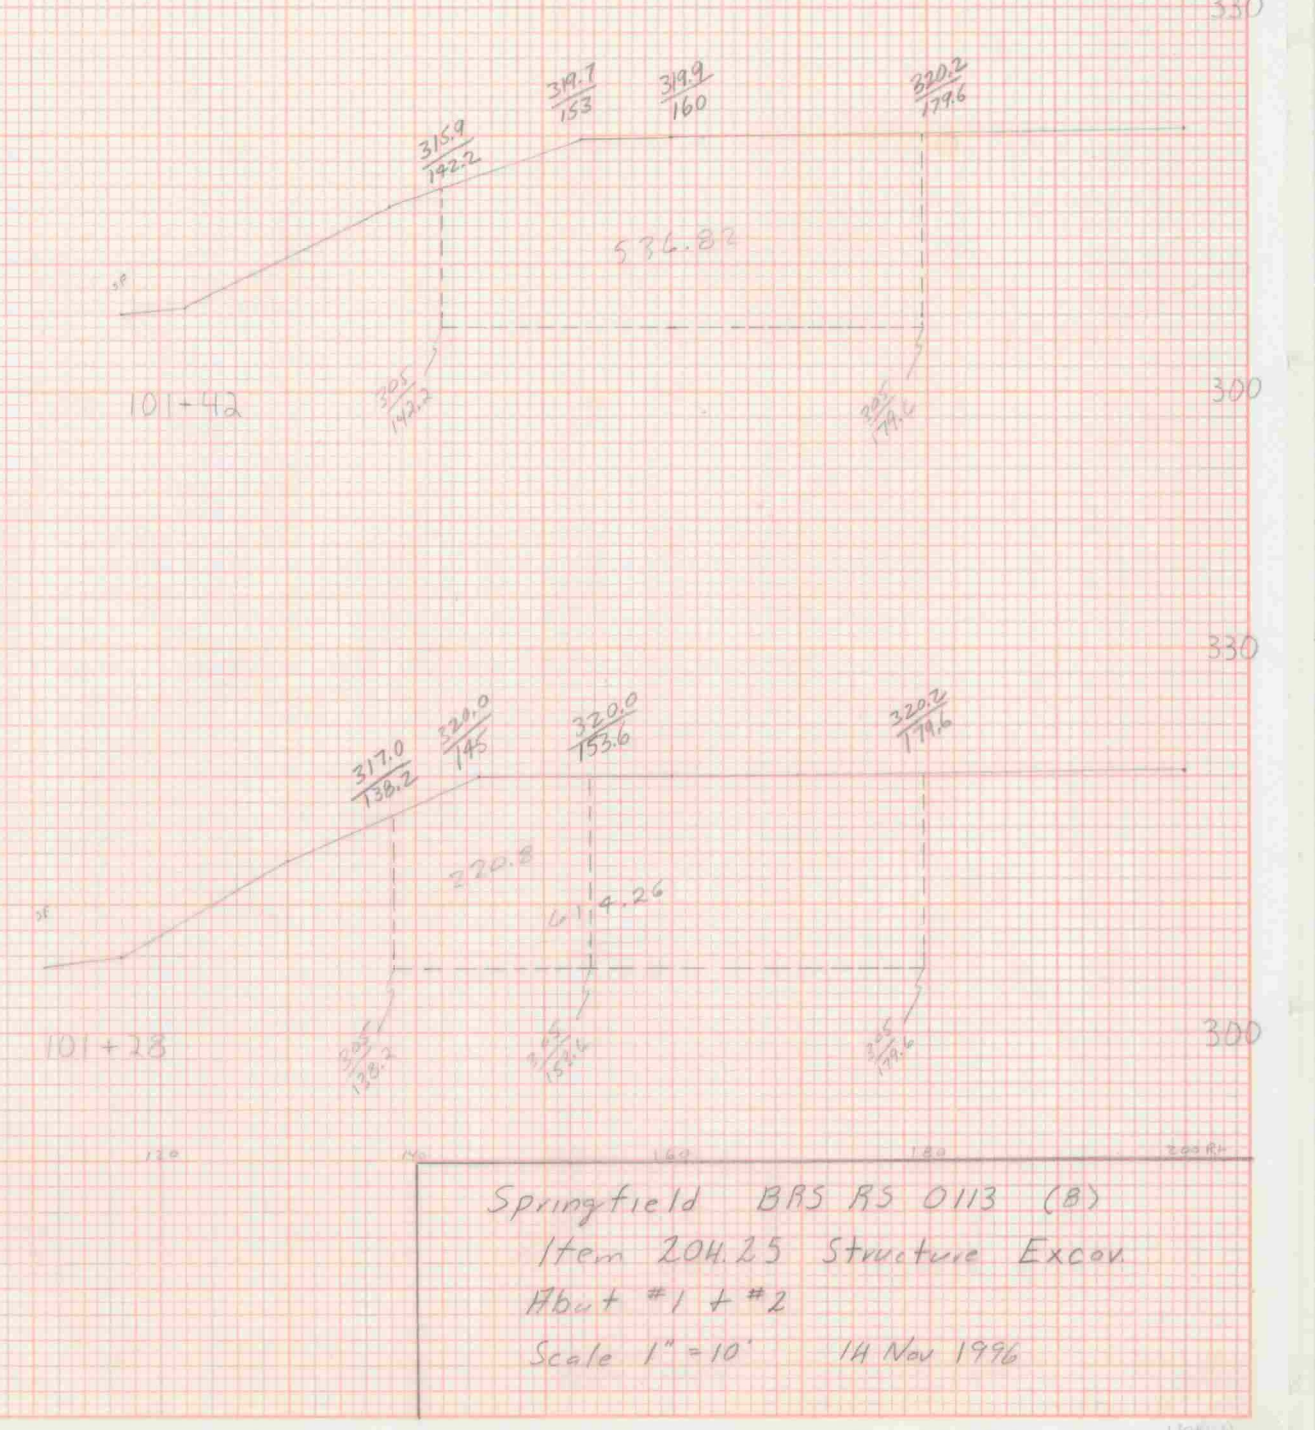


Abut #2
Item 204.25 Structure Excav

Sta	Area SF	Byg H _{exc}	length	Vol (CY)
100+89	245.88	2.6189	13	126.09
101+03	84.27791	1.3680	13.5	68.88
101+03	136.98	1.2771	13.5	63.95
101+15.5	139.68	2.1777	13	104.75
101+29.84	118.15	303.43 Cy		
101+29	218.92			
101+42	219.03			

Abut #1
Item 204.25 Structure Excavation

Sta	Area SF	Byg H _{exc}	length	Vol (CY)
100+89	427.86	4.2786	14	221.44
101+03.44	128.66	2.1332	12.51	98.47
101+03.44	222.00	2.1332	12.51	98.47
101+15.51	209.63	2.1332	12.49	98.40
101+18.64	220.80	2.1332	12.49	98.40
101+28.64	411.74	5.7558	14.00	298.43
101+42	336.88			

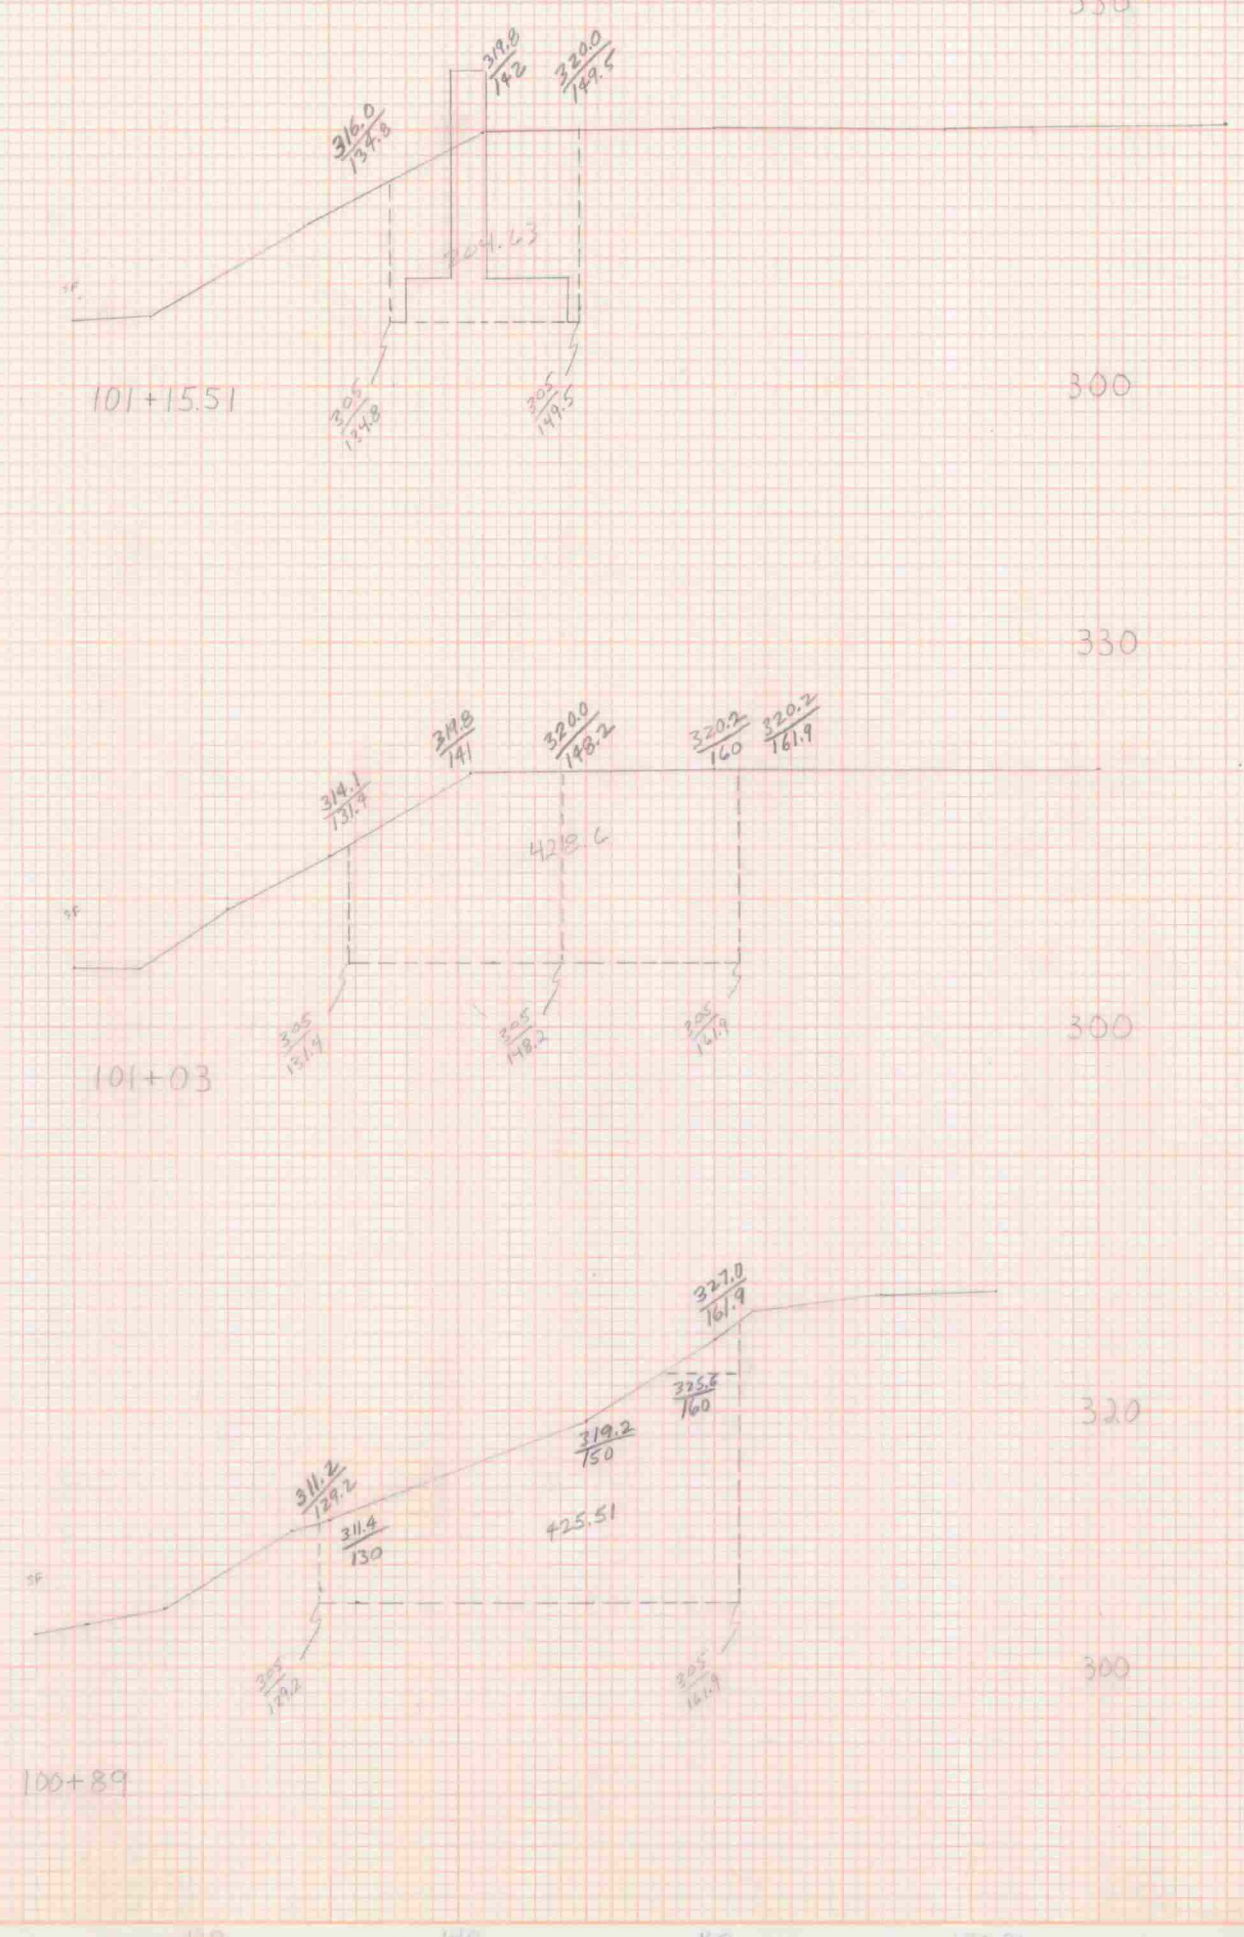

Springfield BAS AS 0113 (B)
Item 204.25 Structure Excav
Abut #1 & #2
Scale 1" = 10' 18 Nov 1996

DATE: 11/18/96
BY: [Signature]
CHECKED BY: [Signature]
APPROVED BY: [Signature]

DATE: 11/18/96
BY: [Signature]
CHECKED BY: [Signature]
APPROVED BY: [Signature]