


TYPICAL ELEVATION  
 2 - REQ'D AS SHOWN  
 2 - REQ'D OPP HAND

OFFSET BLOCK	H
THRU A	1 1/16"
THRU F	7 1/16"

9/16" HOLES IN BACK FACE OF OFFSET BLOCK & FRONT FACE OF POST

POST NO.	RAIL HEIGHT DIMENSIONS			OFFSET BLOCK DIMENSIONS			
	A	B	C	D	E	F	G
1 <sup>R</sup>	4-1 3/8	3-2 15/16	1-9 3/4	0-11 7/16	1-5 3/8	2-9 3/8	—
2 <sup>R</sup>	3-10 3/16	3-1 1/4	1-9 3/8	0-9 3/4	1-3 3/8	2-6 3/16	—
3 <sup>R</sup>	3-7 1/4	2-11 7/16	1-9	0-8 3/8	1-2 7/16	2-3 11/16	—
4 <sup>R</sup>	3-3 15/16	2-9 15/16	1-8 11/16	0-6 7/16	1-1 1/4	2-0 1/4	—
5 <sup>R</sup>	—	2-7 1/16	1-8 3/16	—	0-11 3/16	—	1-4 9/16
6 <sup>R</sup>	—	2-3 1/2	1-7 11/16	—	0-9 15/16	—	1-2 13/16
7 <sup>R</sup>	—	2-3 1/4	1-7 3/16	—	0-8 1/16	—	1-1 1/16

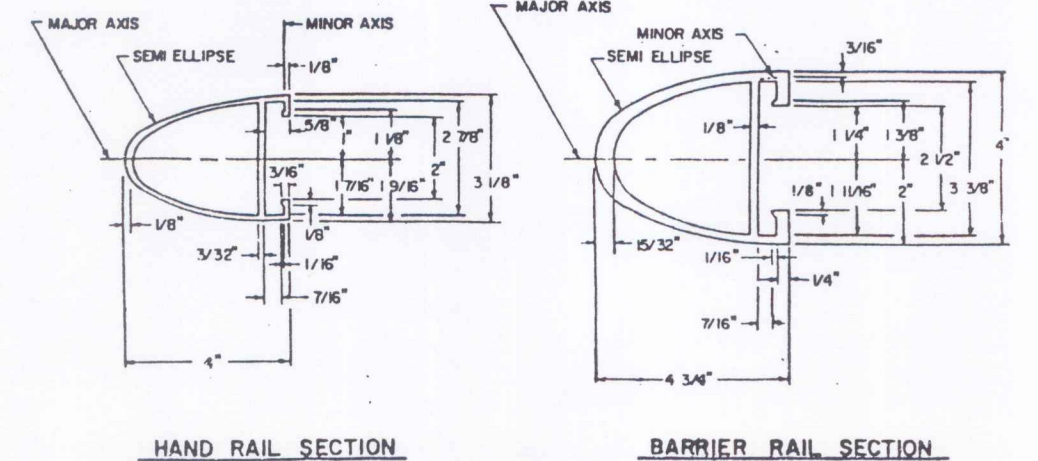

POST NO.	POST	POST	POST	POST	POST	POST	POST	POST	POST
1	1E	2E	3E	4E	5E	6E	7E		
2									
3									
4									
5									
6									
7									

REVISIONS  
 1. REVISION  
 2. REVISION  
 3. REVISION  
