


JUN-15-95 THU 7:28 CAROLINA HD BY P. 02

50

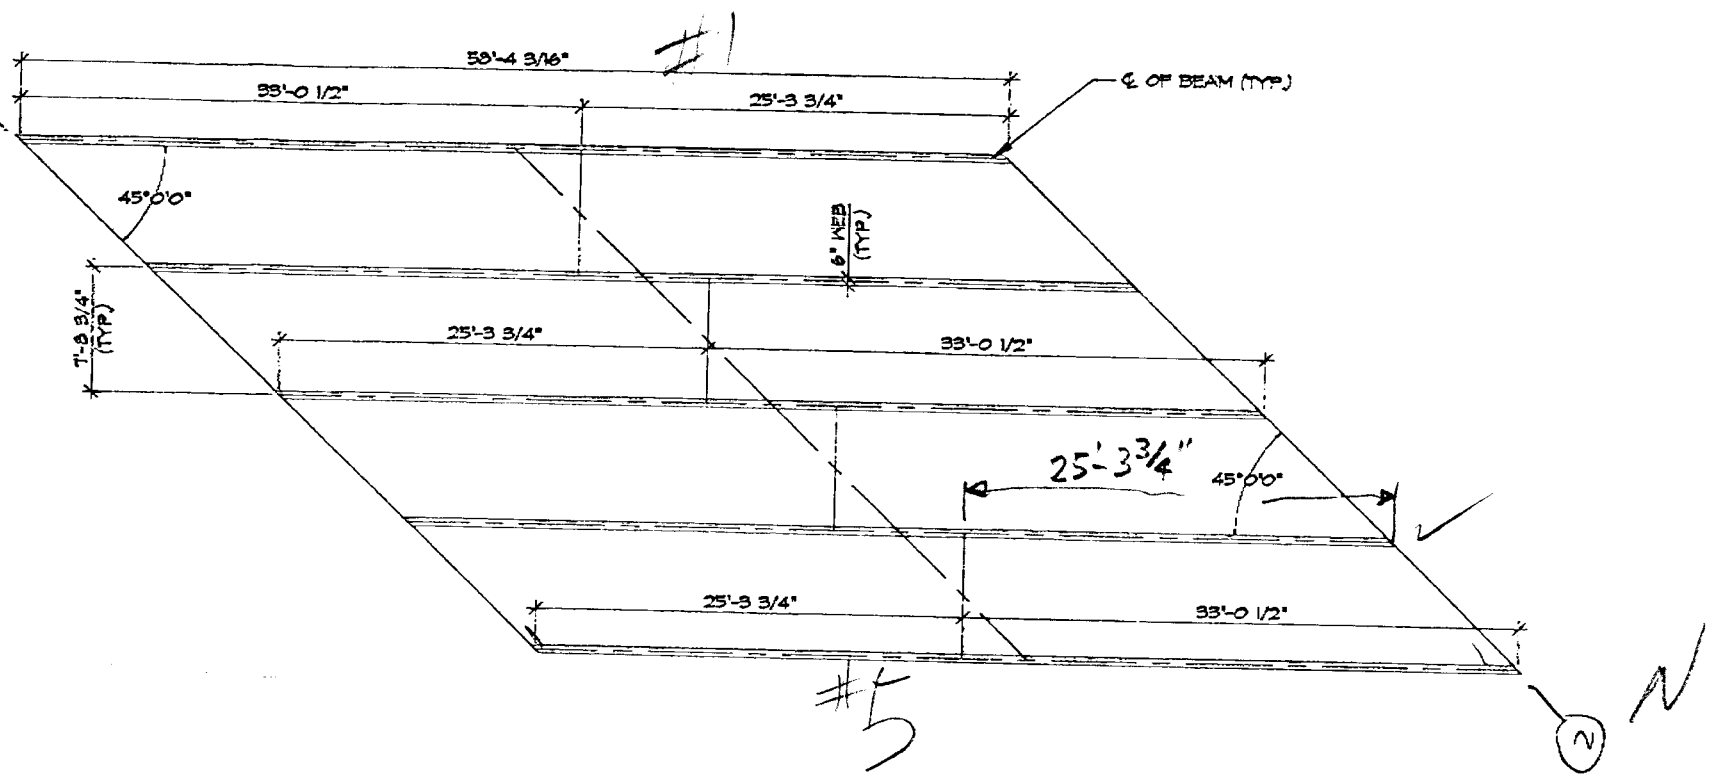

BEAM LAYOUT

RECEIVED
CK'D BY aw OK'D BY _____

JUN 15 1995

RESUBMIT _____ APPROVED

BY THW DATE 6/15/95