
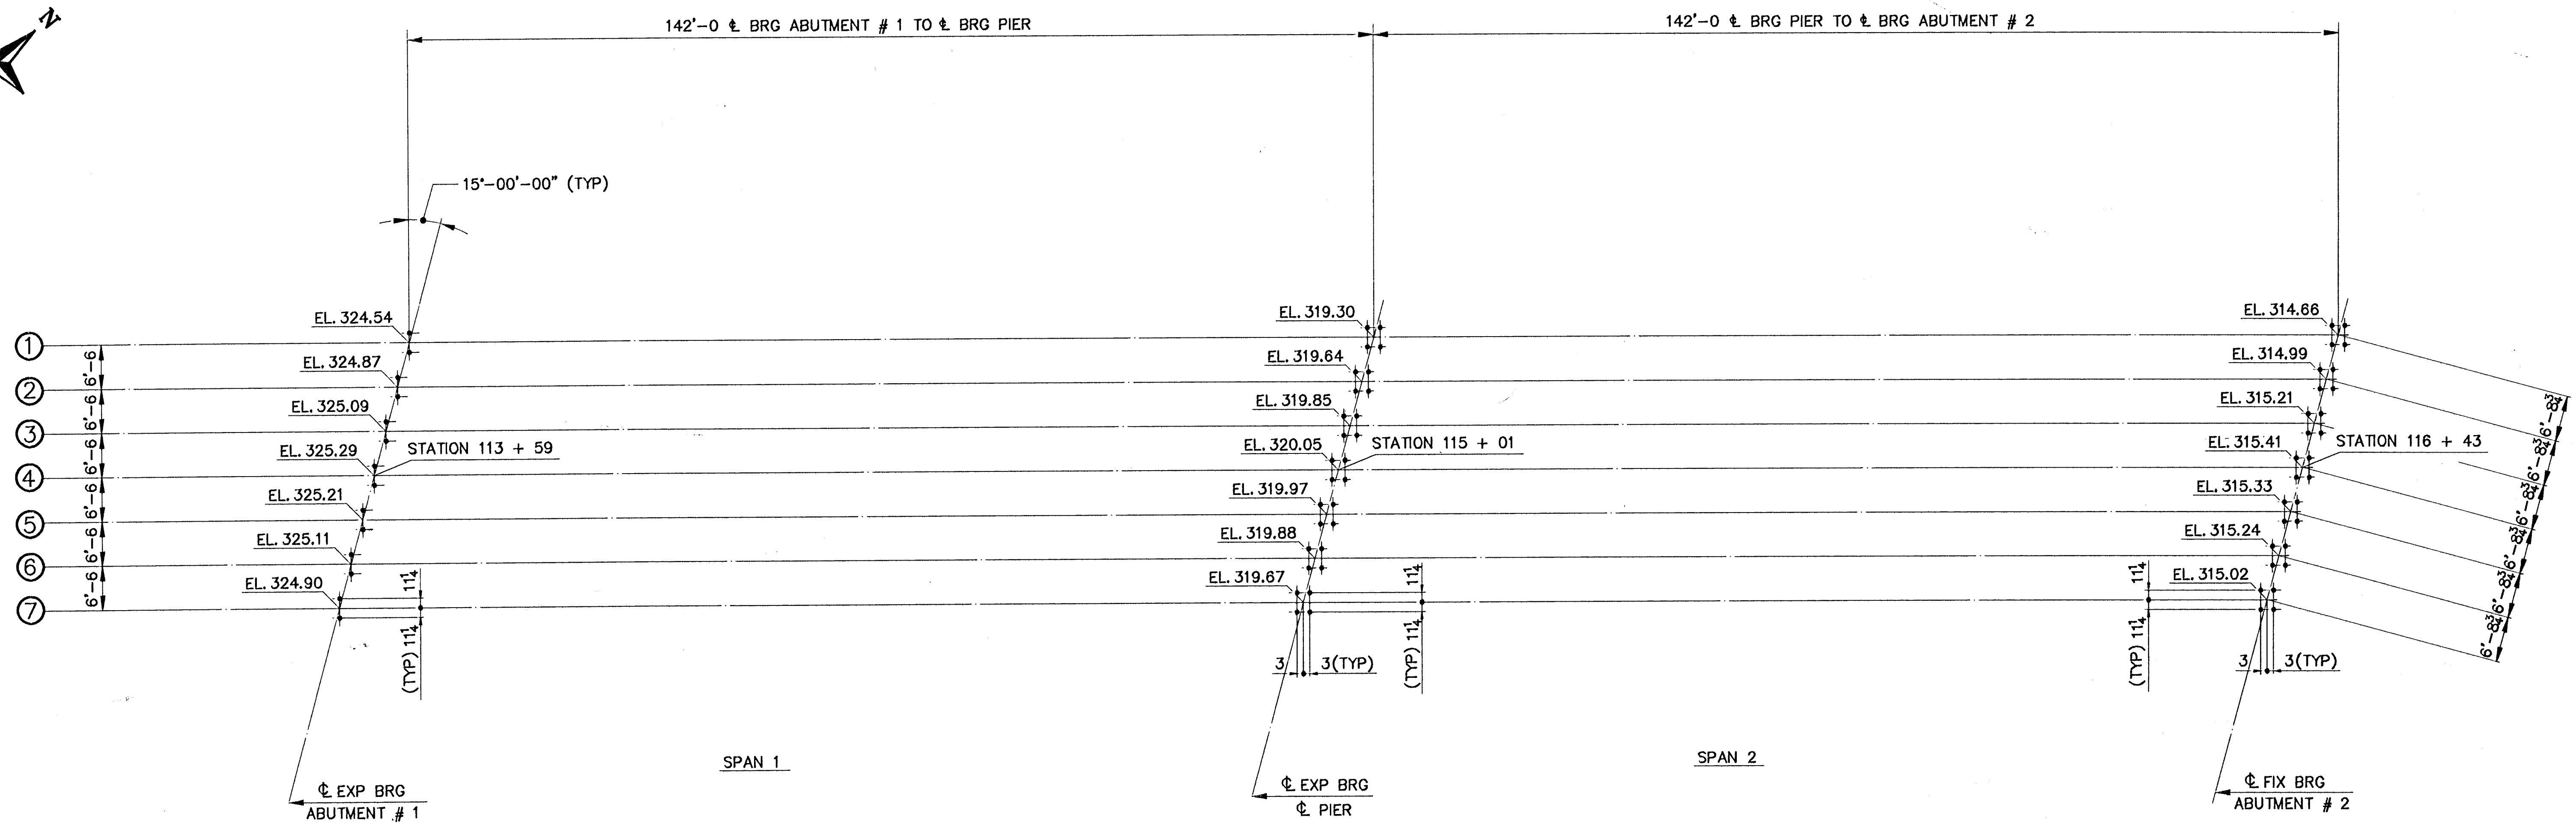



WORK ORDER NO.	DRAWING NO.	REV.
15713	E1	

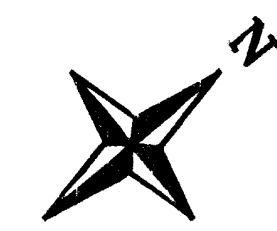

BRIDGE GEOMETRY
(FOR REFERENCE ONLY)

NOTES

- ELEVATIONS ARE TO TOP OF CONCRETE BEARING PADS.
- DIMENSIONS SHOWN ARE HORIZONTAL AND DO NOT REFLECT ANY CHANGE DUE TO GRADE.

ITEM NO. 506.55	BRIDGE NO. 44	PROJ. NO. BRS-RS 0113 (8)
TITLE: BRIDGE GEOMETRY		
APPROVED:		
PRINT DIST.	APPR.	
5 11-14-96	APPR.	
ORIG 12-3-96	FAB.	
5 11-18-96	APPR.	
ORIG 4-3-97	VAT	
 National Eastern Corporation Plainville, Connecticut		
JOB: U.S. ROUTE 5 OVER BLACK RIVER SPRINGFIELD, VERMONT		
CUSTOMER: WINTERSETT, INC.		
DESIGNER: VERMONT AGENCY OF TRANSPORTATION		
CHECKED	10/16	CSD
DRAWN	9/96	CSD
WORK ORDER NO.	DRAWING NO.	REV.
15713	E1	

10/16/96
 9/96
 CSD
 CSD