



WORK ORDER NO.	DRAWING NO.	REV.
15713	10-4	

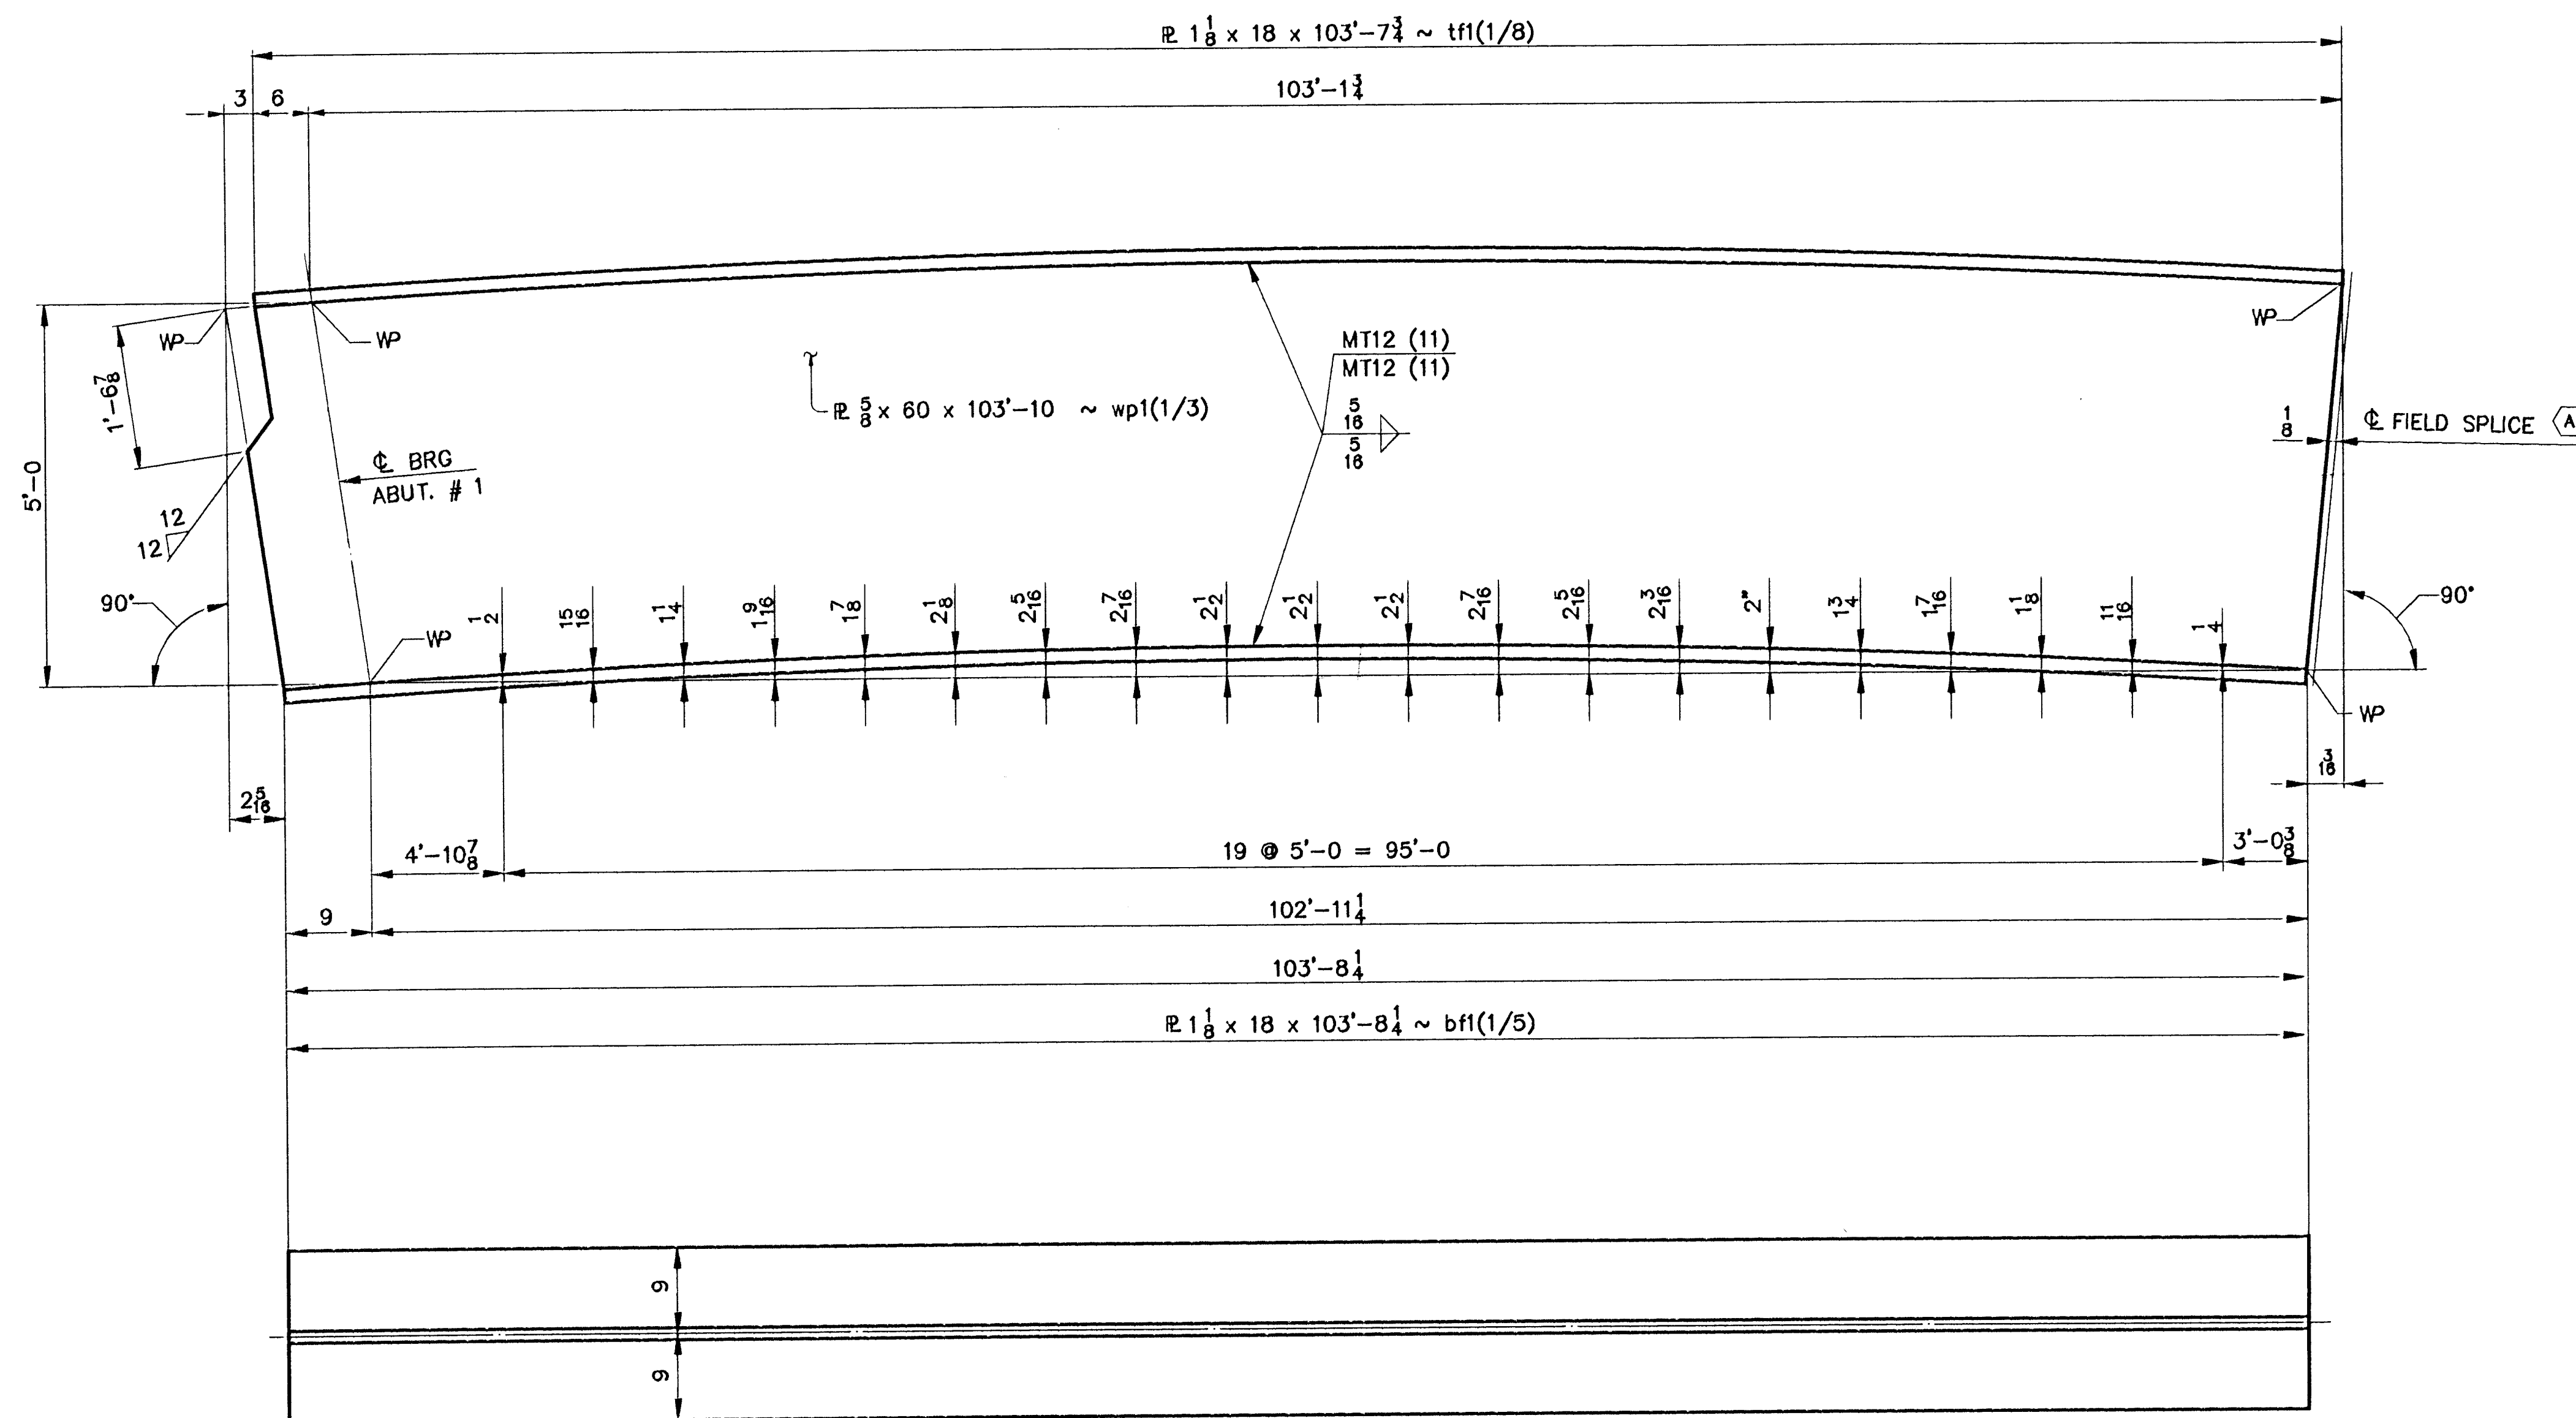

**NOTES**  
 1. ALL MATERIAL SHALL BE A709 GR 50W T2.

CAMBER DIAGRAMS ~ G1A THRU G7A

ITEM NO.	506.55	BR. NO.	44	PROJ. NO.	BRS-RS 0113 (8)
TITLE: CAMBER DIAGRAM ~ G1A THRU G7A					
APPROVED:	 National Eastern Corporation Plainville, Connecticut				
PRINT DIST.					
ORIG	5	11-18-96	APP	JOB: U.S. ROUTE 5 OVER BLACK RIVER SPRINGFIELD, VERMONT	
ORIG	5	11-18-96	APP		
ORIG	5	11-18-96	APP		
ORIG	5	11-18-96	APP		
CHECKED	10/96	CSD	CUSTOMER: WINTERSETT, INC.		
DRAWN	9/96	CSD	DESIGNER: VERMONT AGENCY OF TRANSPORTATION		
			WORK ORDER NO.	DRAWING NO.	REV.
			15713	10-4	