
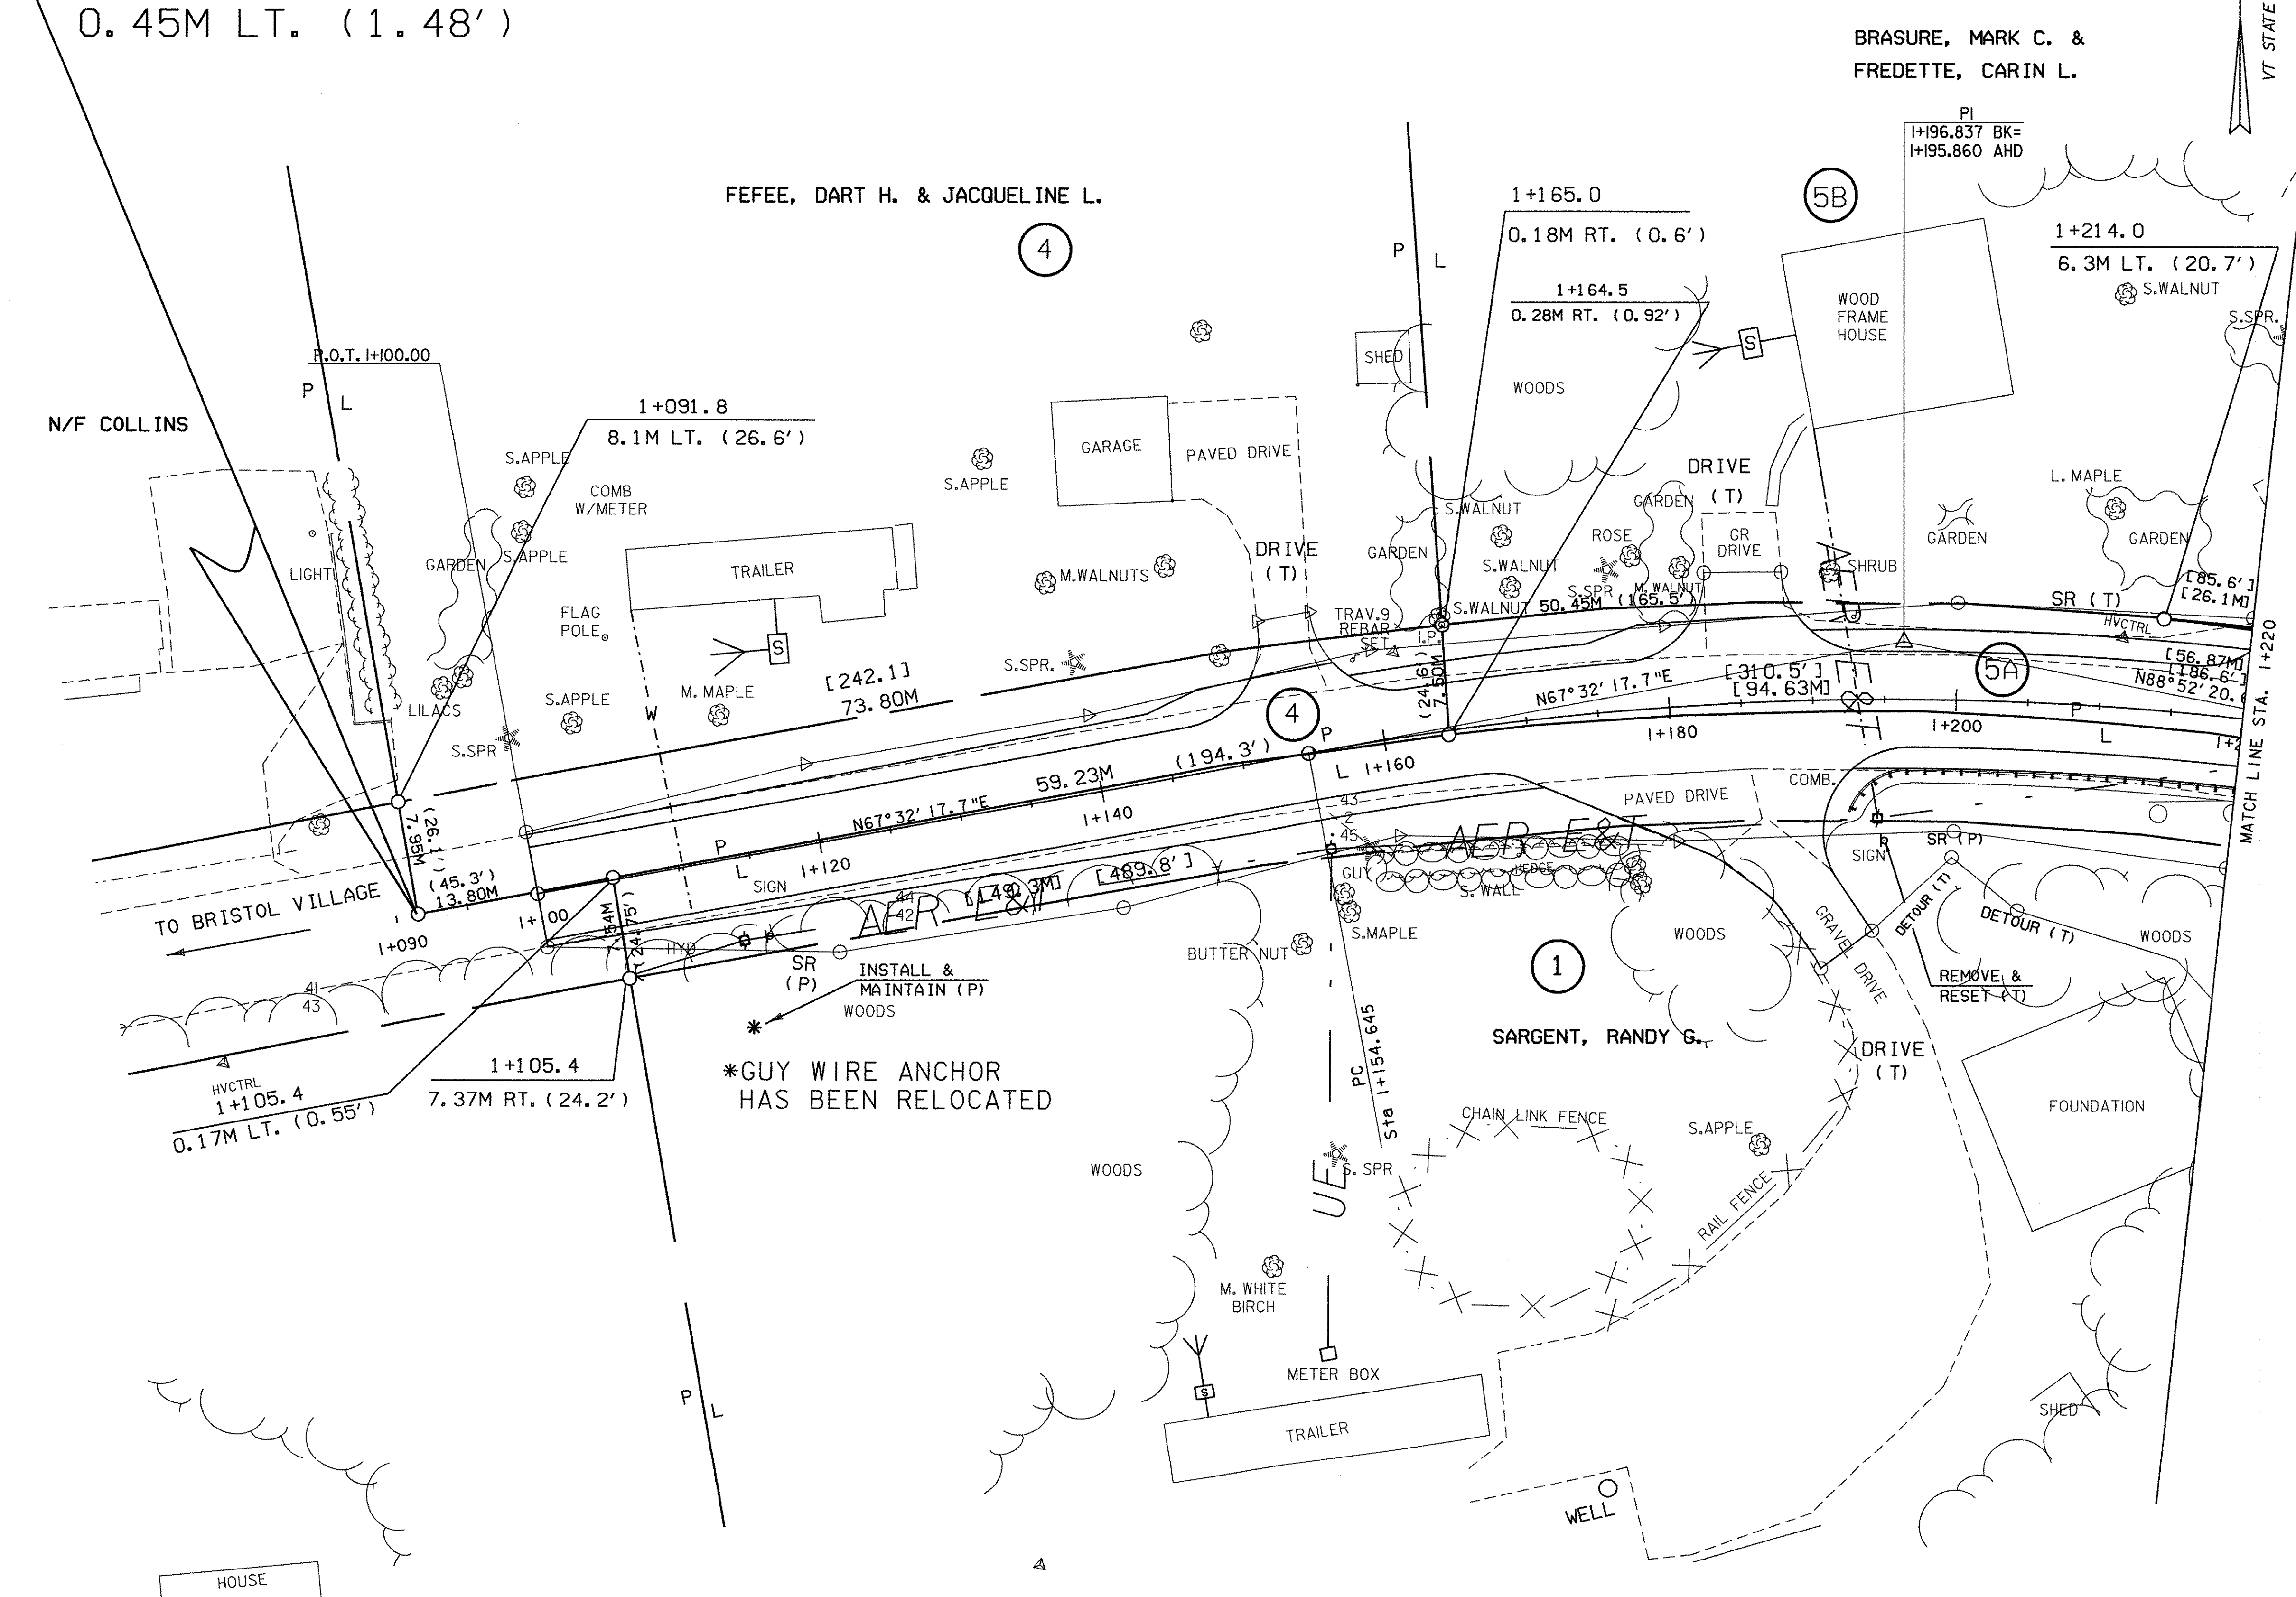


BEGIN R.O.W PROJECT
 BRF 021-1(13) STA. 1+091.7
 0.45M LT. (1.48')

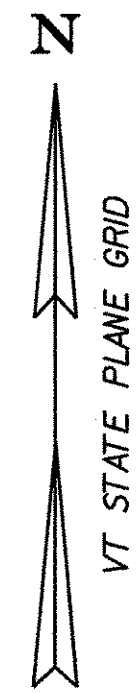

ROW LAYOUT SHEET 1

DATUM
 VERTICAL _____
 HORIZONTAL _____

FOR ROW REFERENCE ONLY
 ROW PLANS MAY BE OBTAINED
 FROM THE TOWN CLERK'S OFFICE



PROJECT: BRISTOL	PROJECT NO.: ER 021-1(13)
DESIGN FILE NAME: /str2/78f188/df188bdr.dgn	PLOT DATE: 21-DEC-2006
IPARM FILE NAME: df188lr.l	SURVEY DATE:
SURVEYED BY: L. ORVIS	DRAWN BY: STR2
SQUAD LEADER: A. PORTALUPI	SHEET: 11 OF 67
ROW LAYOUT SHEET 1	