


ROW LAYOUT SHEET 2

FOR ROW REFERENCE ONLY
 ROW PLANS MAY BE OBTAINED
 FROM THE TOWN CLERK'S OFFICE

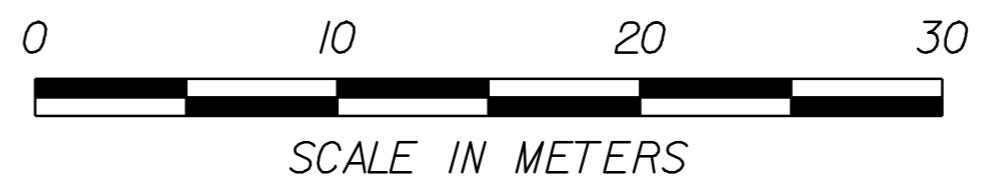

DATUM
 VERTICAL _____
 HORIZONTAL _____

PROJECT: BRISTOL	PROJECT NO.: ER 021-1(13)
DESIGN FILE NAME: /str2/78f188/df188bdr.dgn	PLOT DATE: 05-JAN-2007
IPARM FILE NAME: df188i2r.1	SURVEY DATE:
SURVEYED BY: L. ORVIS	DRAWN BY: STR2
SQUAD LEADER: A. PORTALUPI	SHEET: 12 OF 67
ROW LAYOUT SHEET 2	