


**ROADWAY LAYOUT SHEET 2**



**CURVE #2 DATA**  
 $\Delta = 12^{\circ}15'36''$  LT  
 R = 254.00 m  
 T = 27.279 m  
 L = 54.350 m  
 E = 1.461 m  
 BANK = 0.053 m/m

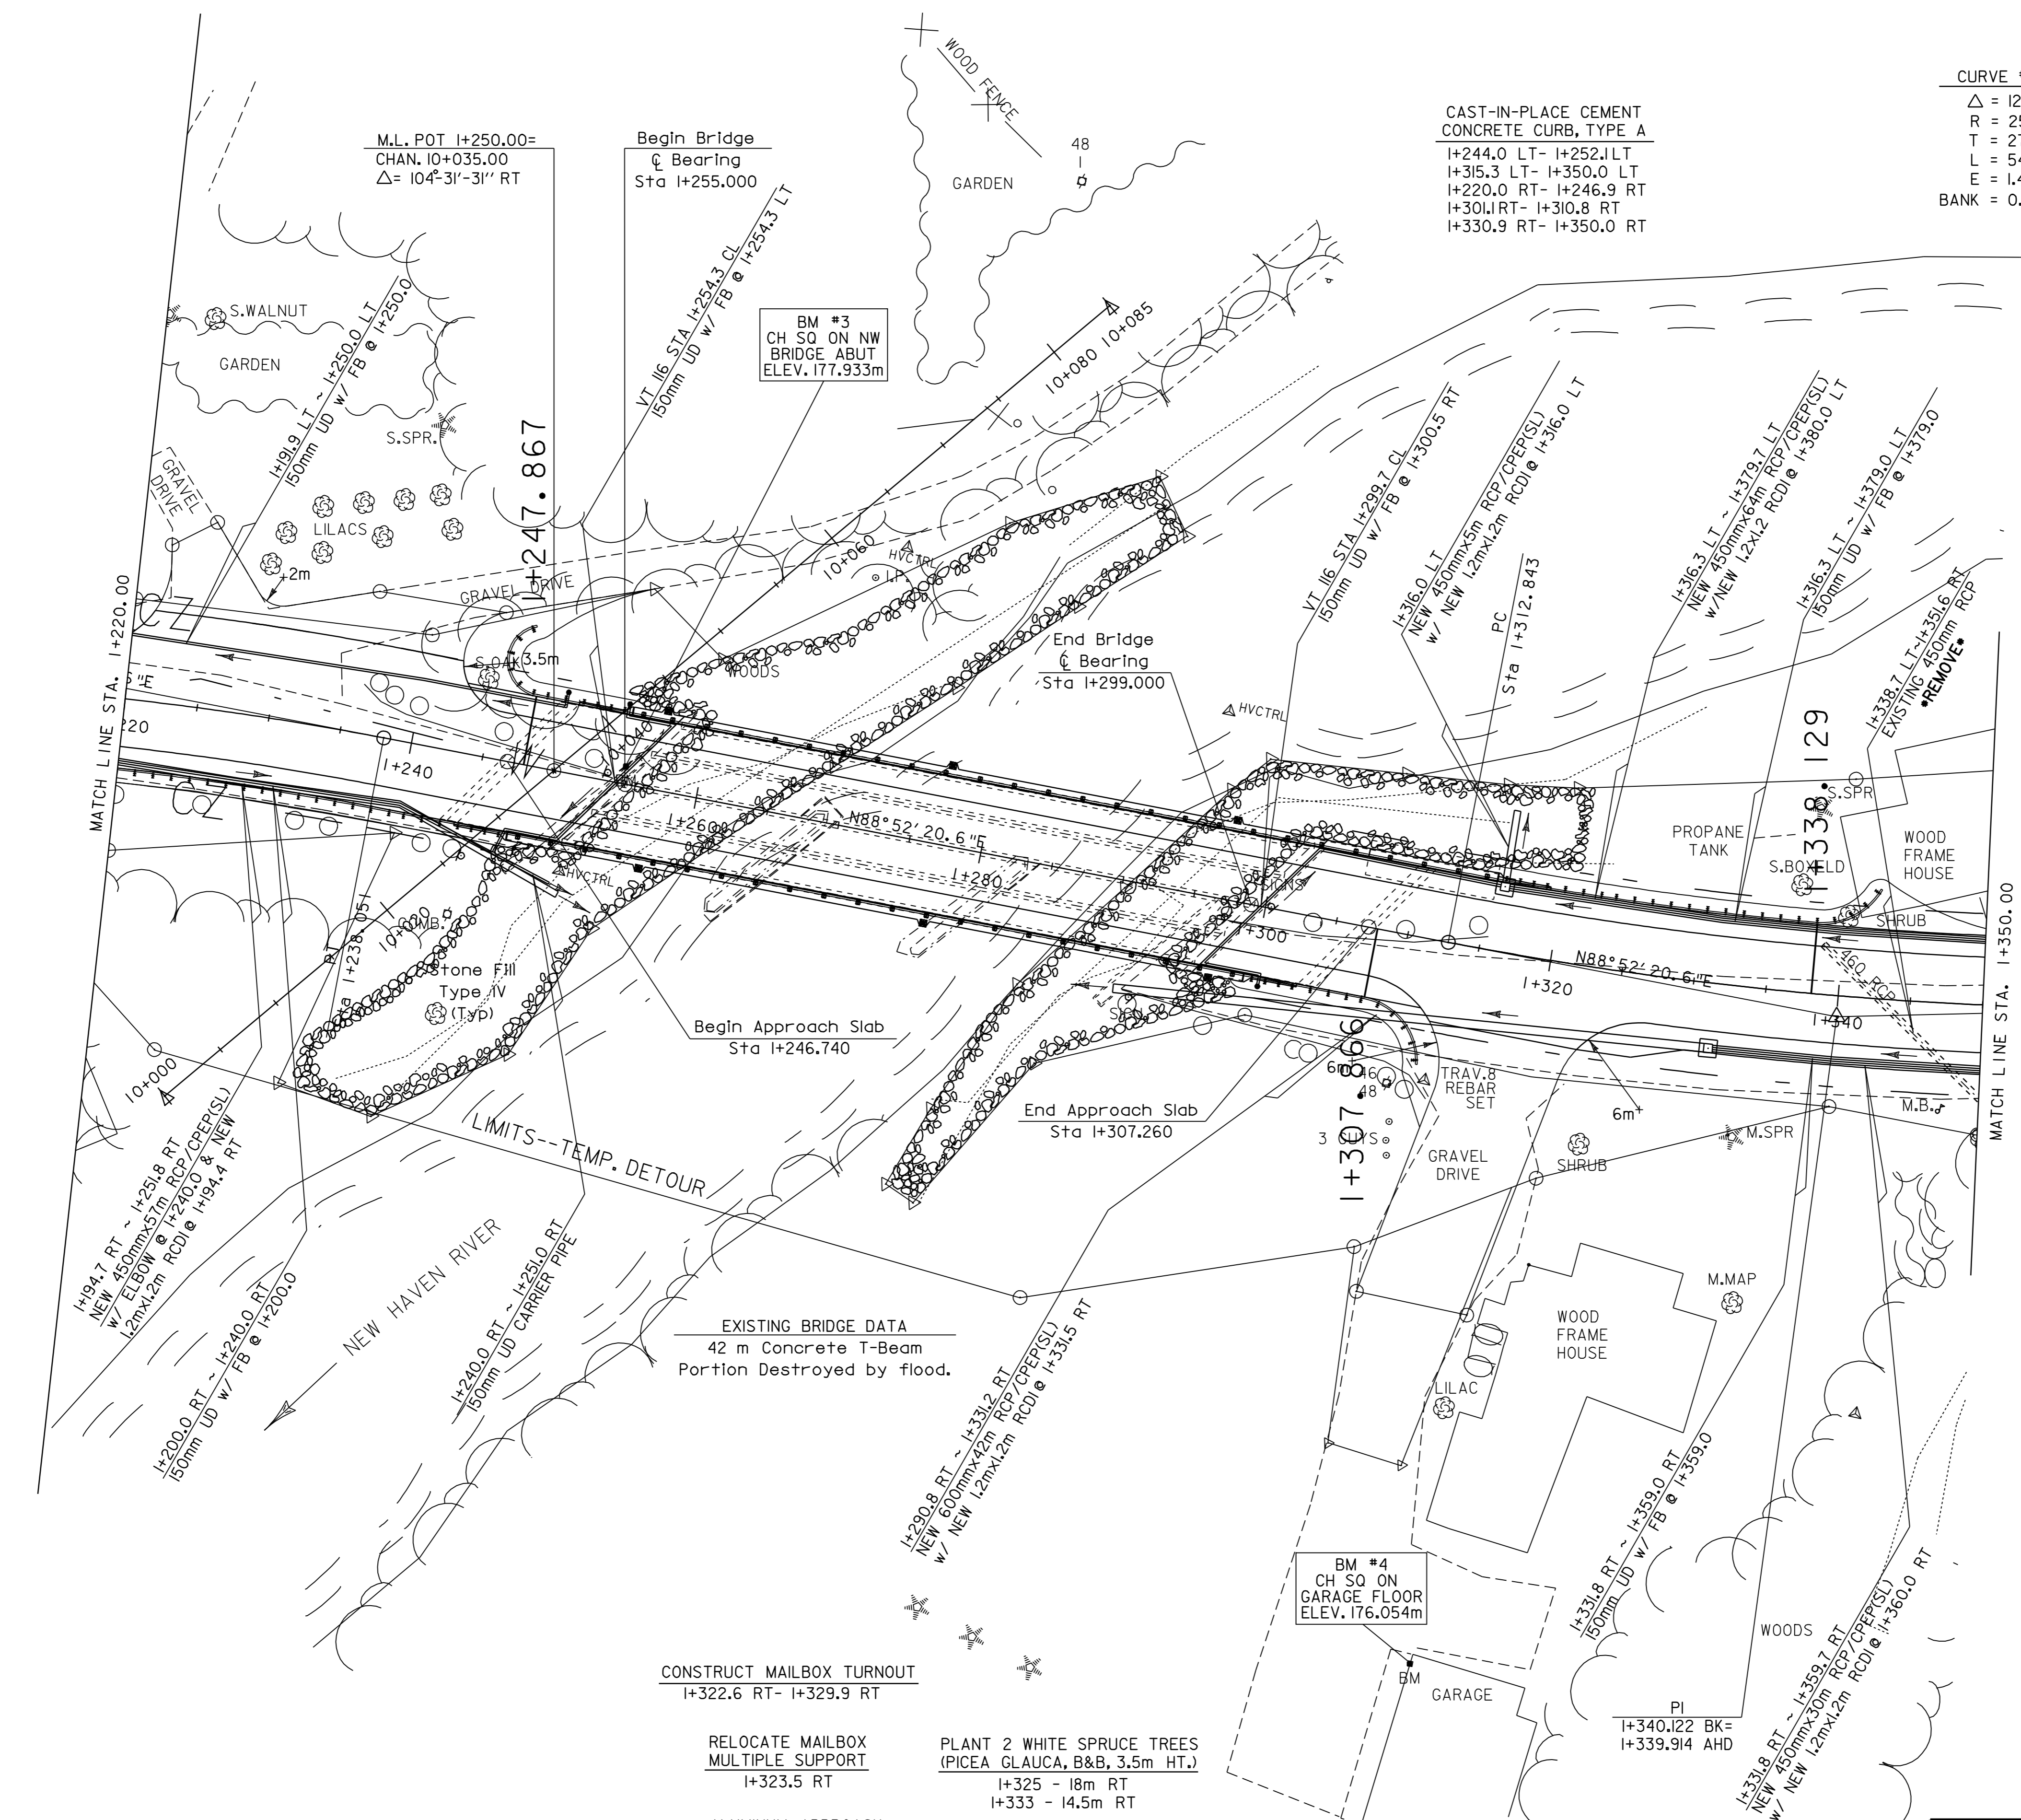

PROJECT: <b>BRISTOL</b>	PROJECT NO.: ER 021-1(13)
DESIGN FILE NAME: /str2/78f188/df188bdr.dgn	PLOT DATE: 05-JAN-2007
IPARM FILE NAME: df188i2.i	SURVEY DATE:
SURVEYED BY: L. ORVIS	SQUAD LEADER: A. PORTALUPI
LAYOUT SHEET 2	SHEET: 18 OF 67

<b>DATUM</b>	
VERTICAL	NAVD 88
HORIZONTAL	NAD83 (92)