
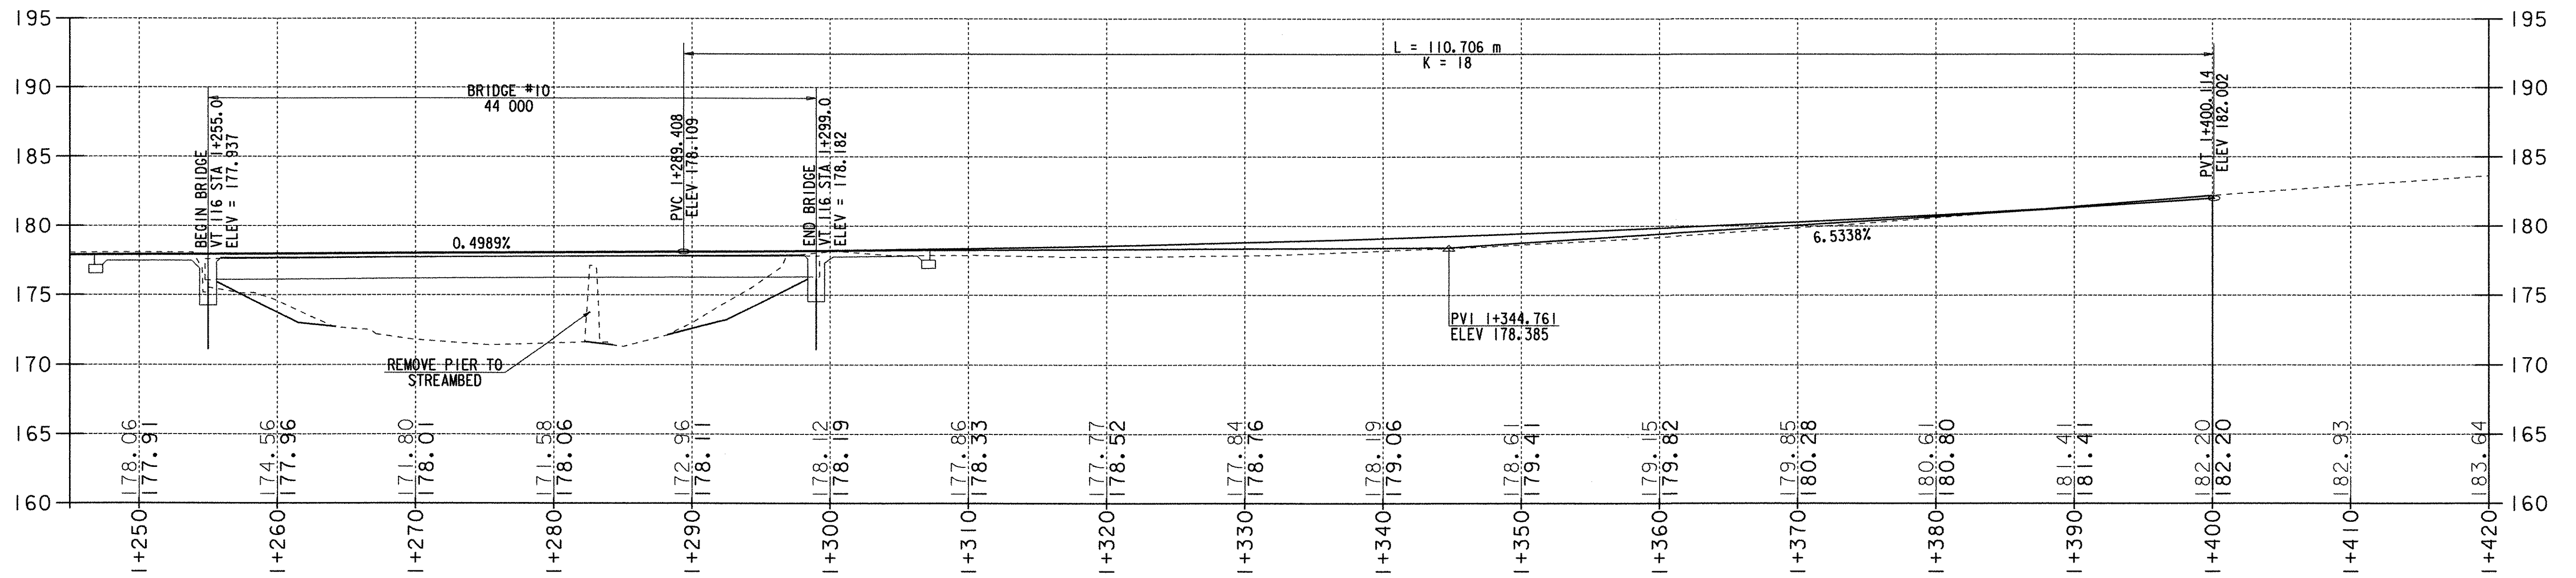


PROFILE - BRIDGE 10

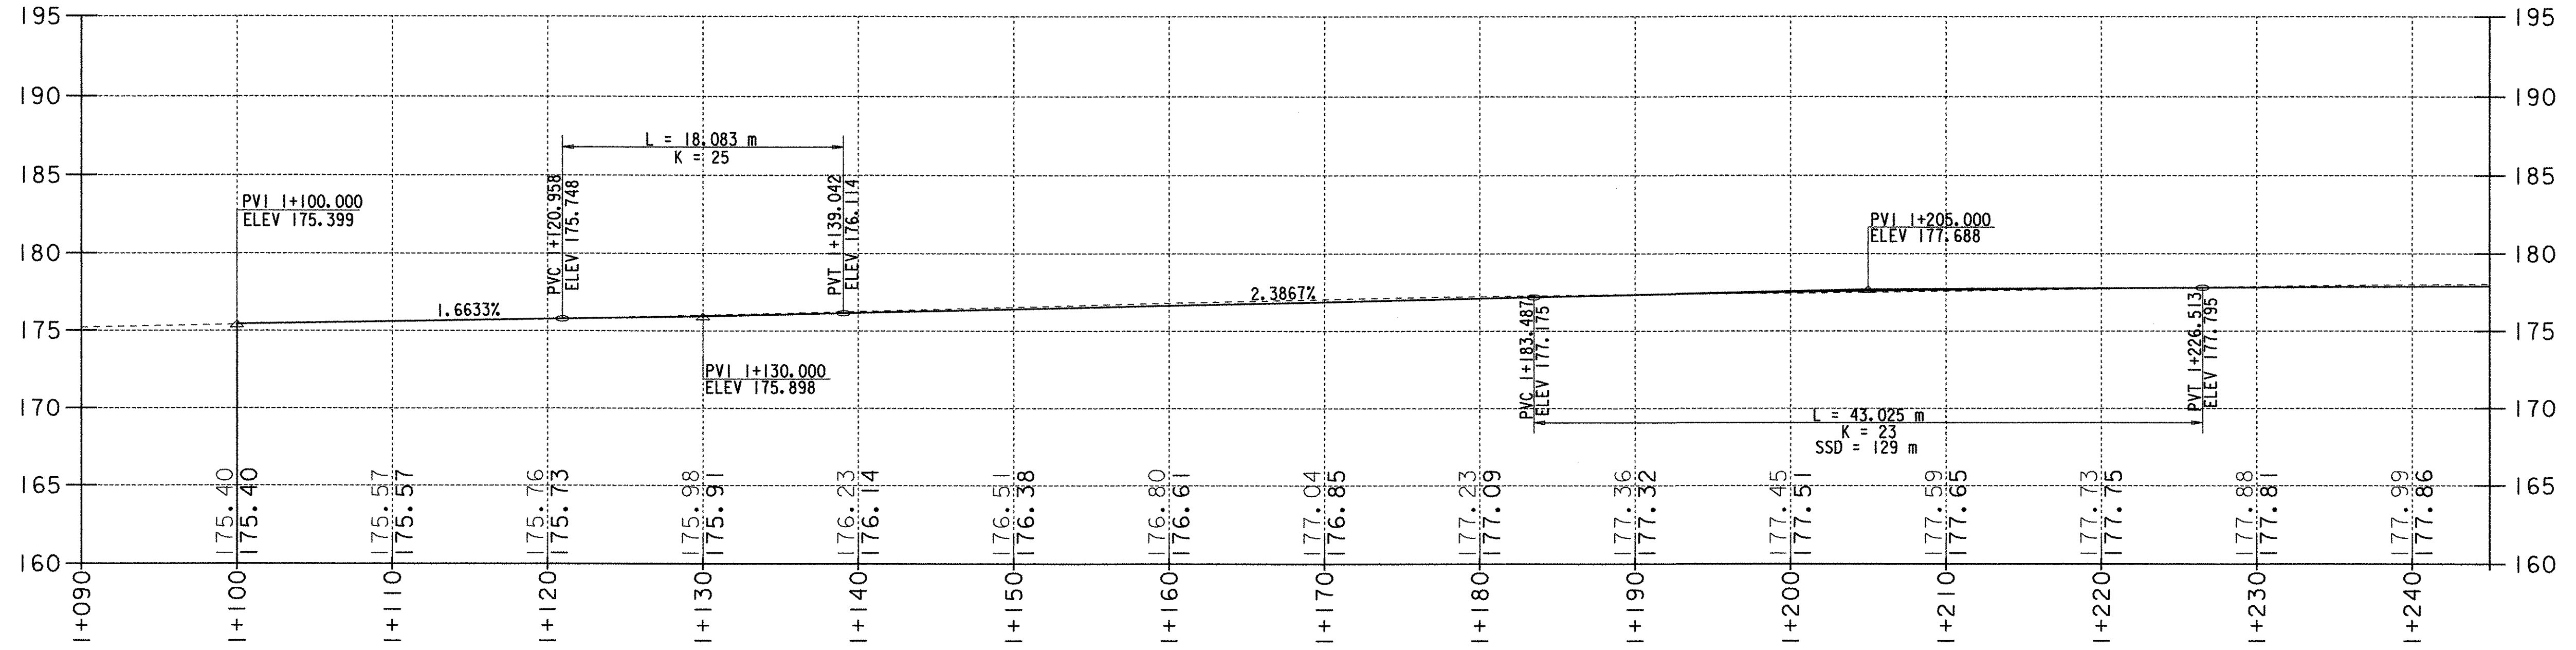

DATUM	
VERTICAL	NAVD 88
HORIZONTAL	NAD83 (92)

PROJECT: BRISTOL	PROJECT NO.: ER 021-1(13)
DESIGN FILE NAME: str2/78f188/df188wk.dgn	PLOT DATE: 03-JAN-2007
IPARM FILE NAME: df188pr1.i	SURVEY DATE:
SURVEYED BY:	DRAWN BY: Weeber
SQUAD LEADER: Porttalu	SHEET: 20 OF 67