



# BANKING DIAGRAM

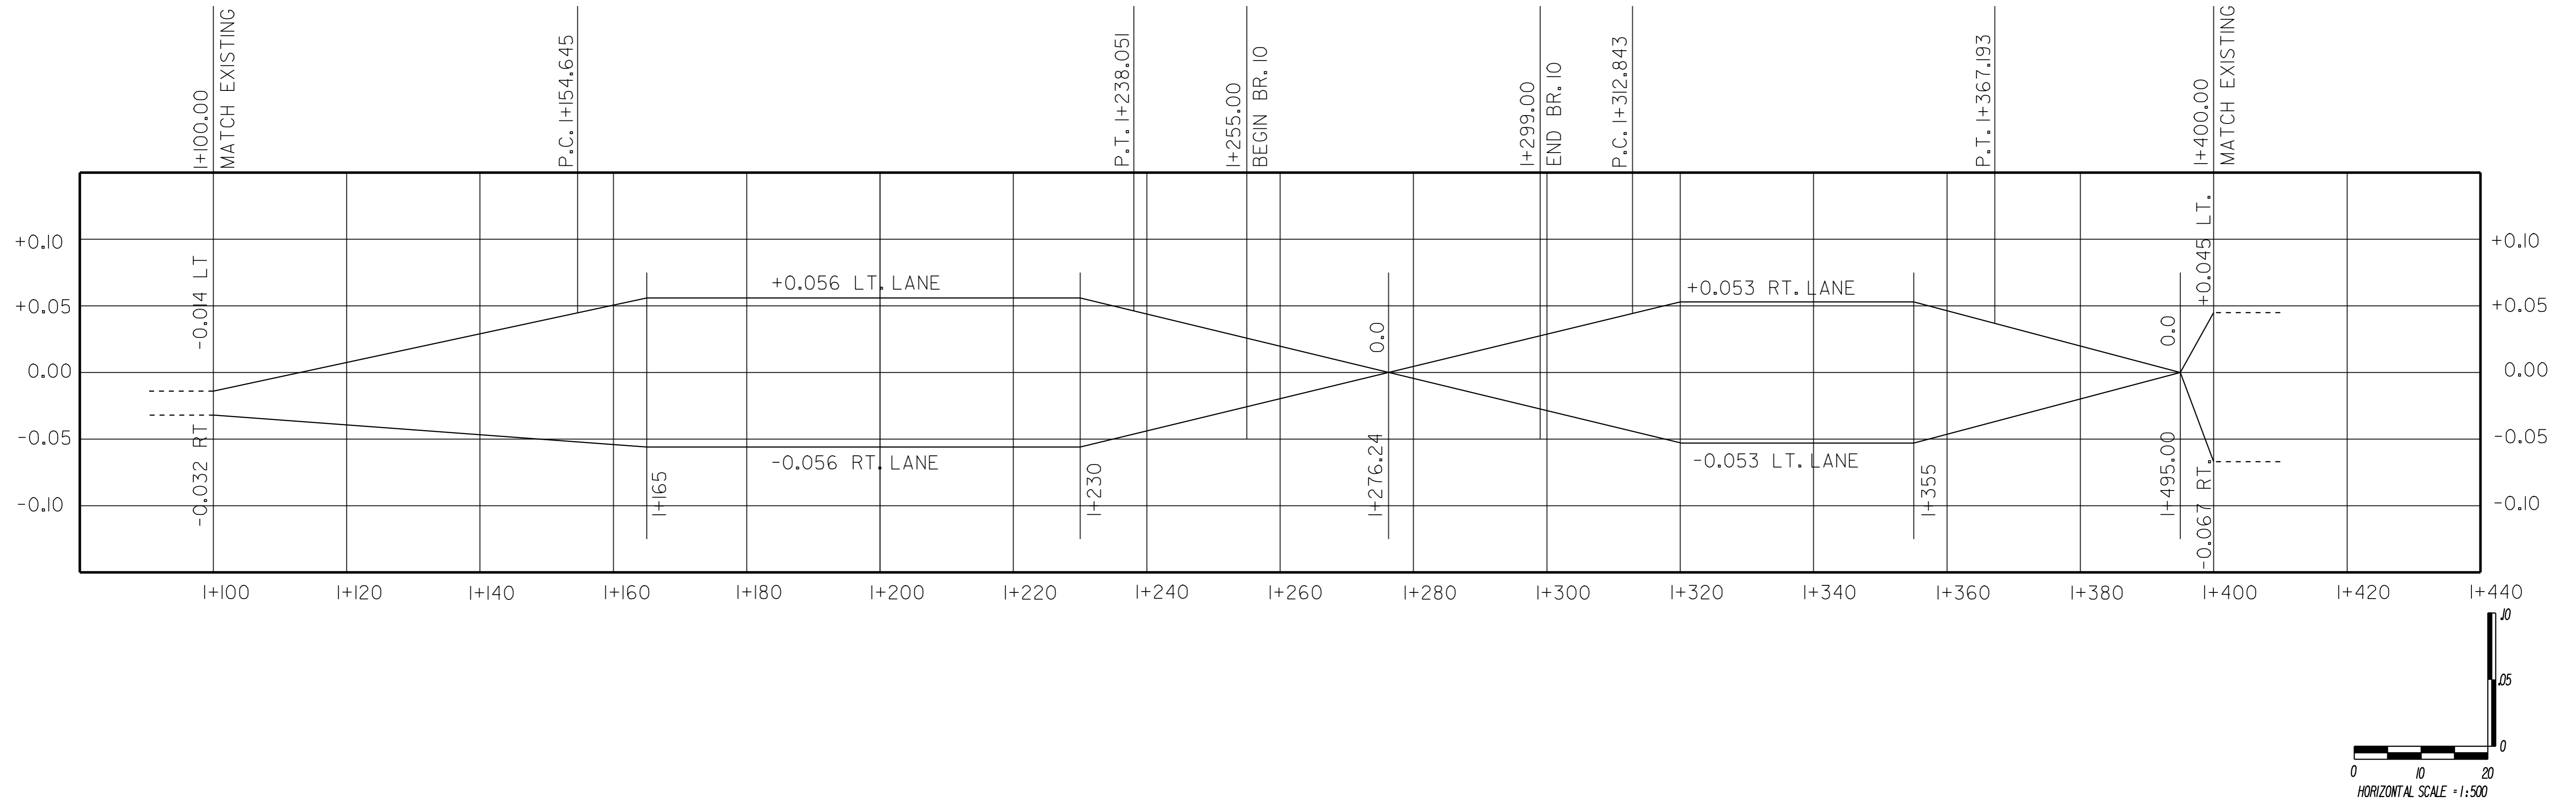

## MATERIAL TRANSITION DETAIL

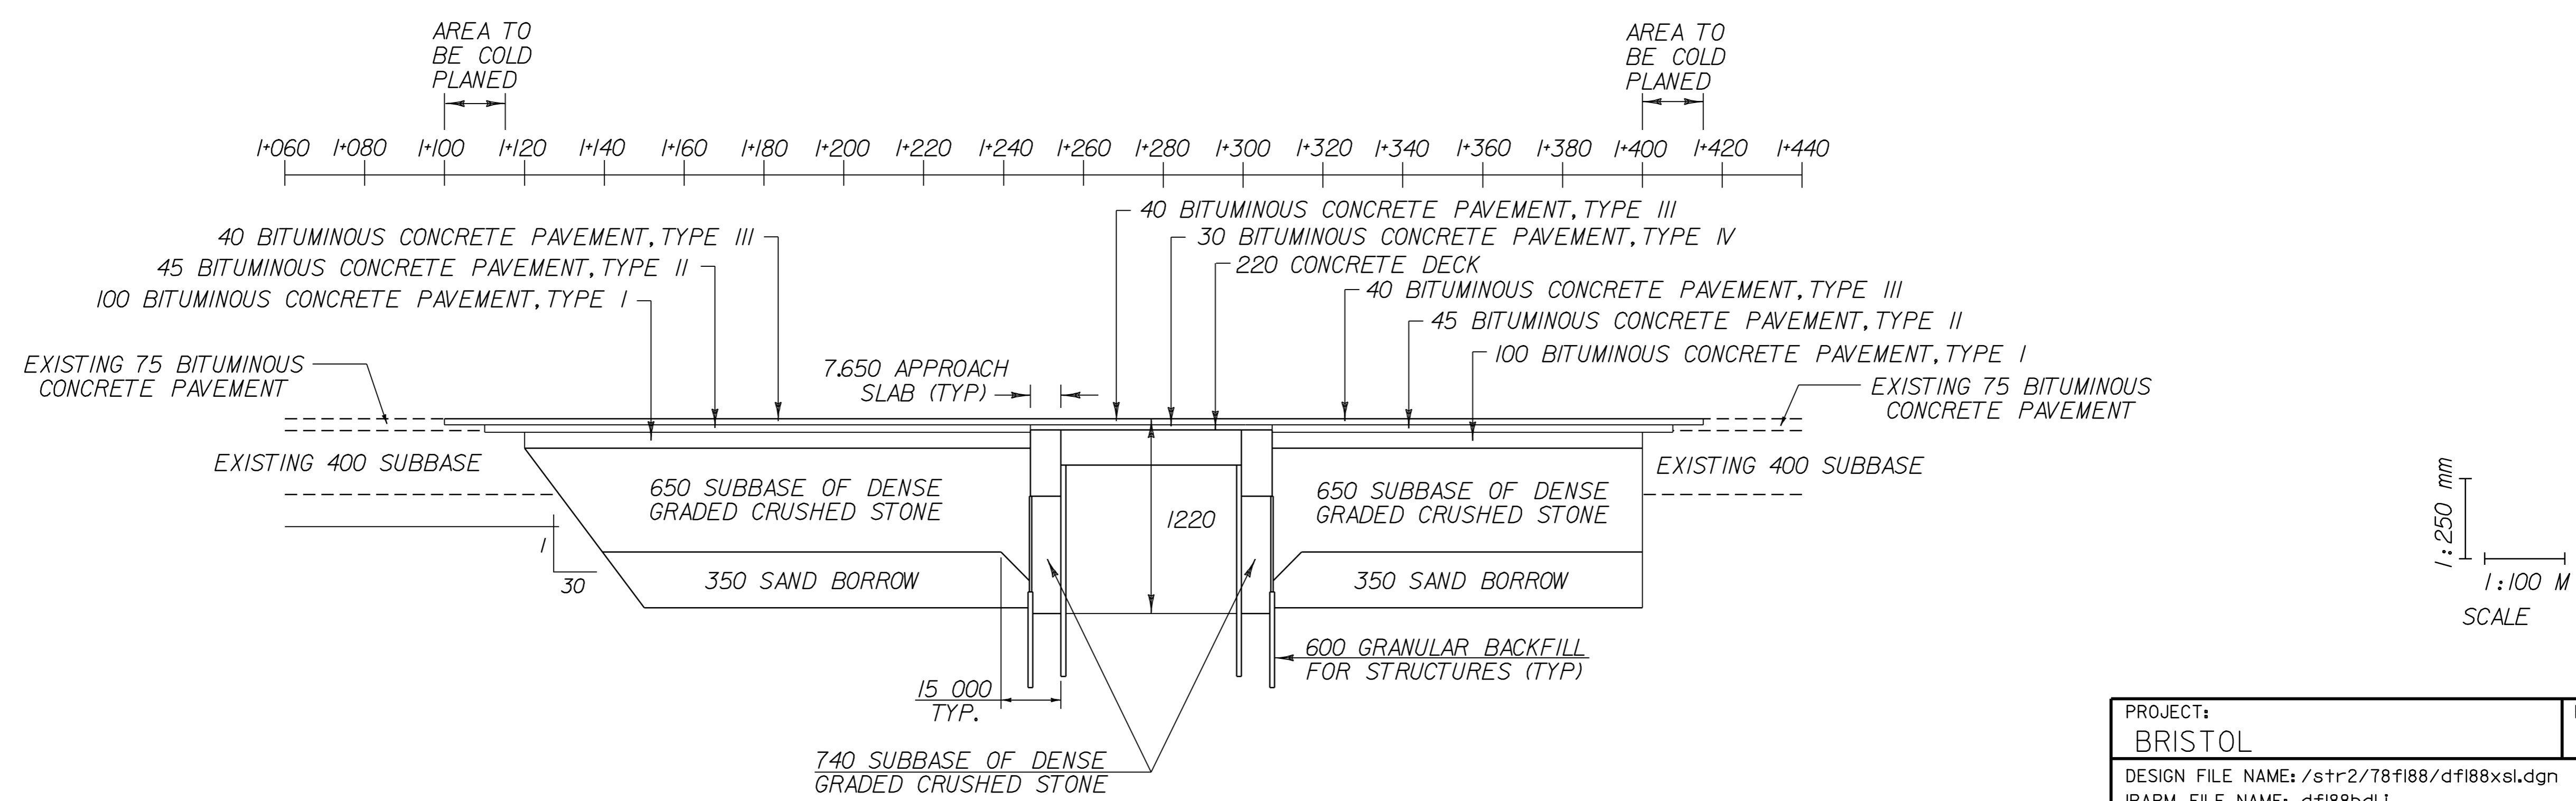

DATUM  
VERTICAL \_\_\_\_\_  
HORIZONTAL \_\_\_\_\_

PROJECT: <b>BRISTOL</b>	PROJECT NO.: <b>ER 021-1(13)</b>
DESIGN FILE NAME: /str2/78f188/df188xsl.dgn	PLOT DATE: 05-JAN-2007
IPARM FILE NAME: df188bd1.i	SURVEY DATE:
SURVEYED BY:	DRAWN BY: JLR
SQUAD LEADER: A. PORTALUPI	SHEET: 21 OF 67