


KEY

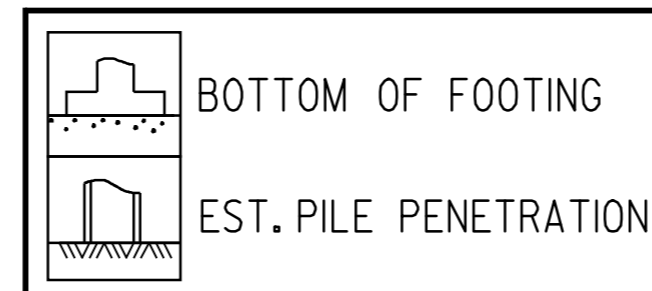

PROJECT: BRISTOL	PROJECT NO.: ER 021-1(13)
DESIGN FILE NAME: str2/78f188/df188bor.dgn	PLOT DATE: 05-JAN-2007
IPARM FILE NAME: sf188brl1	SQUAD LEADER: C. C. BENDA
DRAWN BY: J. TOUCHETTE	DATE: 07/98
	SHEET: 28 OF 67