


PLAN
Scale: 1:100

Location	"A"	"B"	"C"	"D"
Upstream	2029	23	55 200	60 728
Downstream	2306	19	45 600	51 682

*The Bridge and Approach Rail Fabricator will determine all other locations for expansion joints

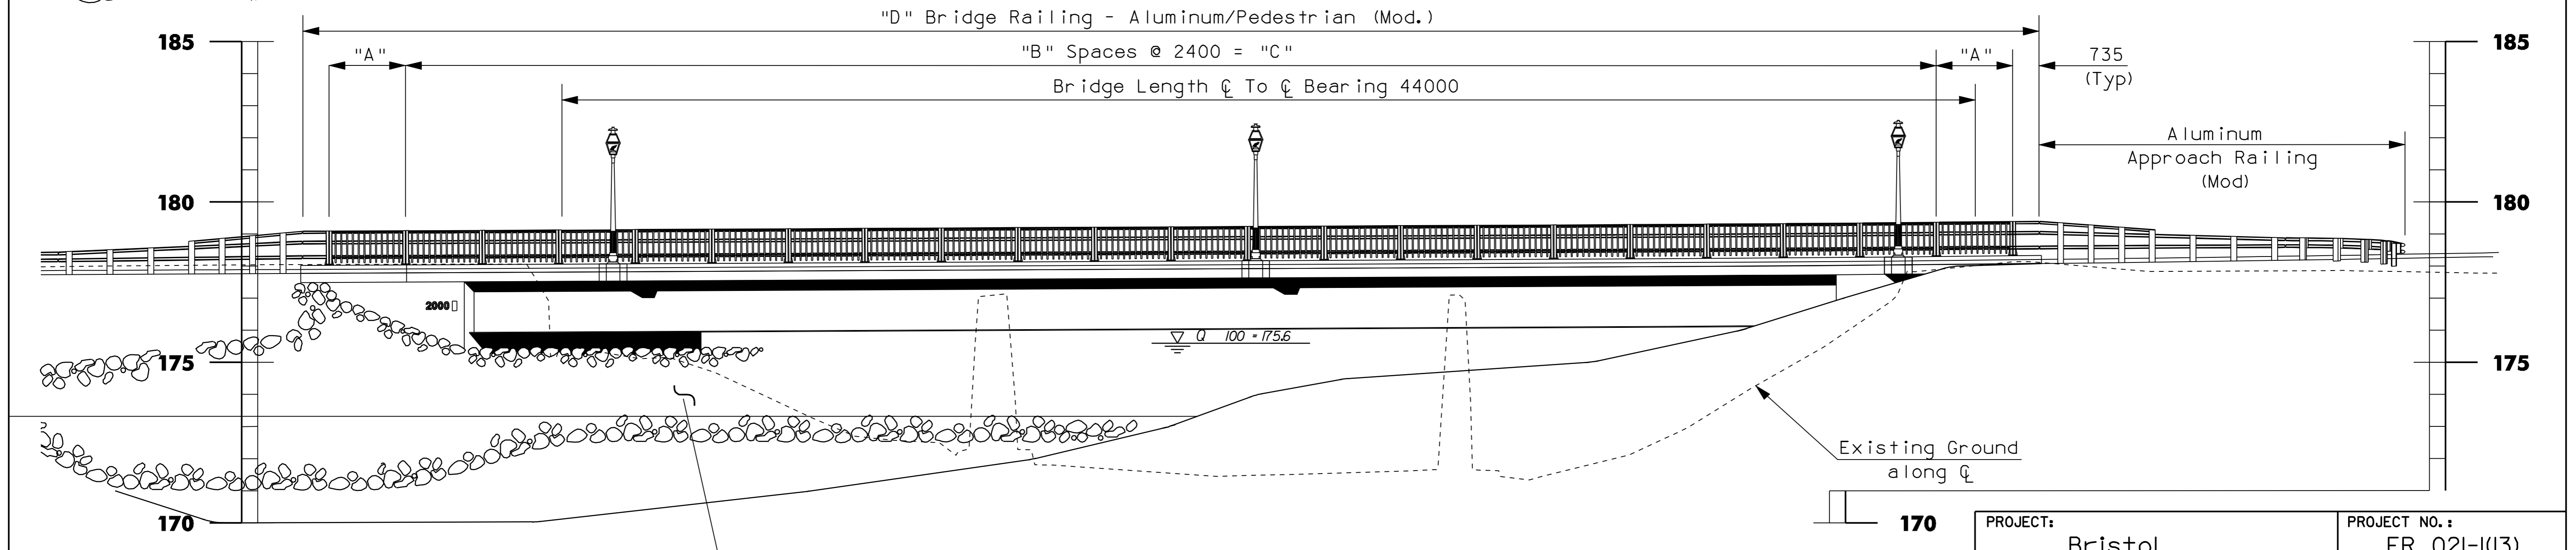

ELEVATION
Scale: 1:100

DATUM

VERTICAL	_____
HORIZONTAL	_____

PROJECT:	Bristol	PROJECT NO.:	ER 021-1(13)
DESIGN FILE NAME:	/str2/78f188/sf188pe.dgn	IPARM FILE NAME:	sf188pe.l
SURVEYED BY:		SQUAD LEADER:	Alec Portalupi
		DRAWN BY:	G.Colgrove
			VT 116 Over The New Haven River
		PLOT DATE:	05-JAN-2007
		SURVEY DATE:	
		DRAWN BY:	G.Colgrove
		SHEET:	30 OF 67