

REQUIRED REINFORCING STEEL TO CONSTRUCTION JOINT

28	A16M01
96	A16M02
125	A32M01


FINAL PLACEMENT ABOVE CONSTRUCTION JOINT

22	A16M01
48	A16M02
15	A16M03
40	A16M04
42	A19M01
5	A25M01
5	A25M02
42	A25M03

Plan Elevation

Abutment #2

Scale 1:50

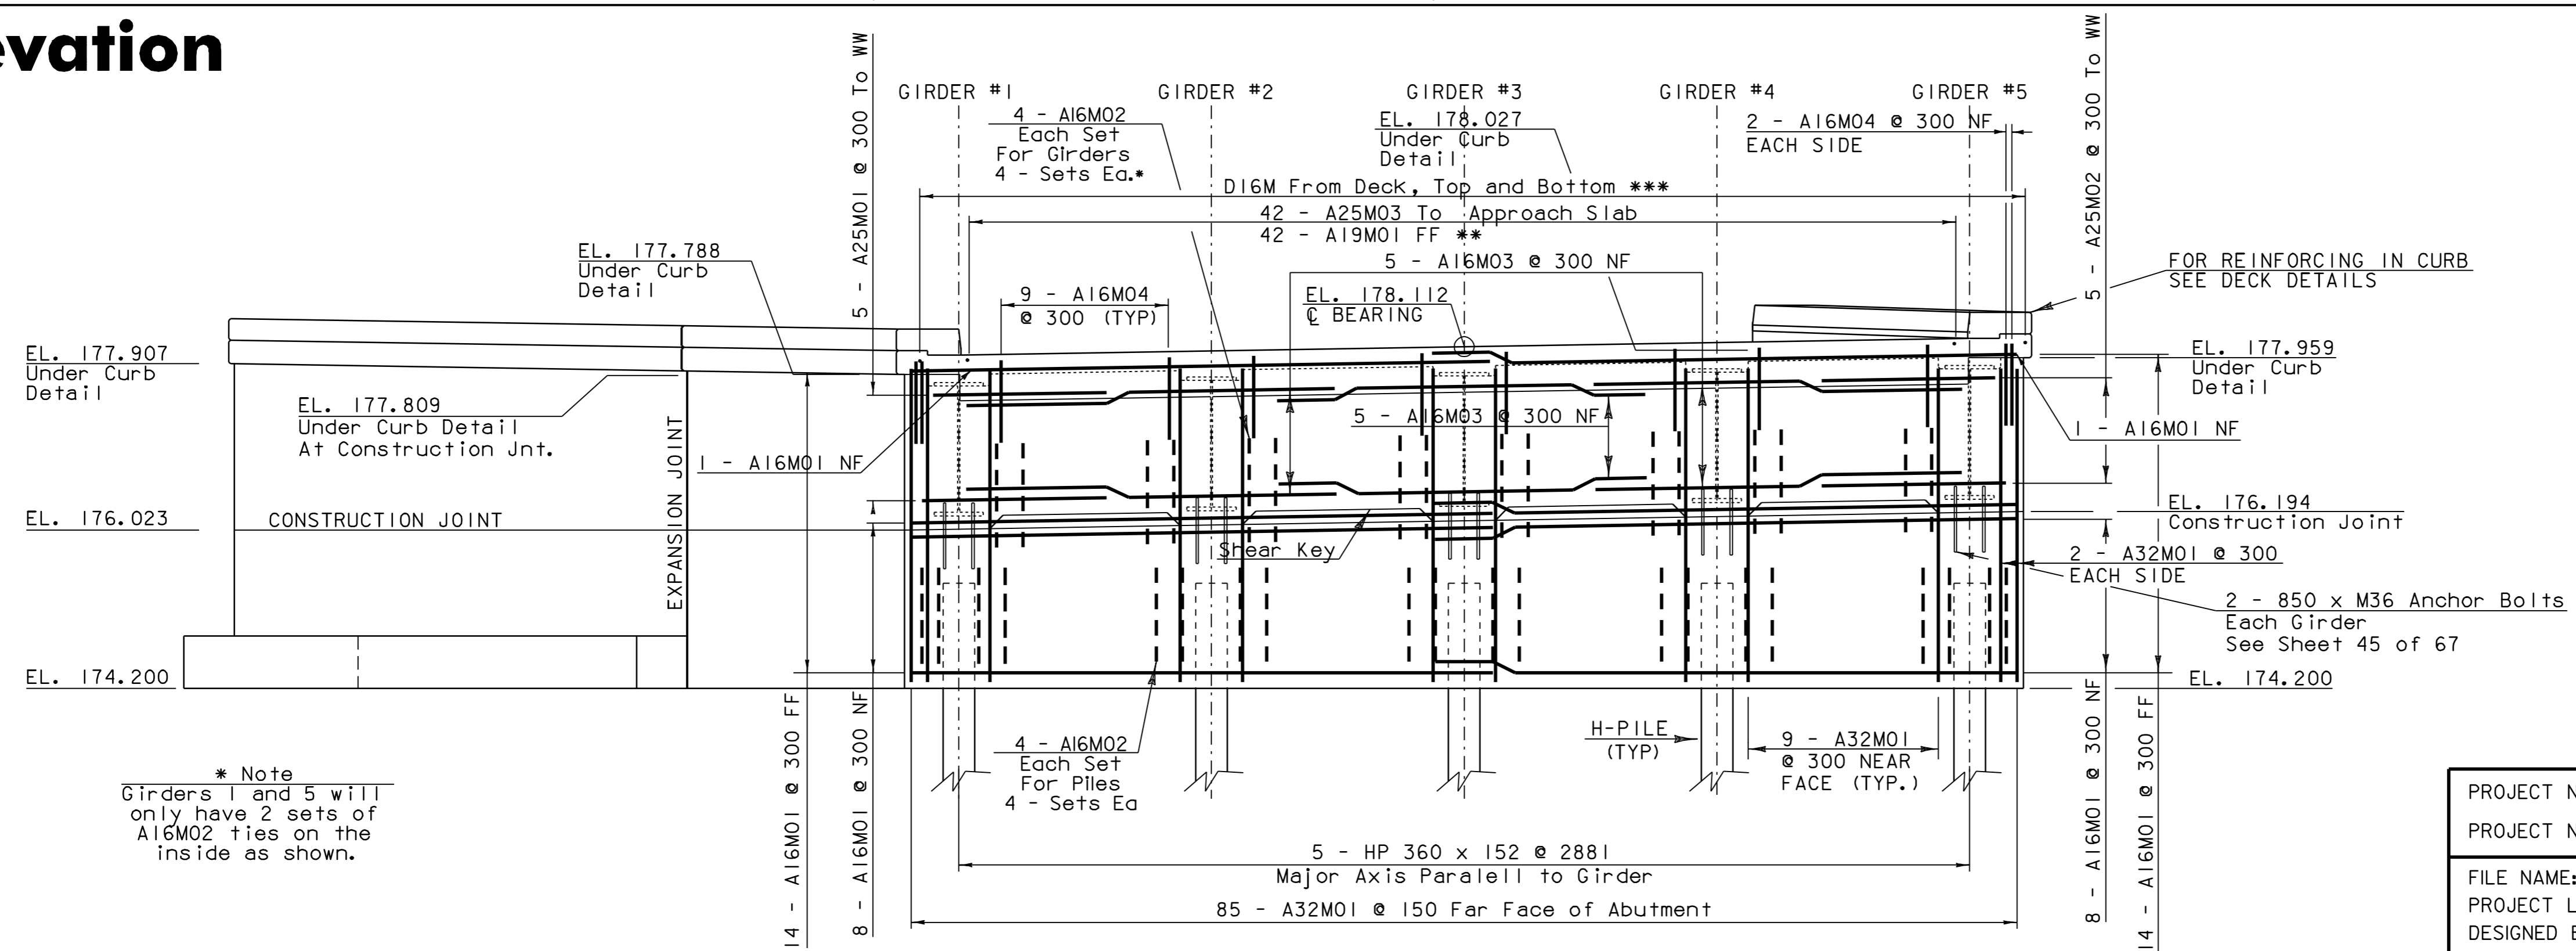

** NOT SHOWN - SEE END BRIDGE DETAILS SHEET 45 OF 67
 *** SEE END BRIDGE & DECK REINFORCING DETAILS SHEET 45 OF 67

* Note
 Girders 1 and 5 will only have 2 sets of A16M02 ties on the inside as shown.

PROJECT NAME:	BRISTOL	PLOT DATE:	05-JAN-2007
PROJECT NUMBER:	ER 021-(13)	DRAWN BY:	G. COLGROVE
FILE NAME:	/str2/78f188/sf188ww.dgn	CHECKED BY:	
DESIGNED BY:	G. COLGROVE	SHEET	47 OF 67
sfl88ab2.1			