



Footings Plan

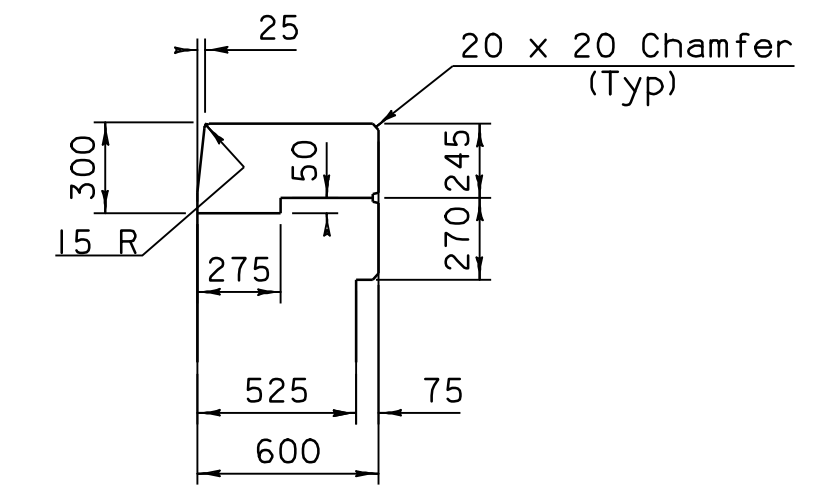

Wing Wall/Retaining Wall Curb Detail

NTS


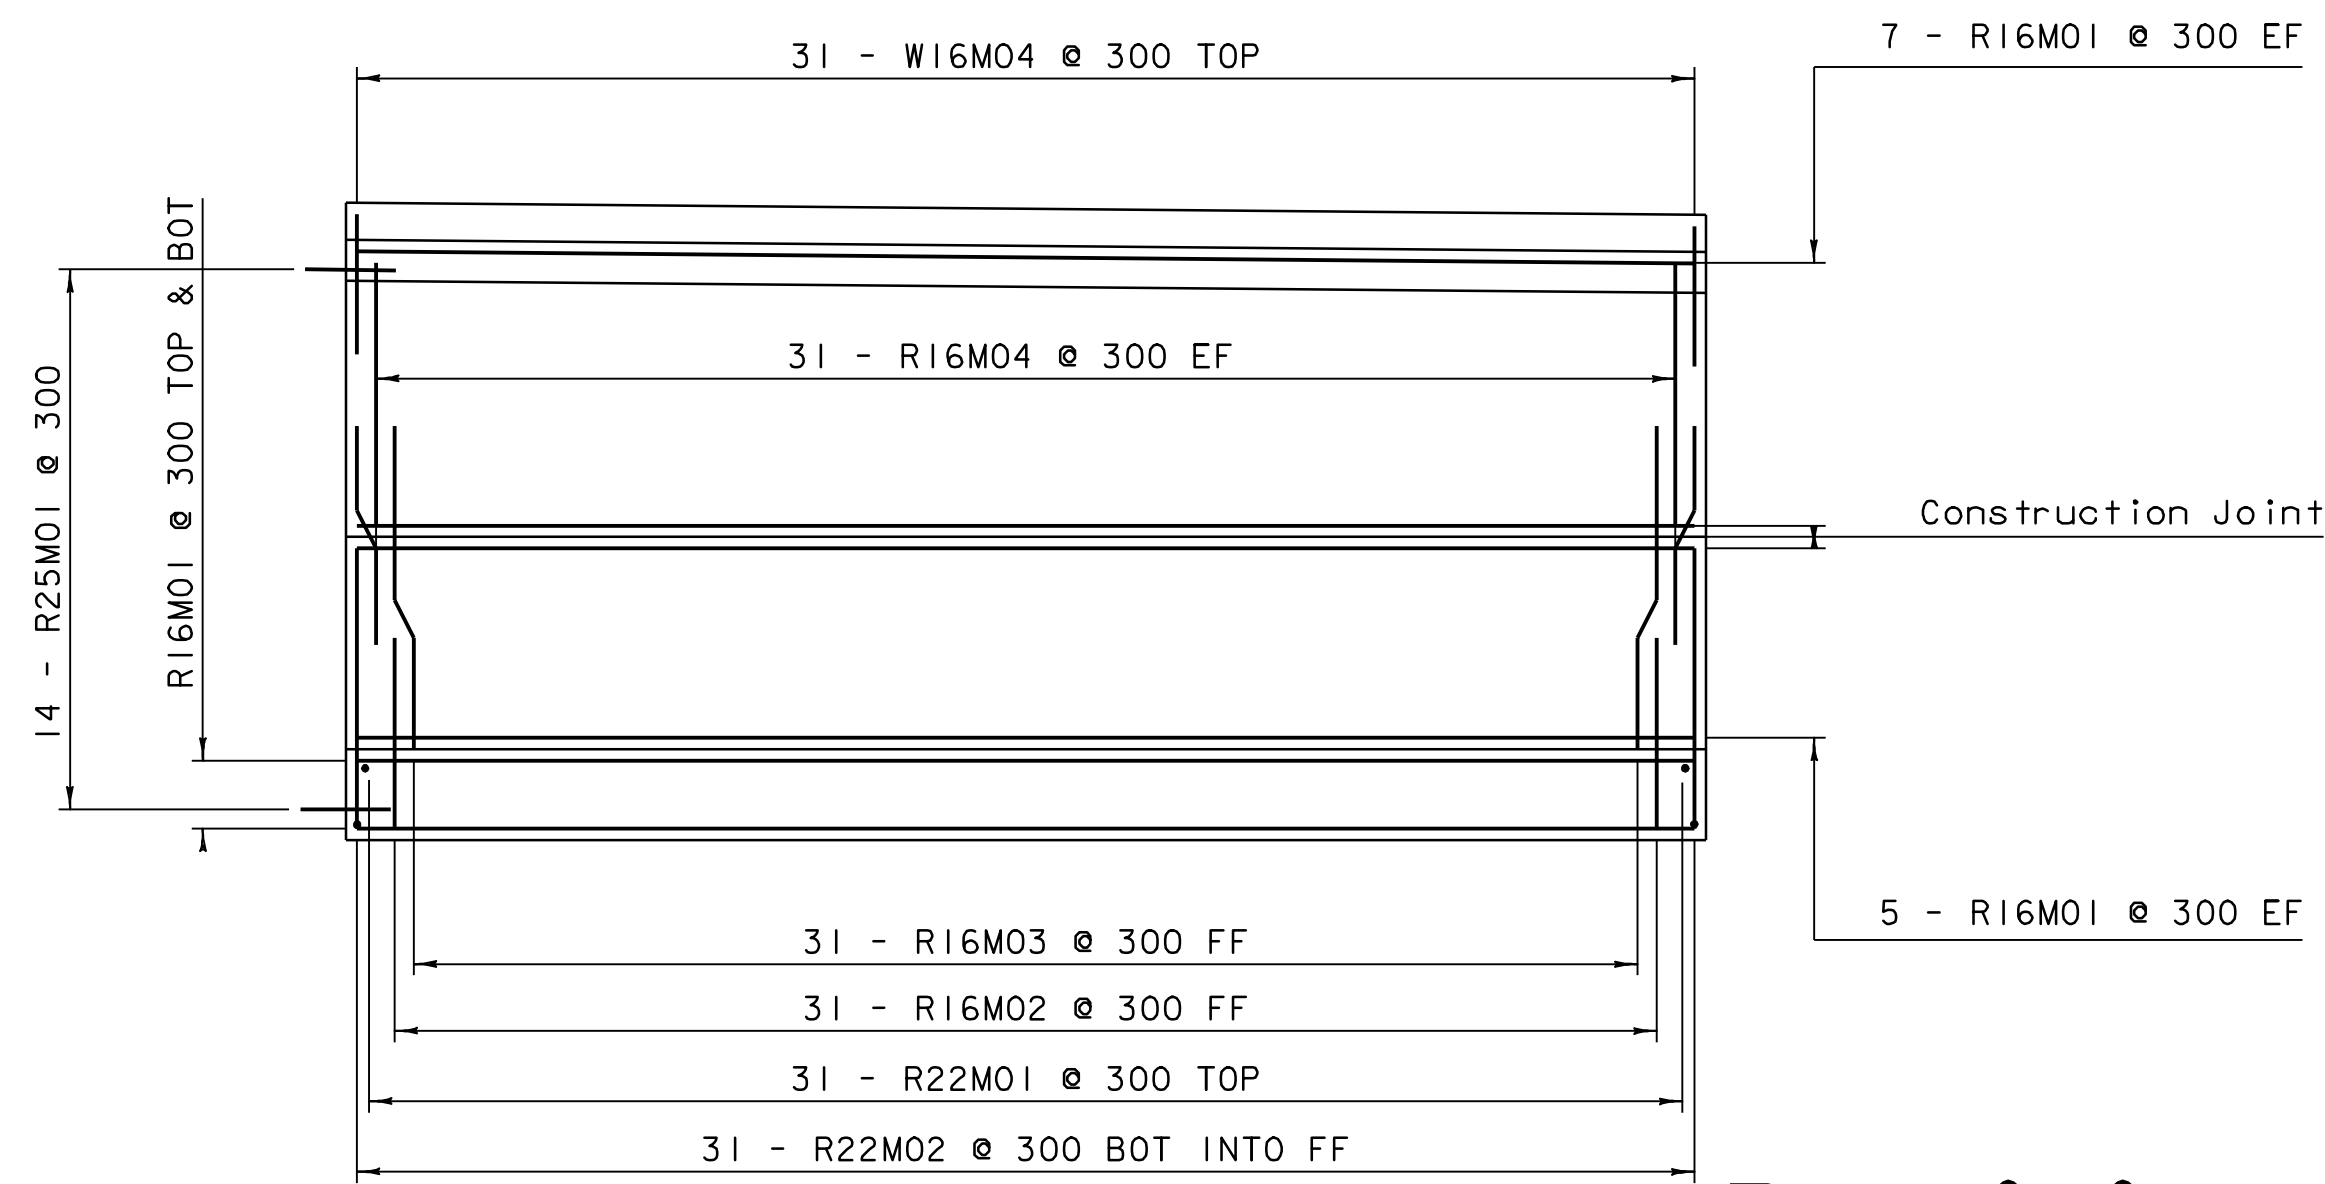


Retaining Wall

Elevation

Section Typical

Scale 1:50

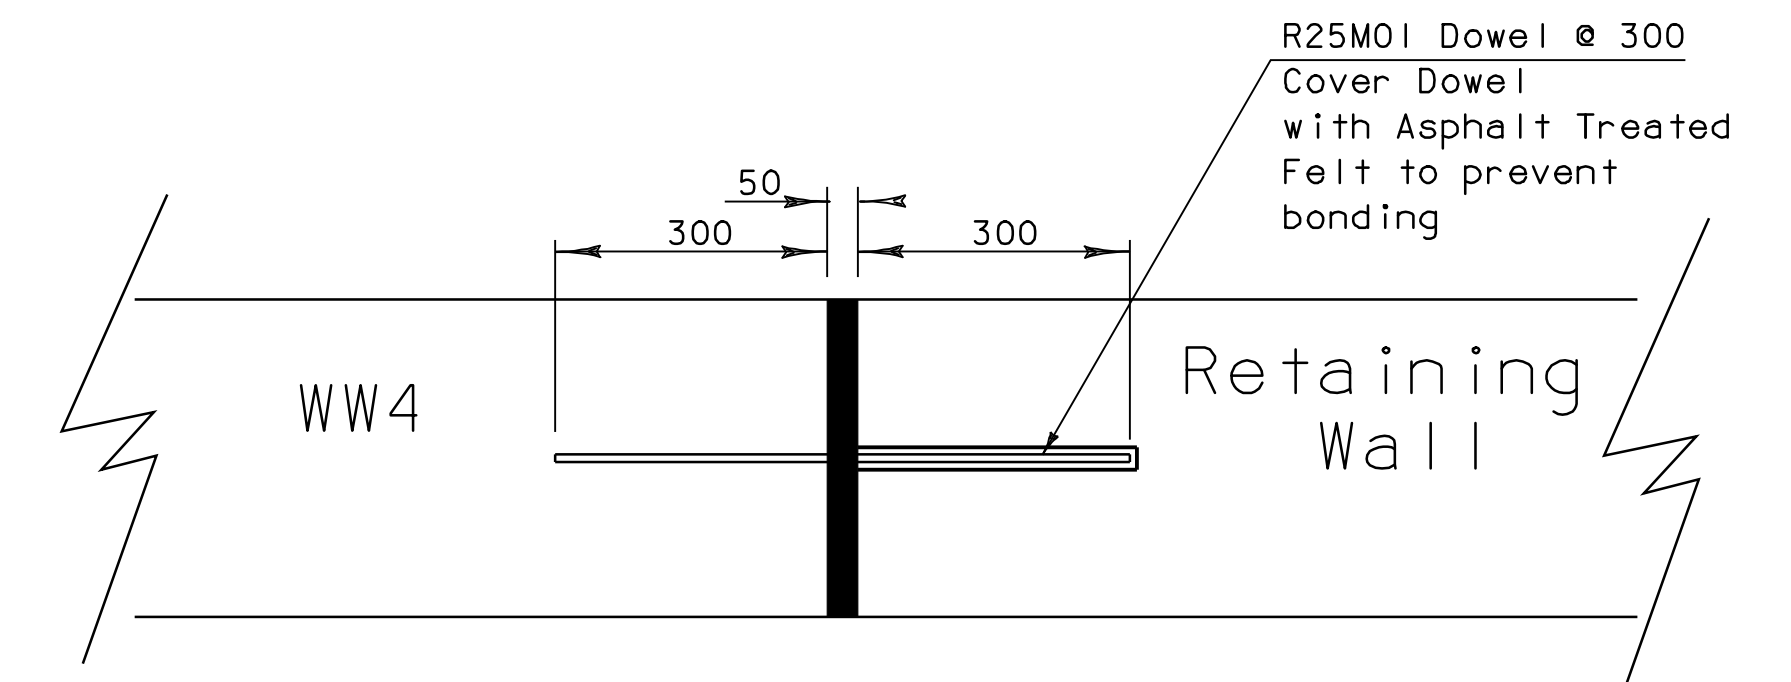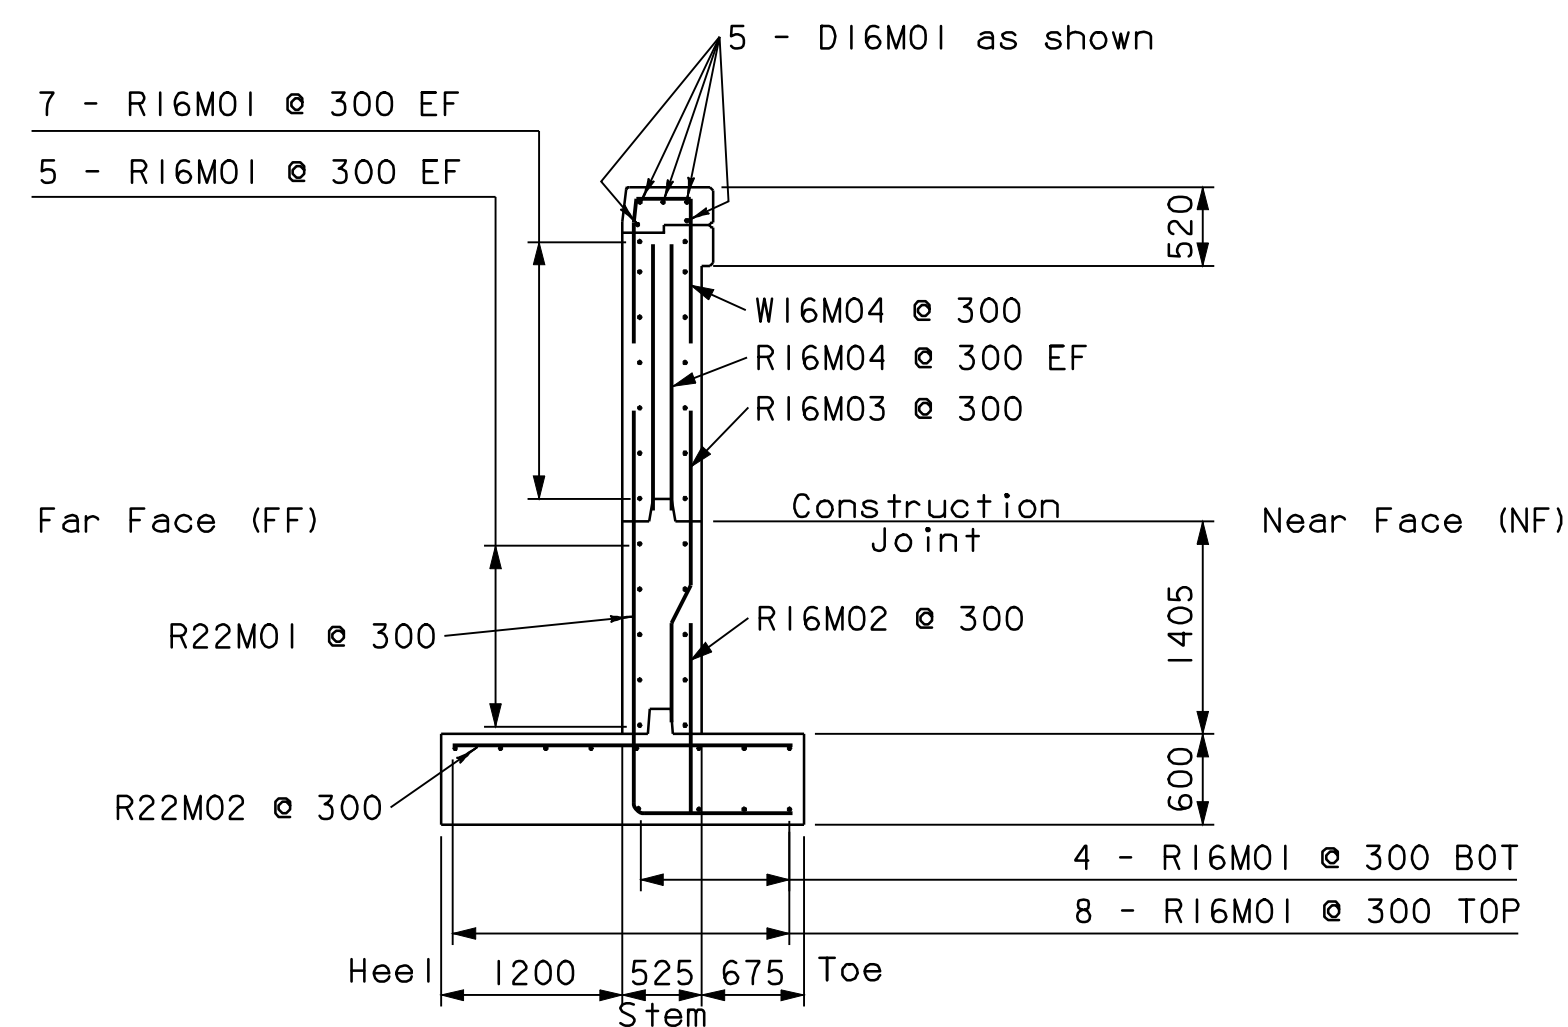

Expansion Joint between Wing Wall and Retaining Wall

NTS

REINFORCING STEEL REQUIRED

- 36 - R16M01
- 31 - R16M02
- 31 - R16M0
- 62 - R16M04
- 31 - W16M04
- 31 - R22M01
- 31 - R22M02
- 14 - R25M01

PROJECT NAME: Bristol
PROJECT NUMBER: ER 021-1(13)

FILE NAME: /str2/78f188/sf188ww.dgn
PROJECT LEADER: A. Portalupi
DESIGNED BY: G. Colgrove
sf188ret.l

PLOT DATE: 05-JAN-2007
DRAWN BY: G. Colgrove
CHECKED BY:
SHEET 50 OF 67