
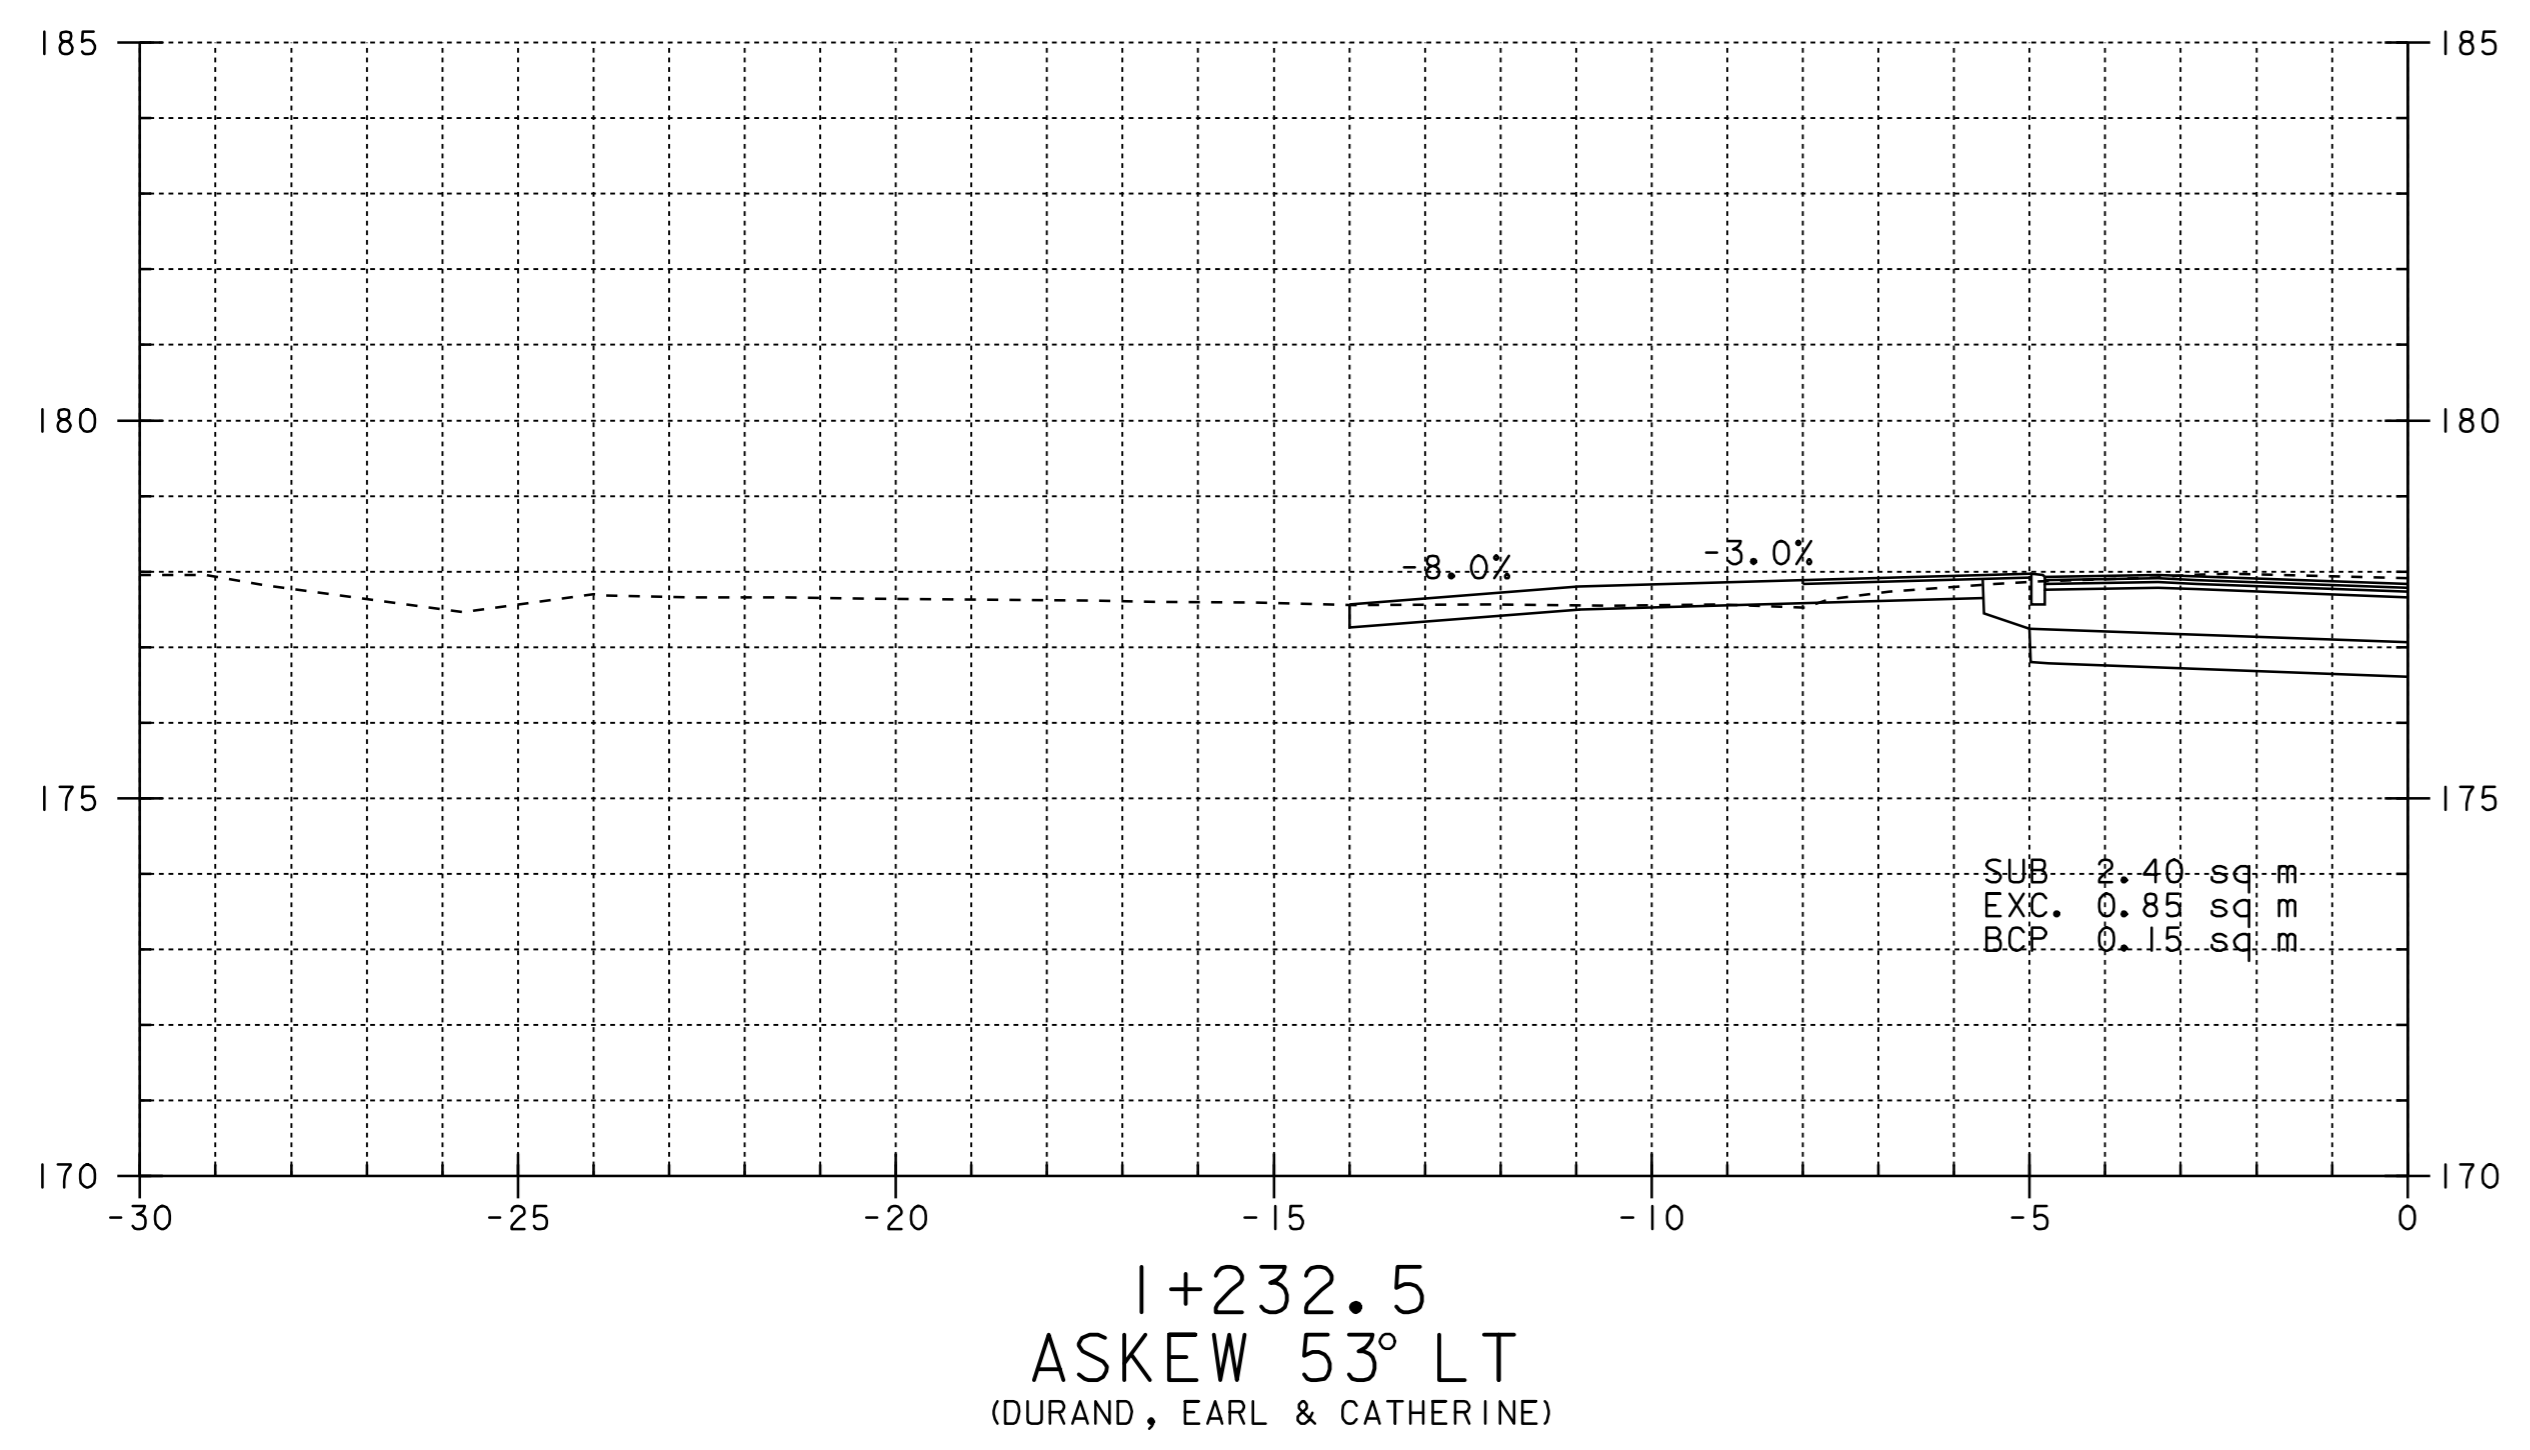


DRIVEWAY CROSS SECTIONS

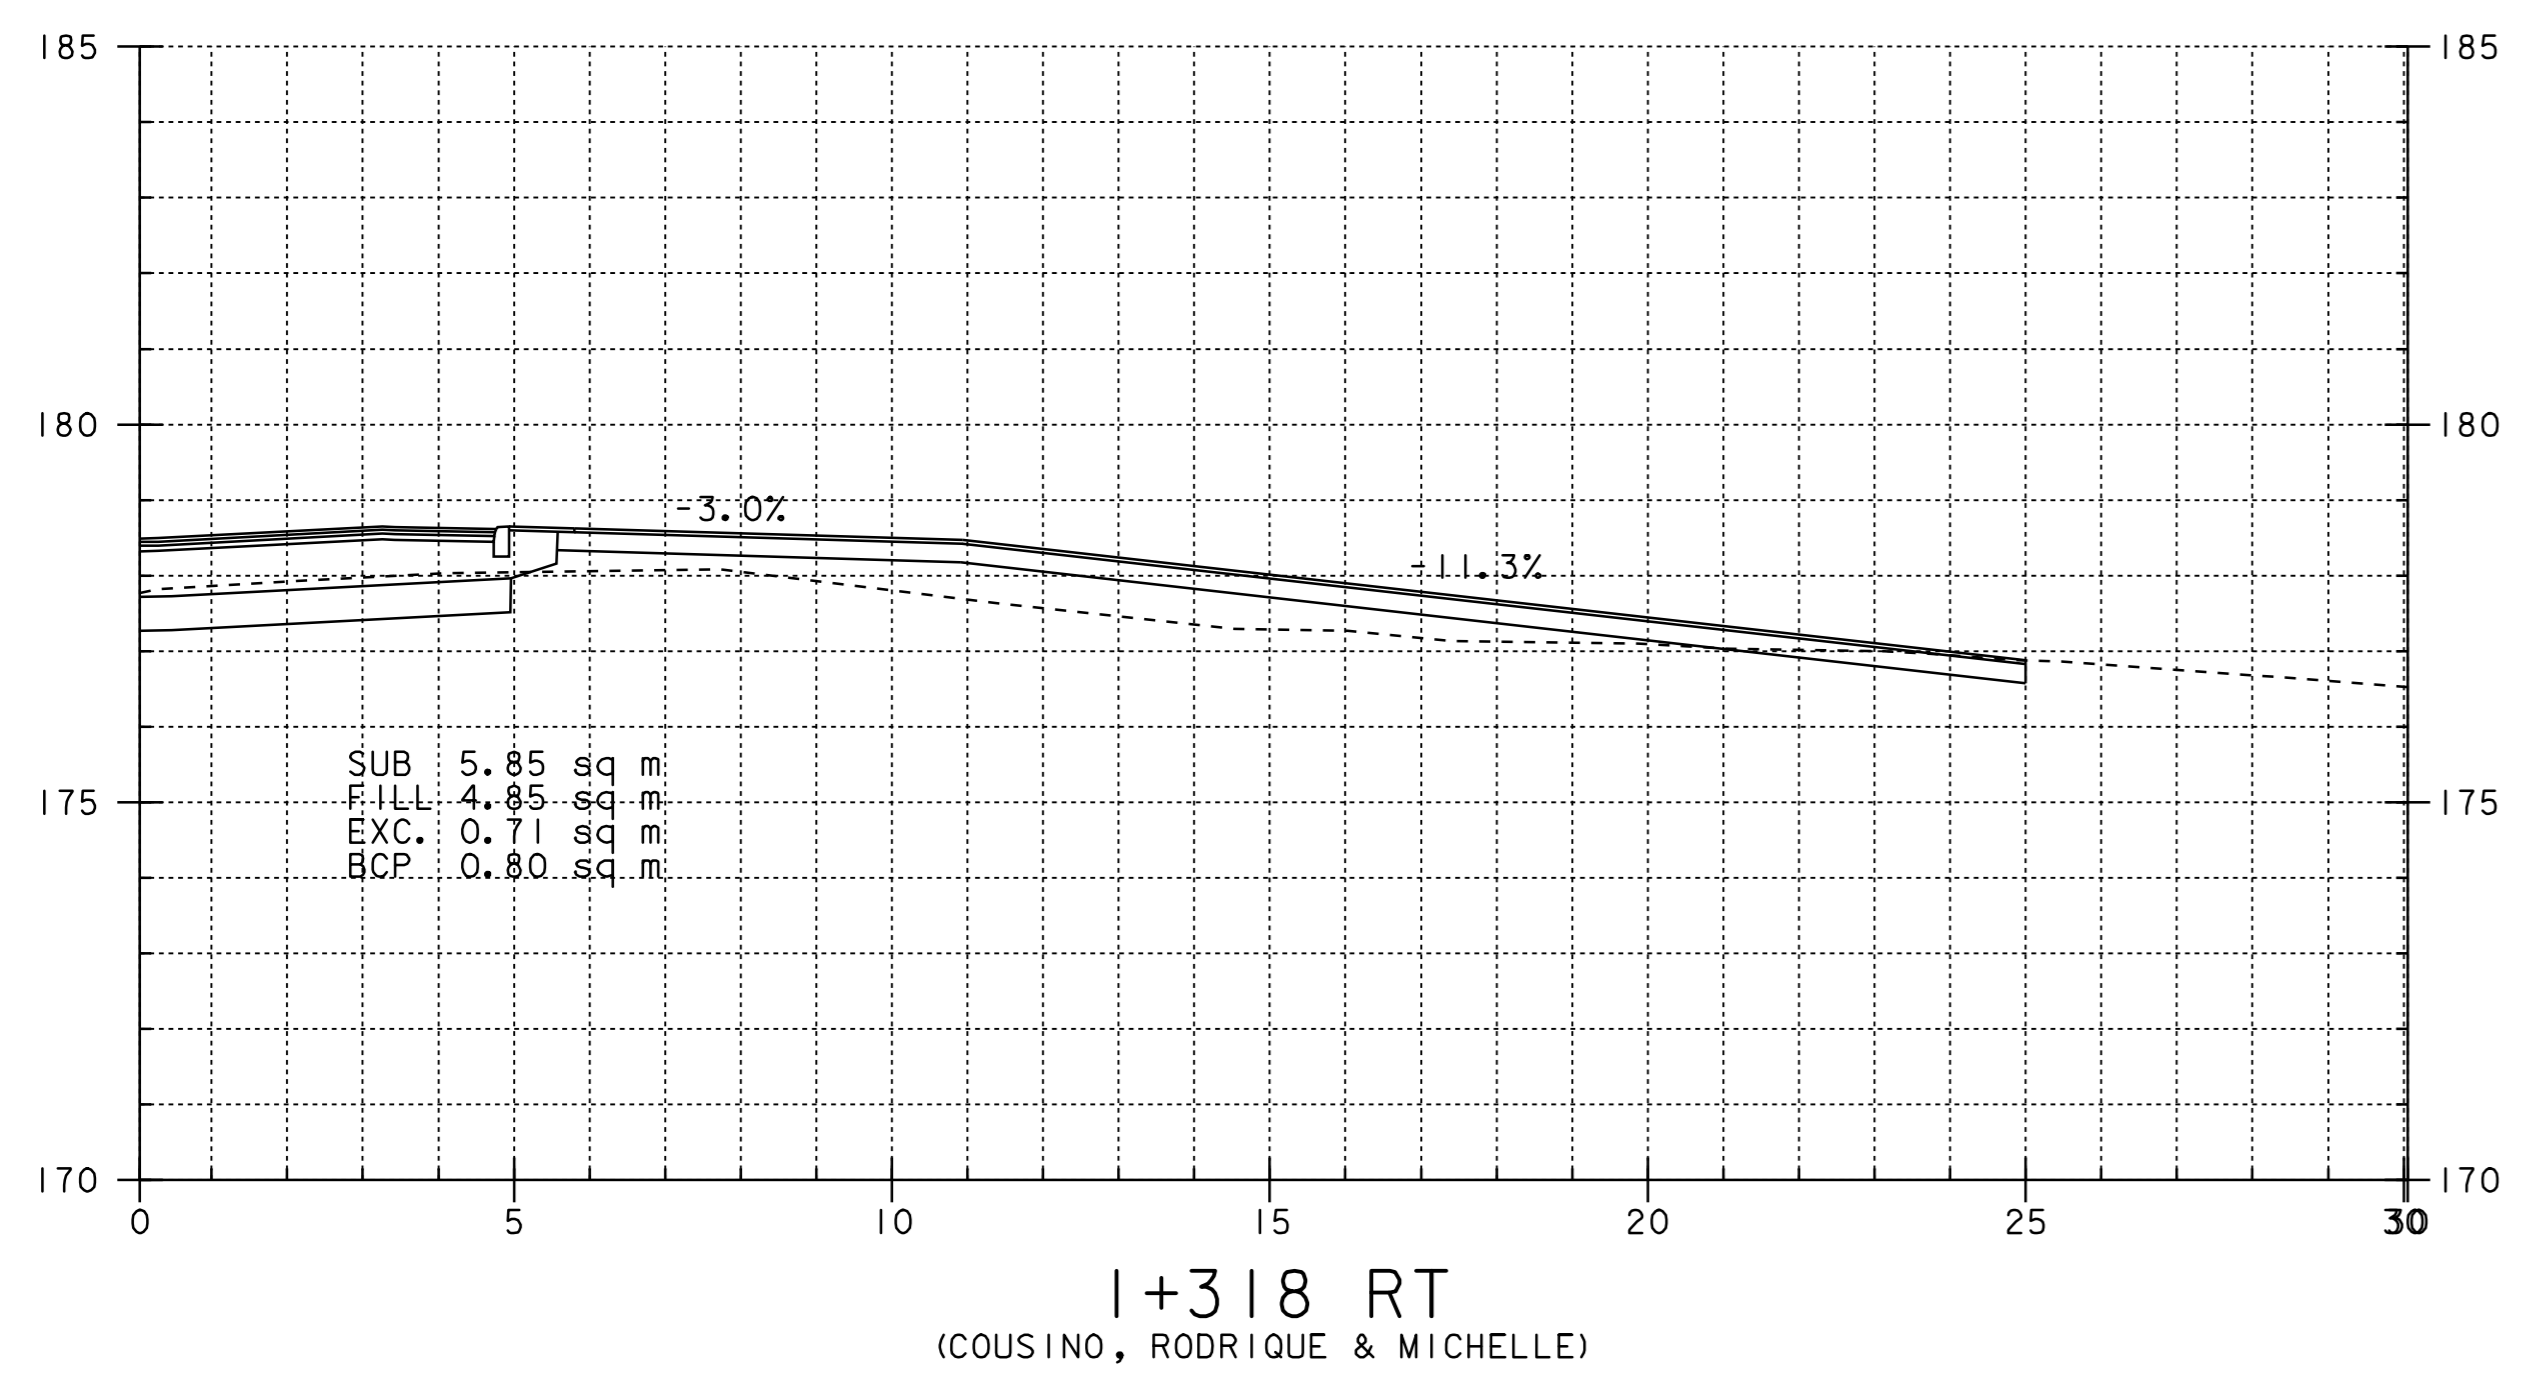

PROJECT NAME:	BRISTOL
PROJECT NUMBER:	ER 021-1(13)
FILE NAME:	str2/78f188/df188wk.dgn
PROJECT LEADER:	Portd Lupi
DESIGNED BY:	STR2
Drawn cross sections (df188x08.1)	
PLOT DATE:	05-JAN-2007
DRAWN BY:	Weeber
CHECKED BY:	
SHEET	62 OF 67