


METRIC

1. ALL DIMENSIONS ARE IN MILLIMETERS UNLESS OTHERWISE NOTED.
2. ALL WEIGHTS ARE IN KILOGRAMS.


FED. ROAD DIV. NO.	STATE	FED. AID PROJ. NO.
	VT	

BILL OF MATERIAL

NO.	MARK	DESCRIPTION	LENGTH	REMARKS	ITEM	SHIP WEIGHT EA.
ONE	G3A	GIRDER				23 900kg
1	w1	1441 x 20	27 245 (T)		1/2	
1	w2	1441 x 20	17 241 (T)		1/3	
1	t1	458 x 38	17 230 (T)		2/6	
1	t2	458 x 38	27 253 (T)		2/4	
1	b1	458 x 45	17 230 (T)		2/3	
1	b2	458 x 45	27 210 (T)		2/2	
4	x1a	188 x 25	1441		3/2	
1	x1c	188 x 14	1441		3/3	
1	x1d	188 x 14	1441		3/3	
1	x1h	188 x 14	1441		3/3	
2	x1k	188 x 14	1441		3/3	
1	x1m	188 x 14	1441		3/3	
1	x1s	188 x 14	1441		3/3	
2	x1t	188 x 14	1441		3/3	
1	x1w	188 x 14	1441		3/3	
1	x1ab	188 x 14	1441		3/3	
1	x1ac	188 x 14	1441		3/3	

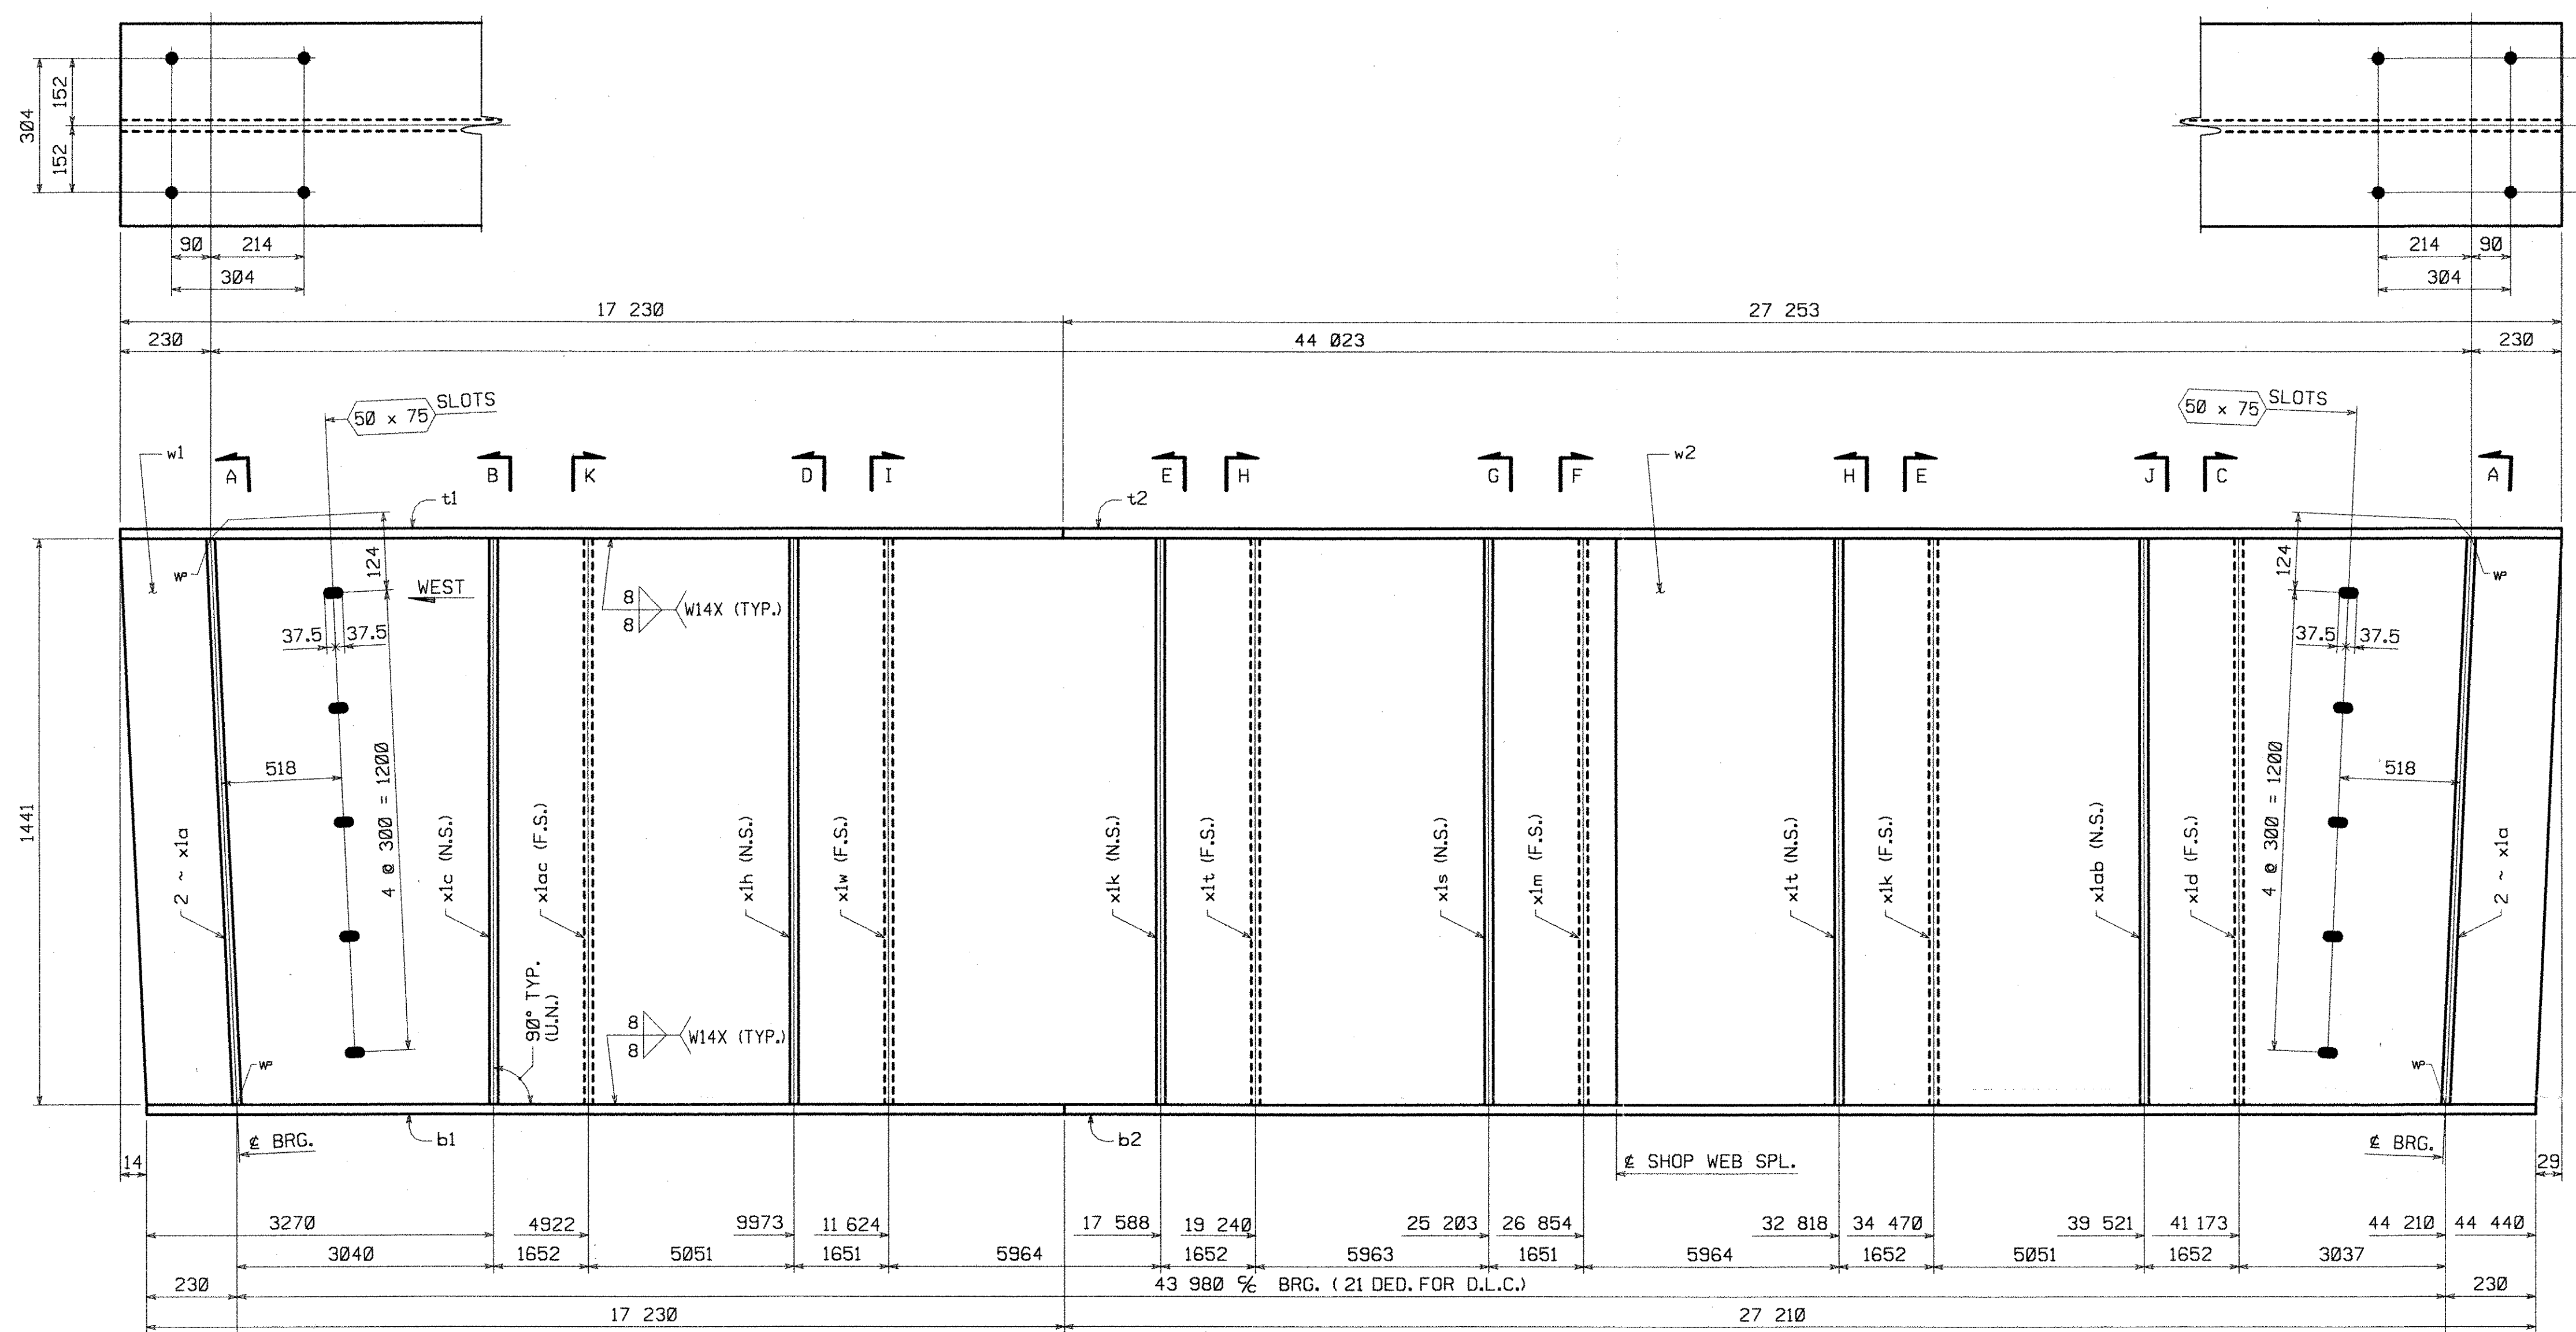

GIRDER MK. ~ G3A

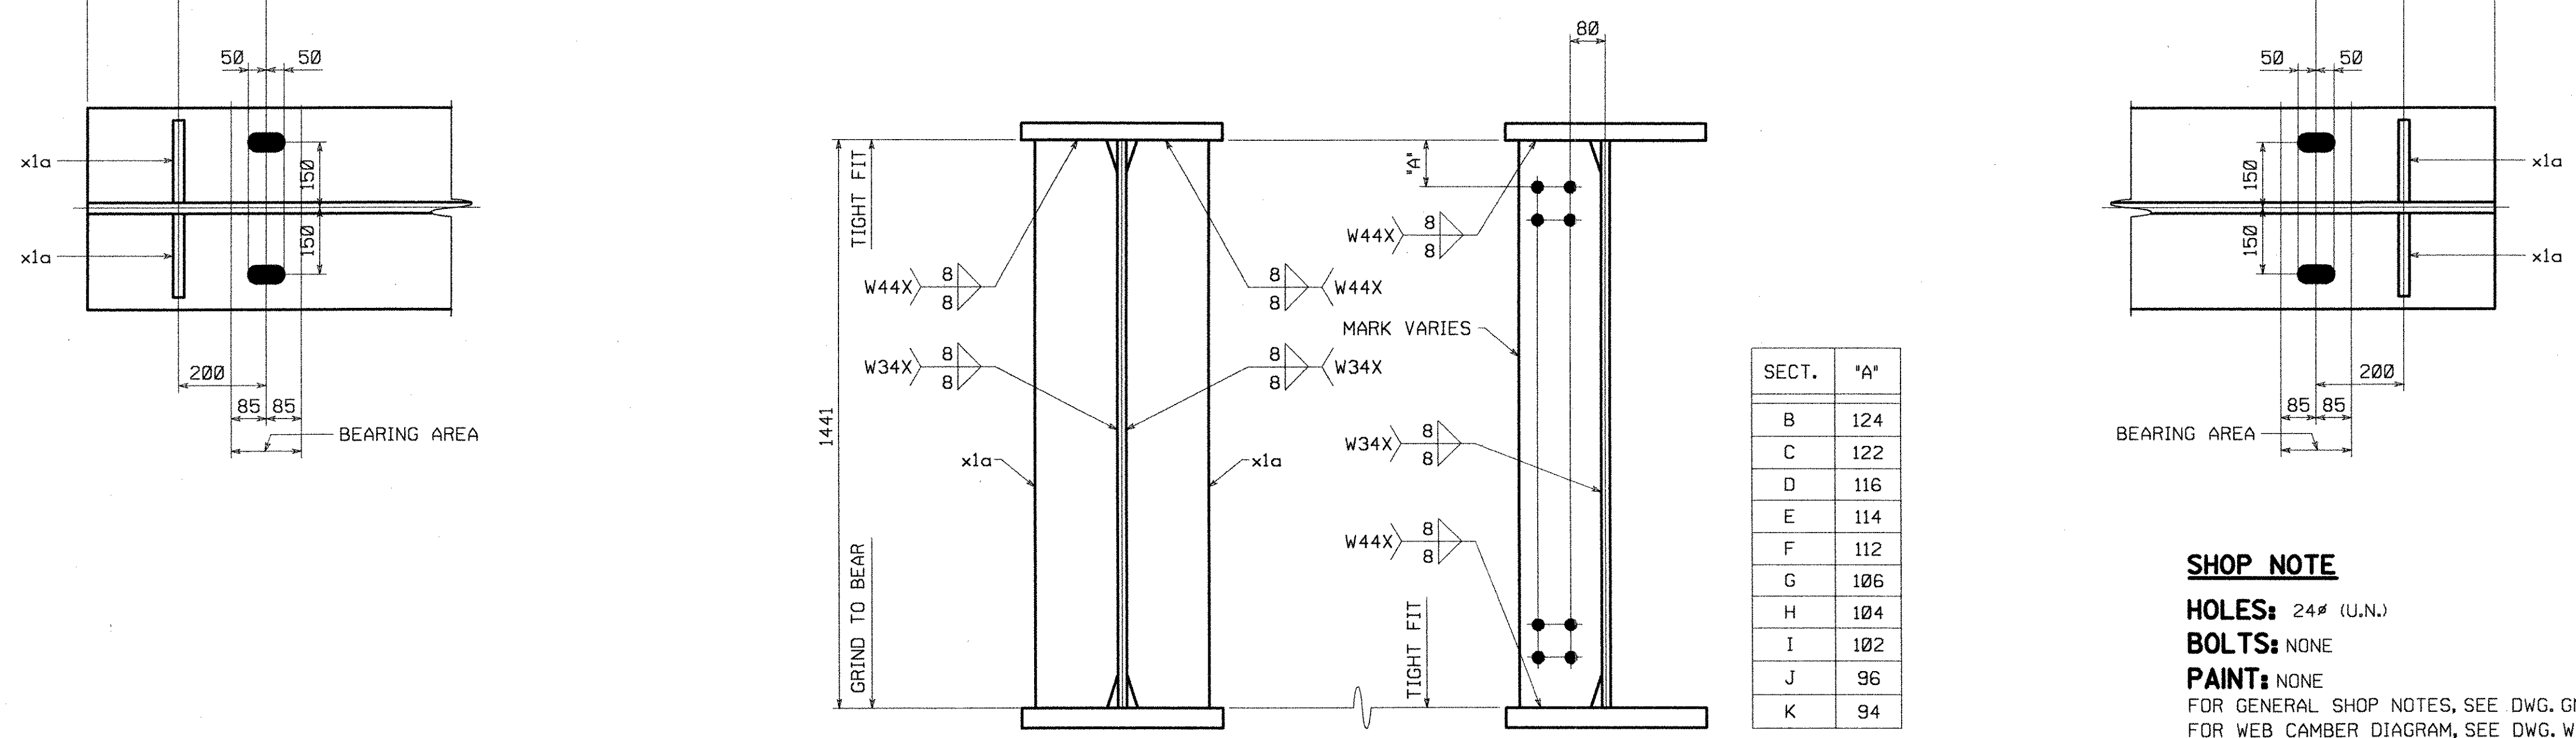

SECT.	'A'
B	124
C	122
D	116
E	114
F	112
G	106
H	104
I	102
J	96
K	94

SHOP NOTE
HOLES: 24# (U.N.)
BOLTS: NONE
PAINT: NONE
 FOR GENERAL SHOP NOTES, SEE DWG. GNI.
 FOR WEB CAMBER DIAGRAM, SEE DWG. WCI.

RECEIVED
 NOV 16 1999
 RESUBMIT APPROVED X
 DATE 12/16/99

NO.	REVISION	BY	DATE
GIRDER G3A			
VT. 116 OVER NEW HAVEN RIVER VT. 116 STA. 1+255.00 TO STA. 1+299.00 TOWN OF BRISTOL, BRIDGE NO. 10 STATE OF VERMONT AGENCY OF TRANSPORTATION			
STATE CONTRACT OR REF. NO.		PROJECT NO. ER 021-1(13)	012
CONTRACTOR BECK & BELLUCCI, INC.			
IN CHARGE: ALLEN (IH)		MADE BY: A68	CHK'D. BY: PFH DATE: 11-8-99
CONTRACT NUMBER: VT-99109-1		DRAWING NUMBER: 5 OF 7	

PLOTTED: 10 NOV 1999 14:54:23
 BY: ashua