

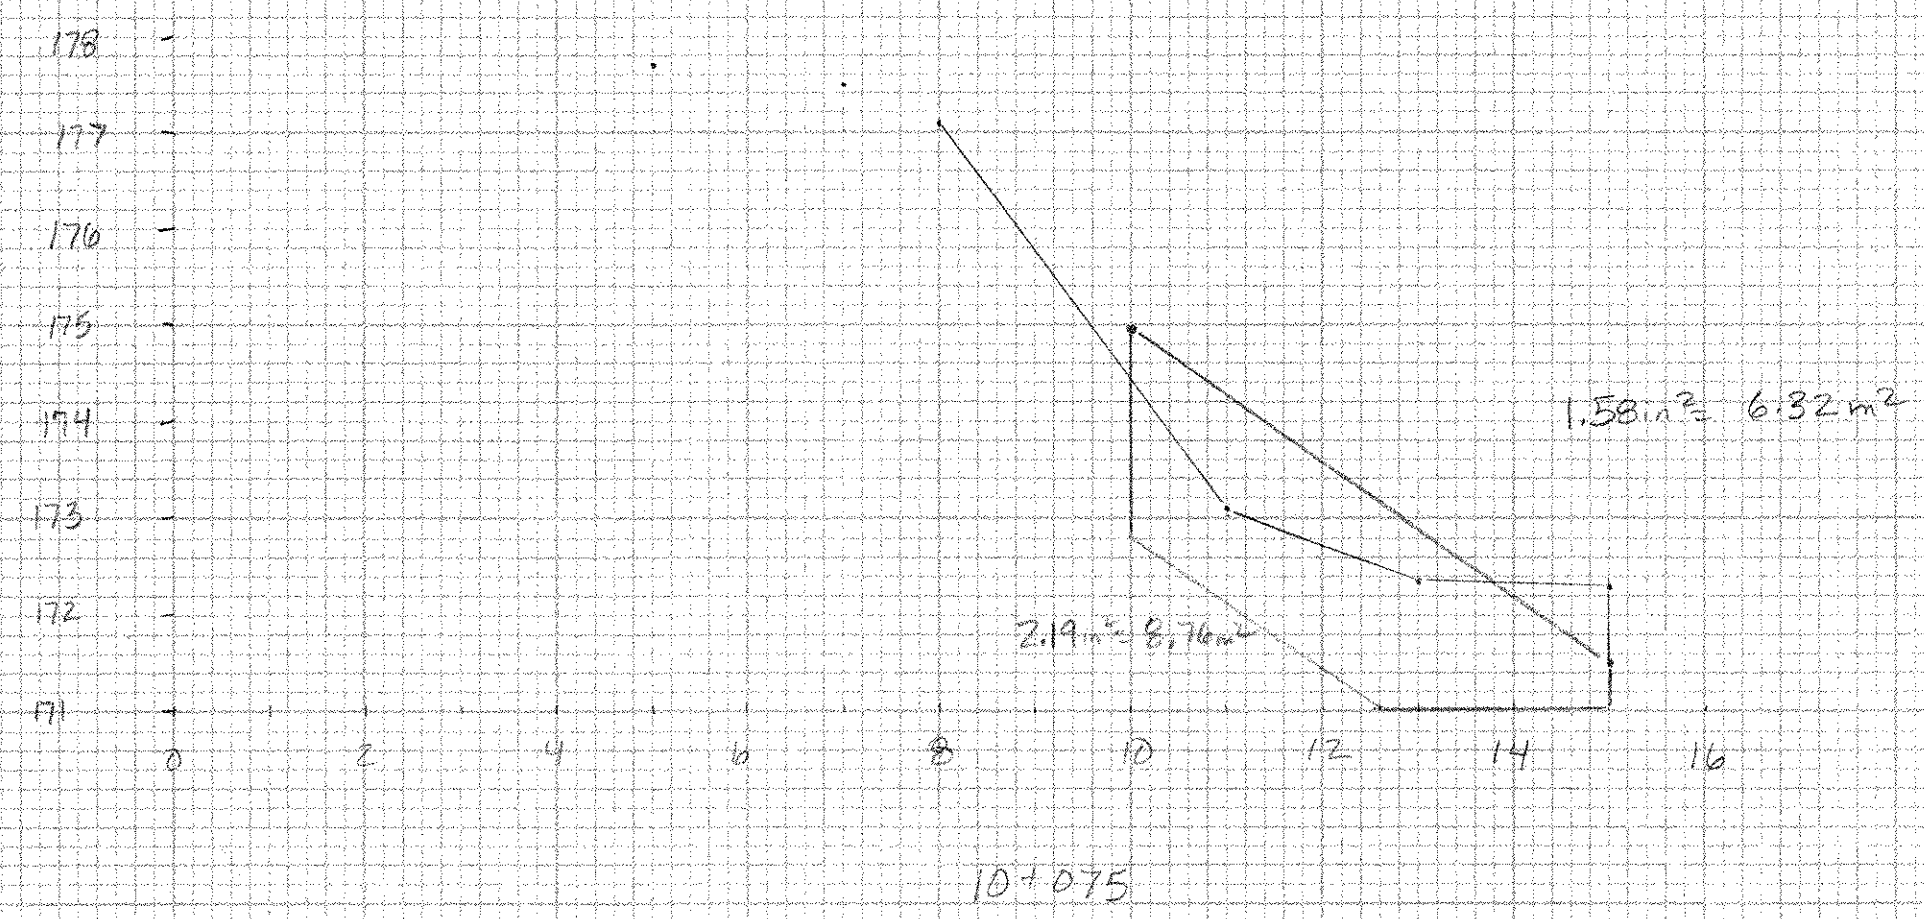


FINAL SURVEY
 DATE: _____
 BY: _____
 DRAWING NO.: _____
 SHEET NO.: _____
 PROJECT: _____
 DRAWN BY: _____
 CHECKED BY: _____
 DATE: _____

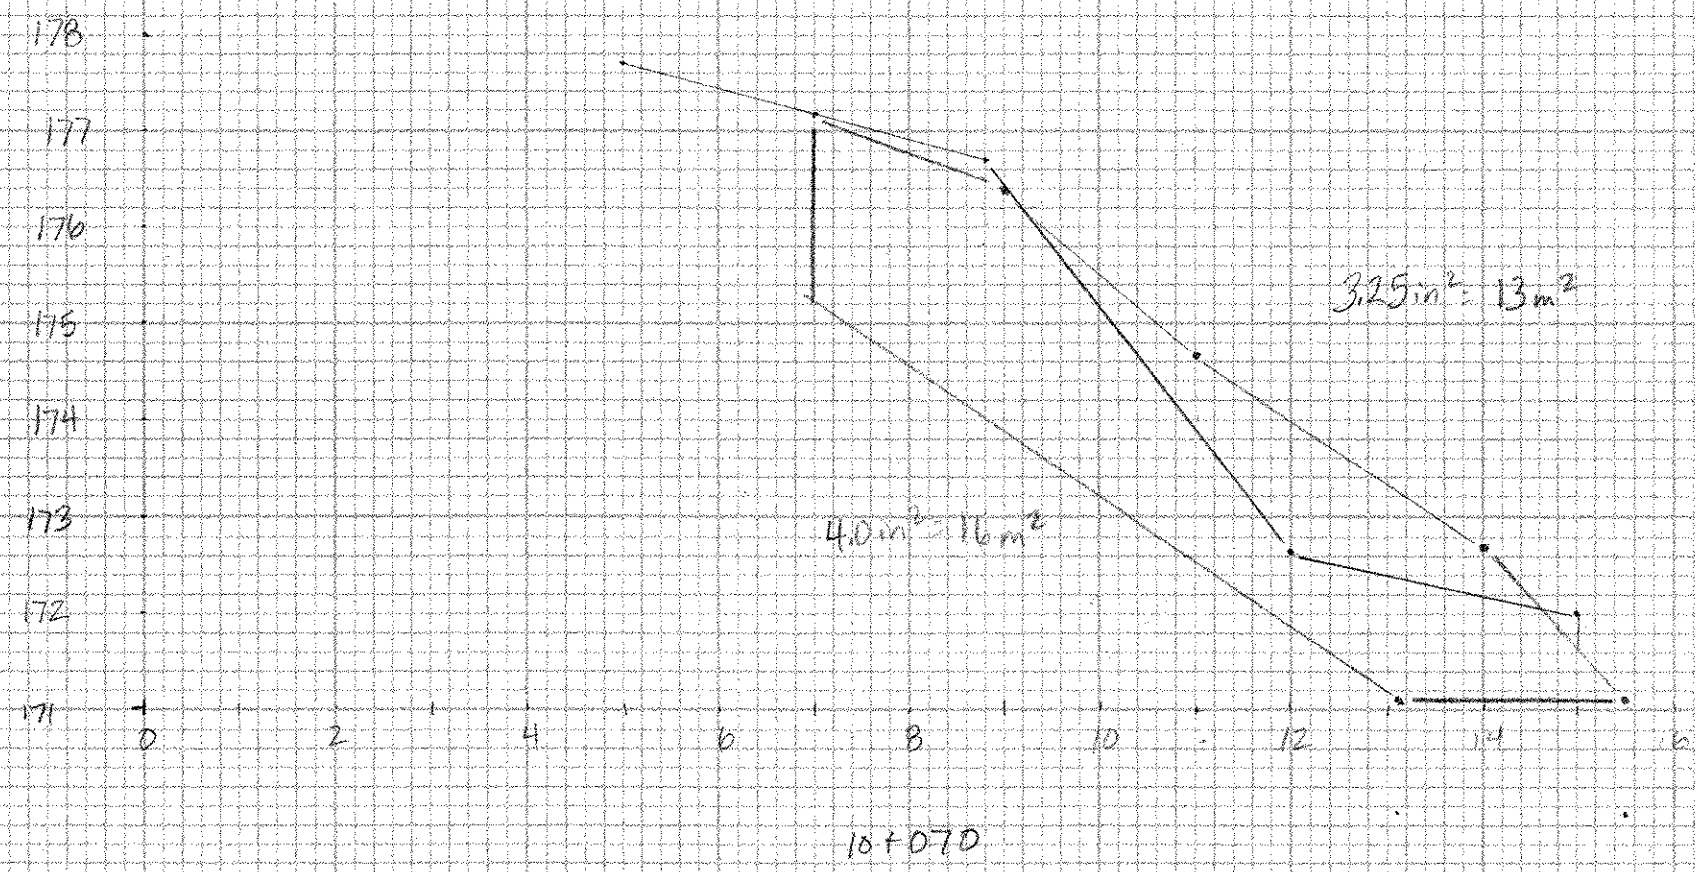

ORIGINAL SURVEY
 DATE: _____
 BY: _____
 DRAWING NO.: _____
 SHEET NO.: _____
 PROJECT: _____
 DRAWN BY: _____
 CHECKED BY: _____
 DATE: _____

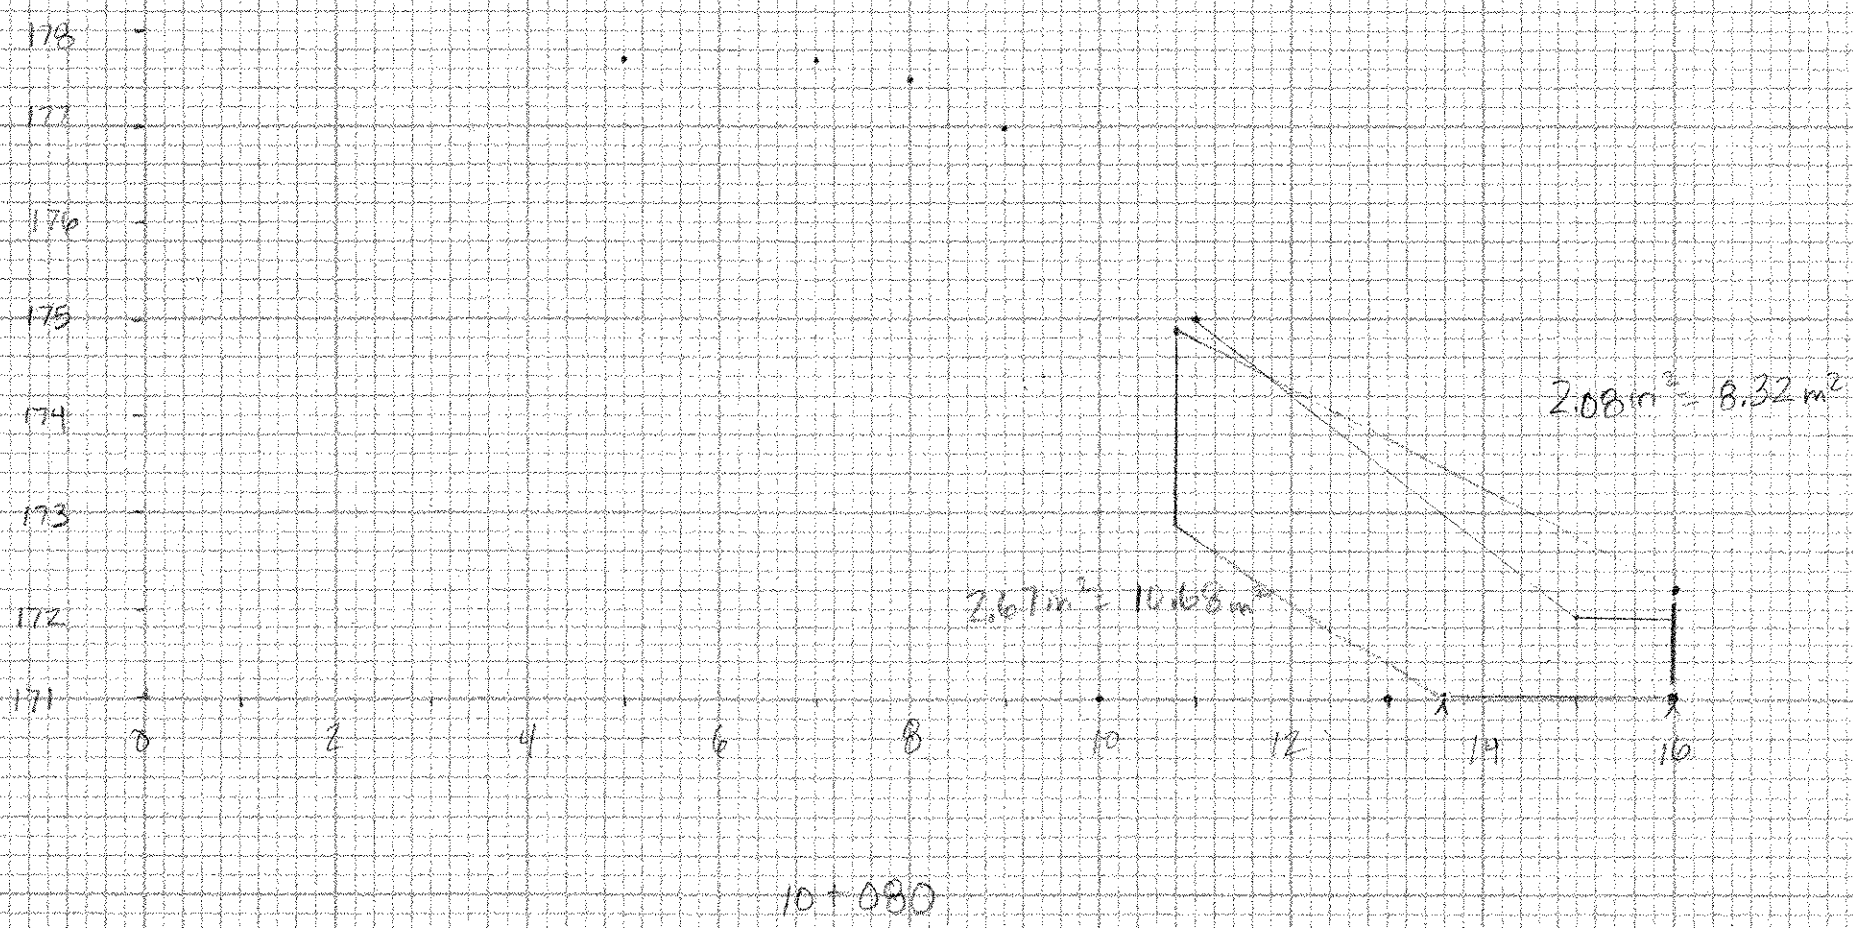

BRISTOL ER 021-1(13)
 BRIDGE #10