

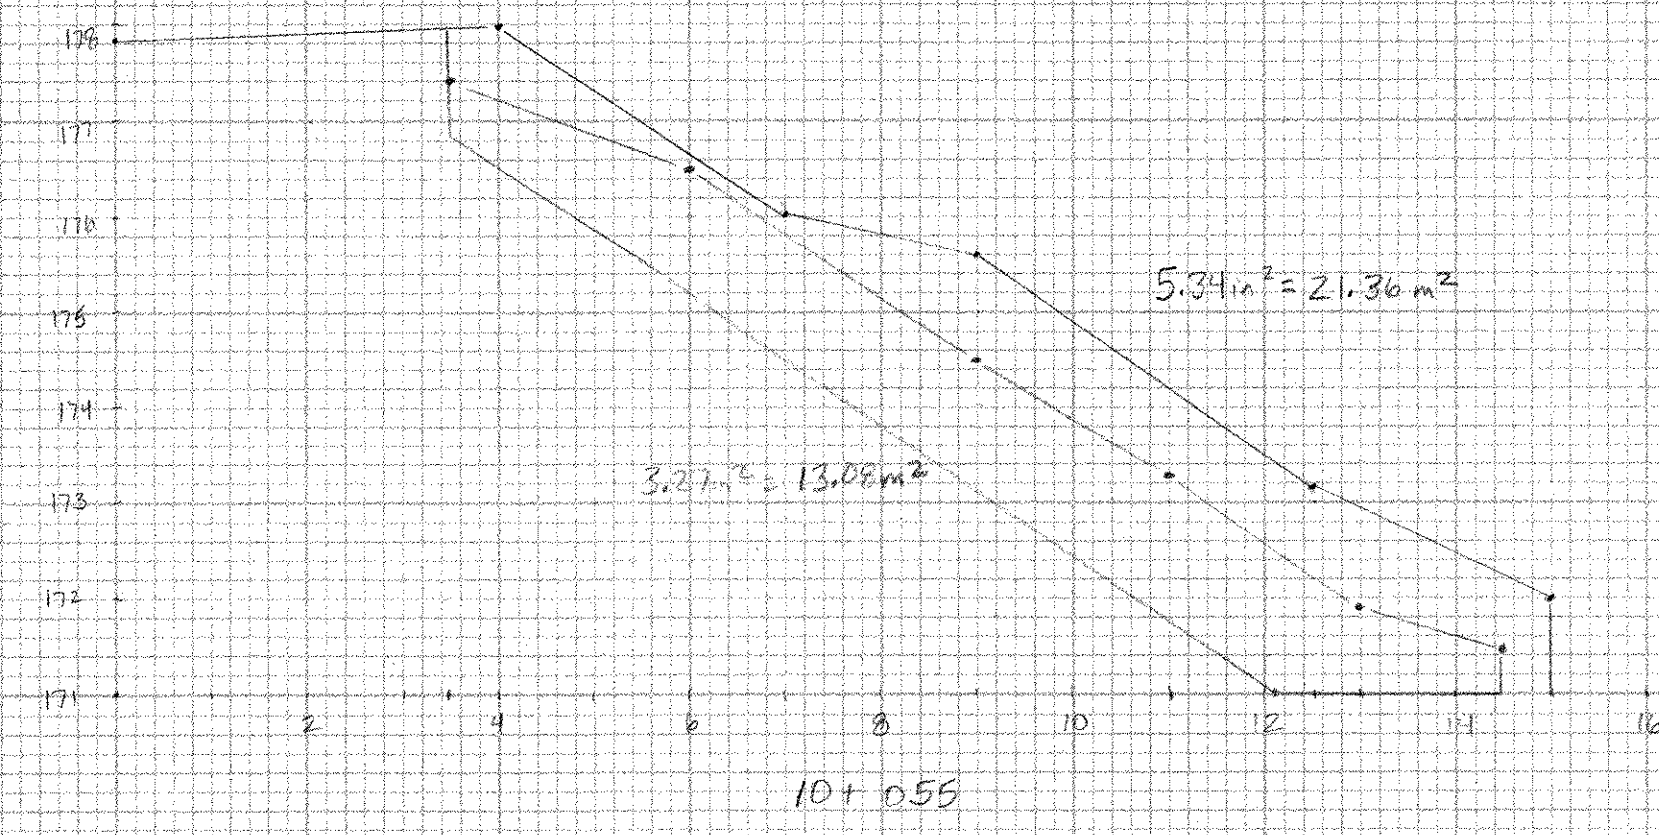
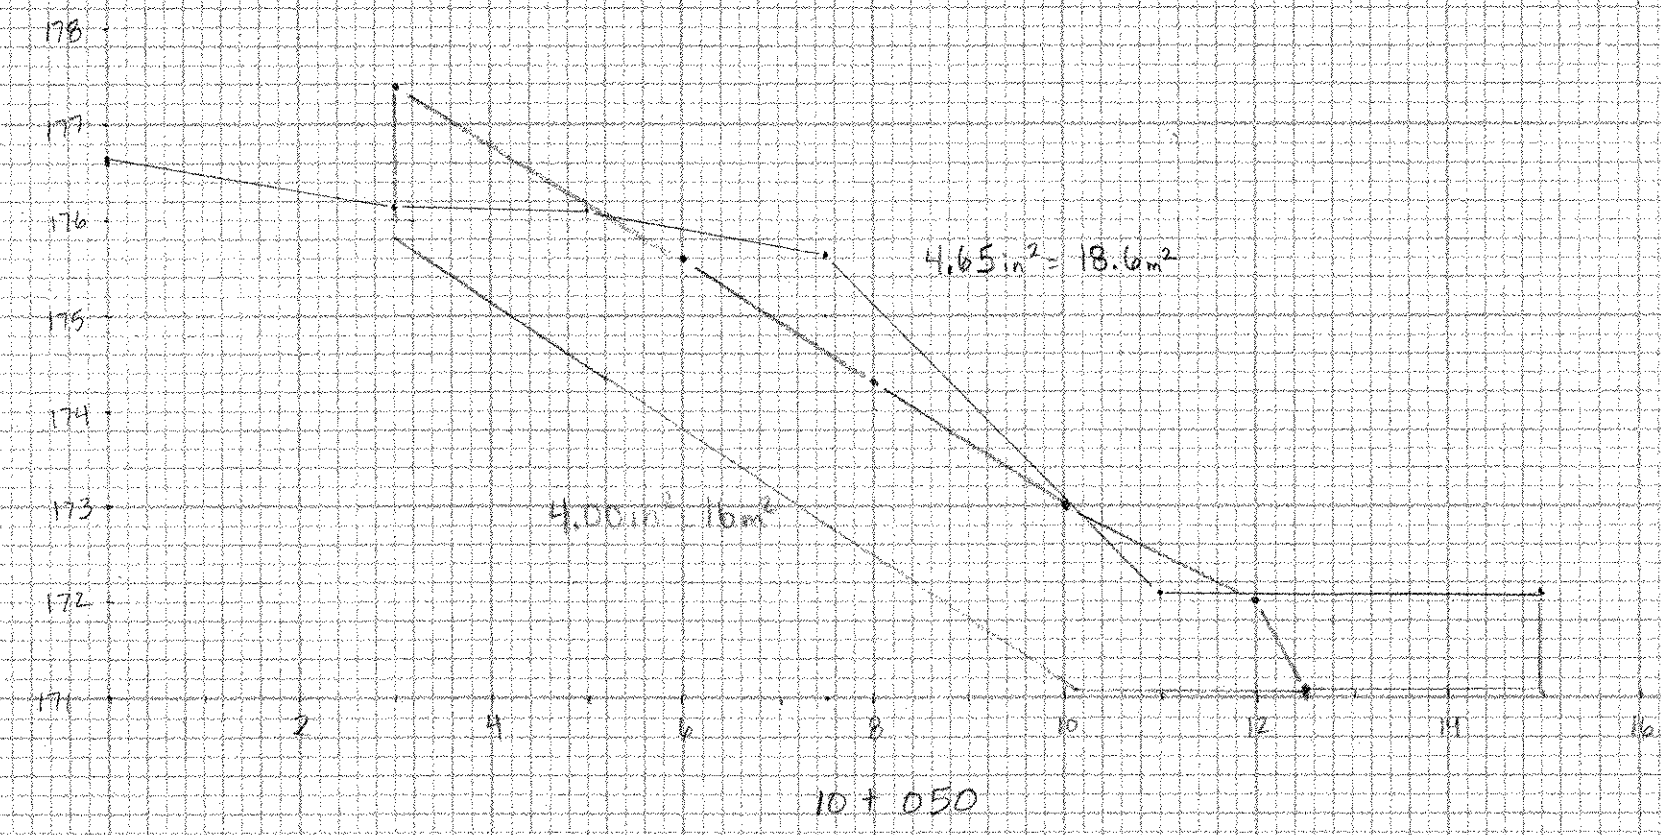


FINAL SURVEY DATE
 SURVEYED BY
 NOTE BOOK NO.
 AREA SHEETS

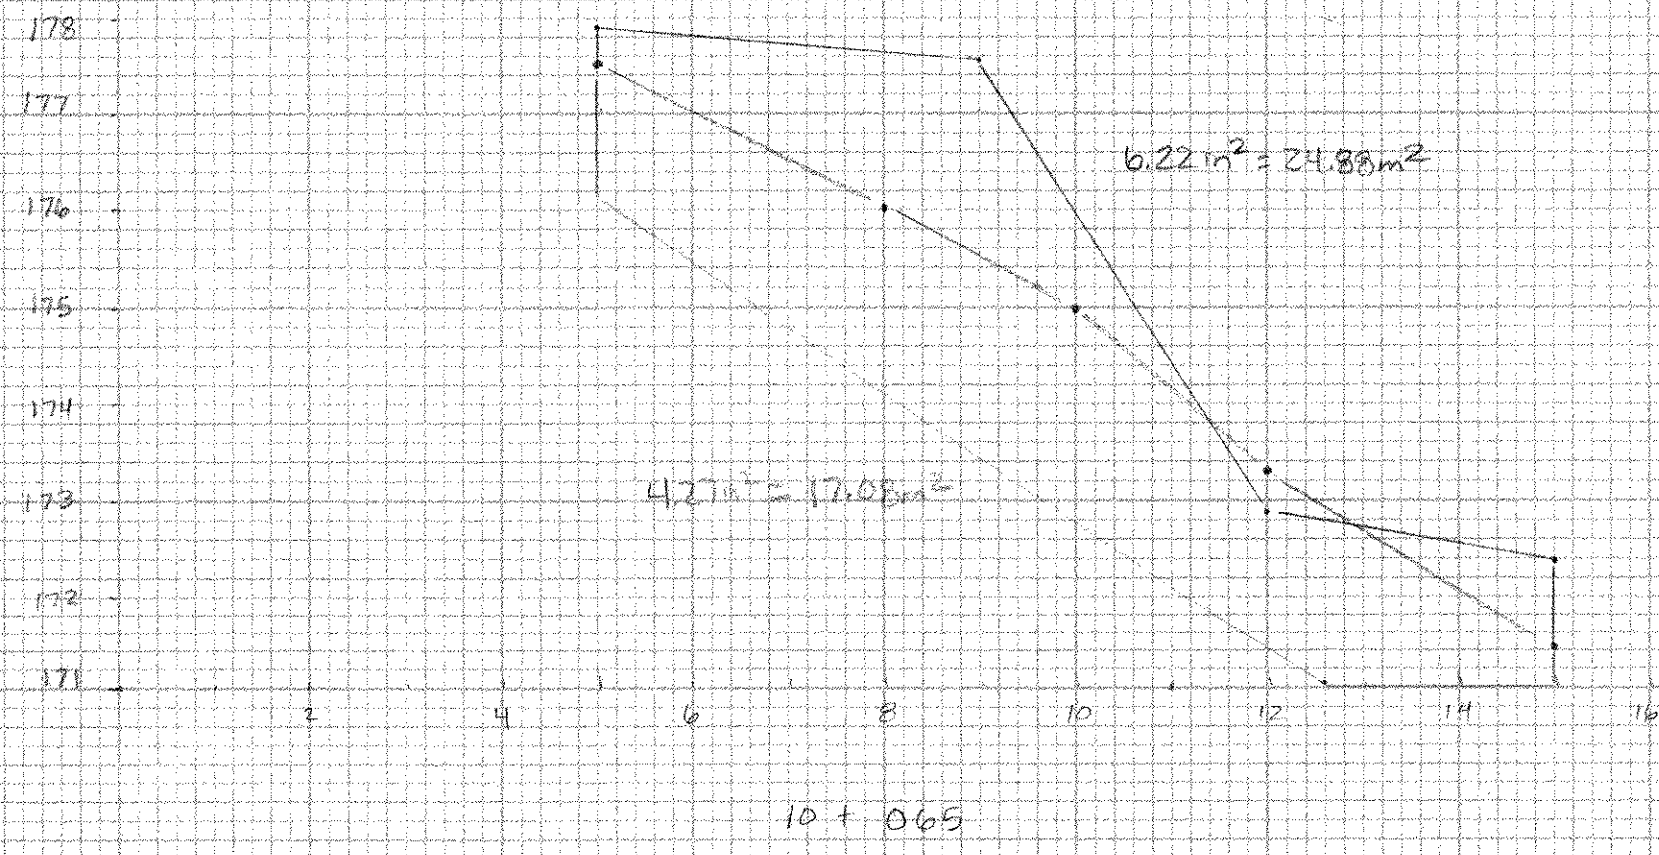

$16 \text{ m}^2 = 4 \text{ in}^2$

ORIGINAL SURVEY DATE
 SURVEYED BY
 NOTE BOOK NO.
 AREA SHEETS

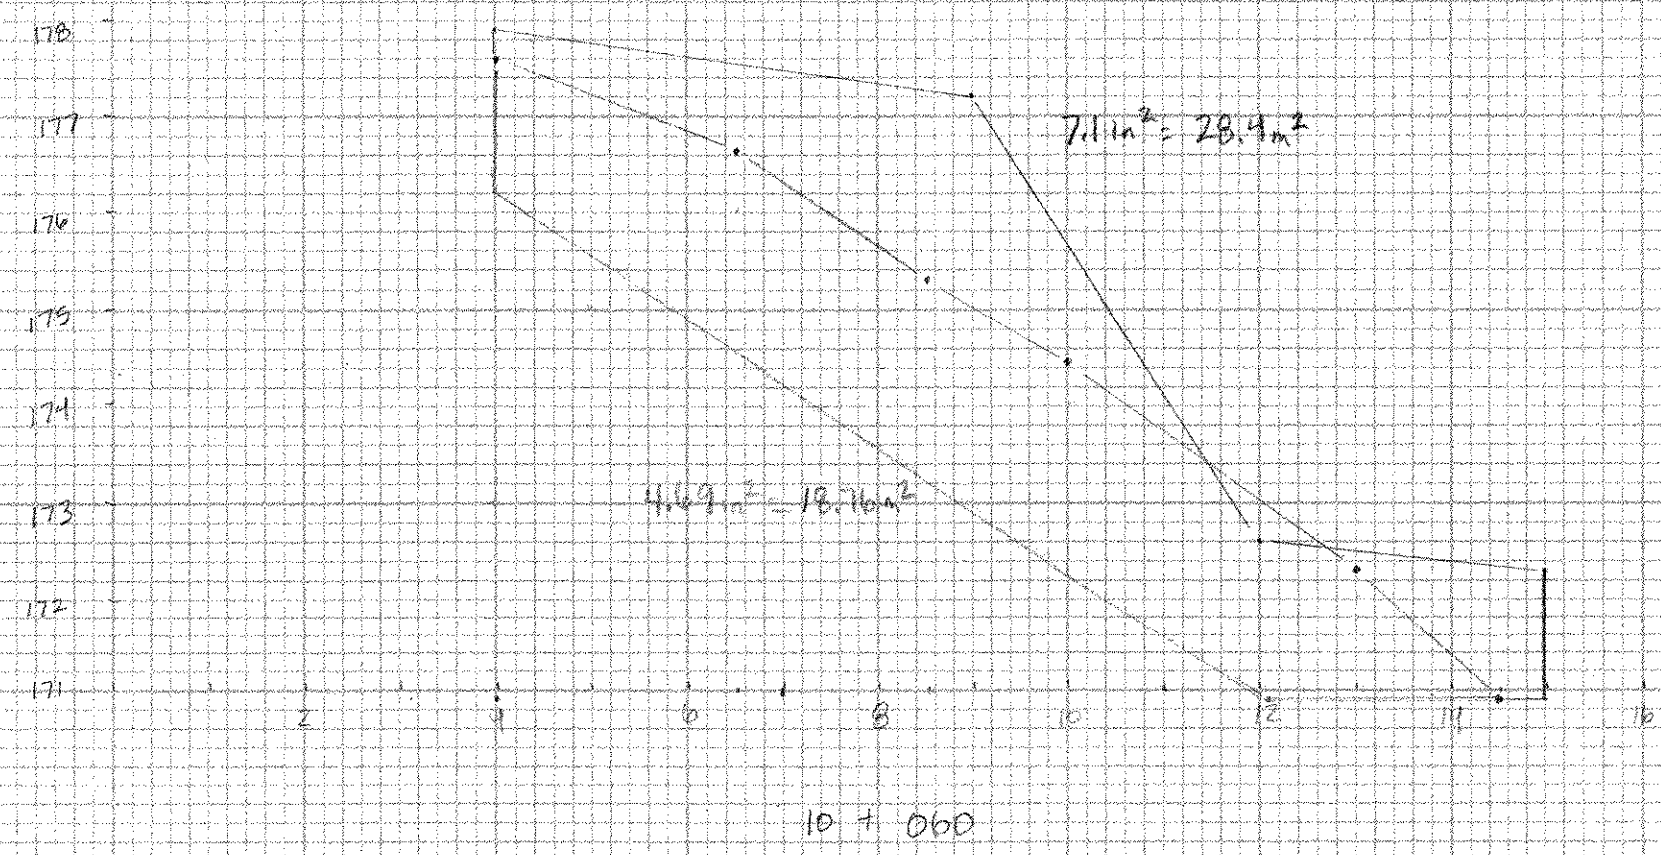

BRISTOL ERO21-103
 BRIDGE #10