



FINAL SURVEY BY DATE  
 REVISIONS BY DATE  
 SURVEY PLANTING BY DATE  
 NOTE BOOK AREA NO. AREA CHECKED

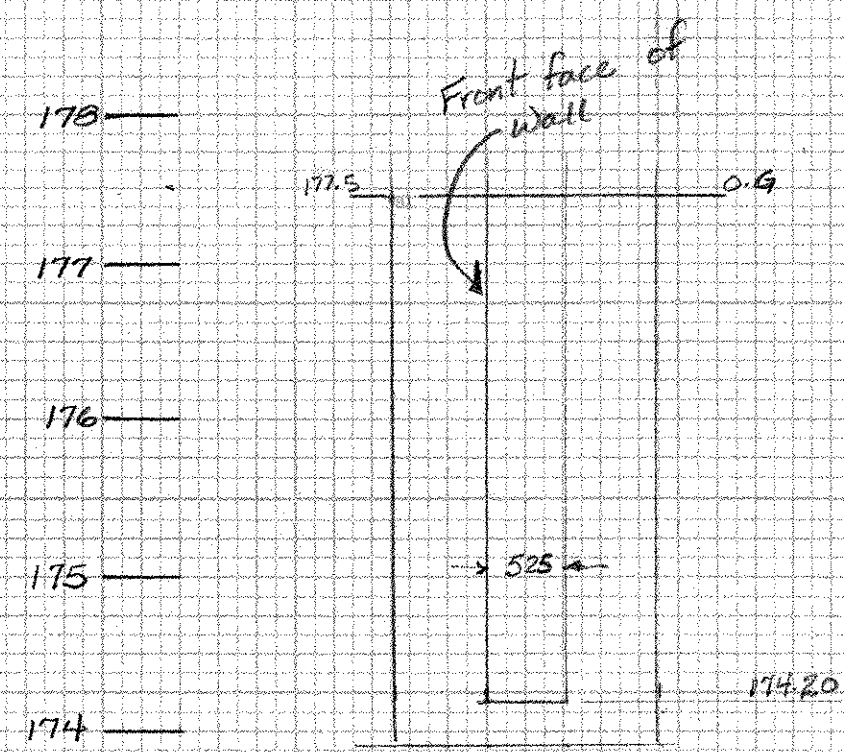

$$\text{Str Ex} = 1.725 \text{ w} \times (177.5 - 173.9) \times \frac{L}{2} = 11.8 \text{ m}^3$$

from Sht 47


WW #3

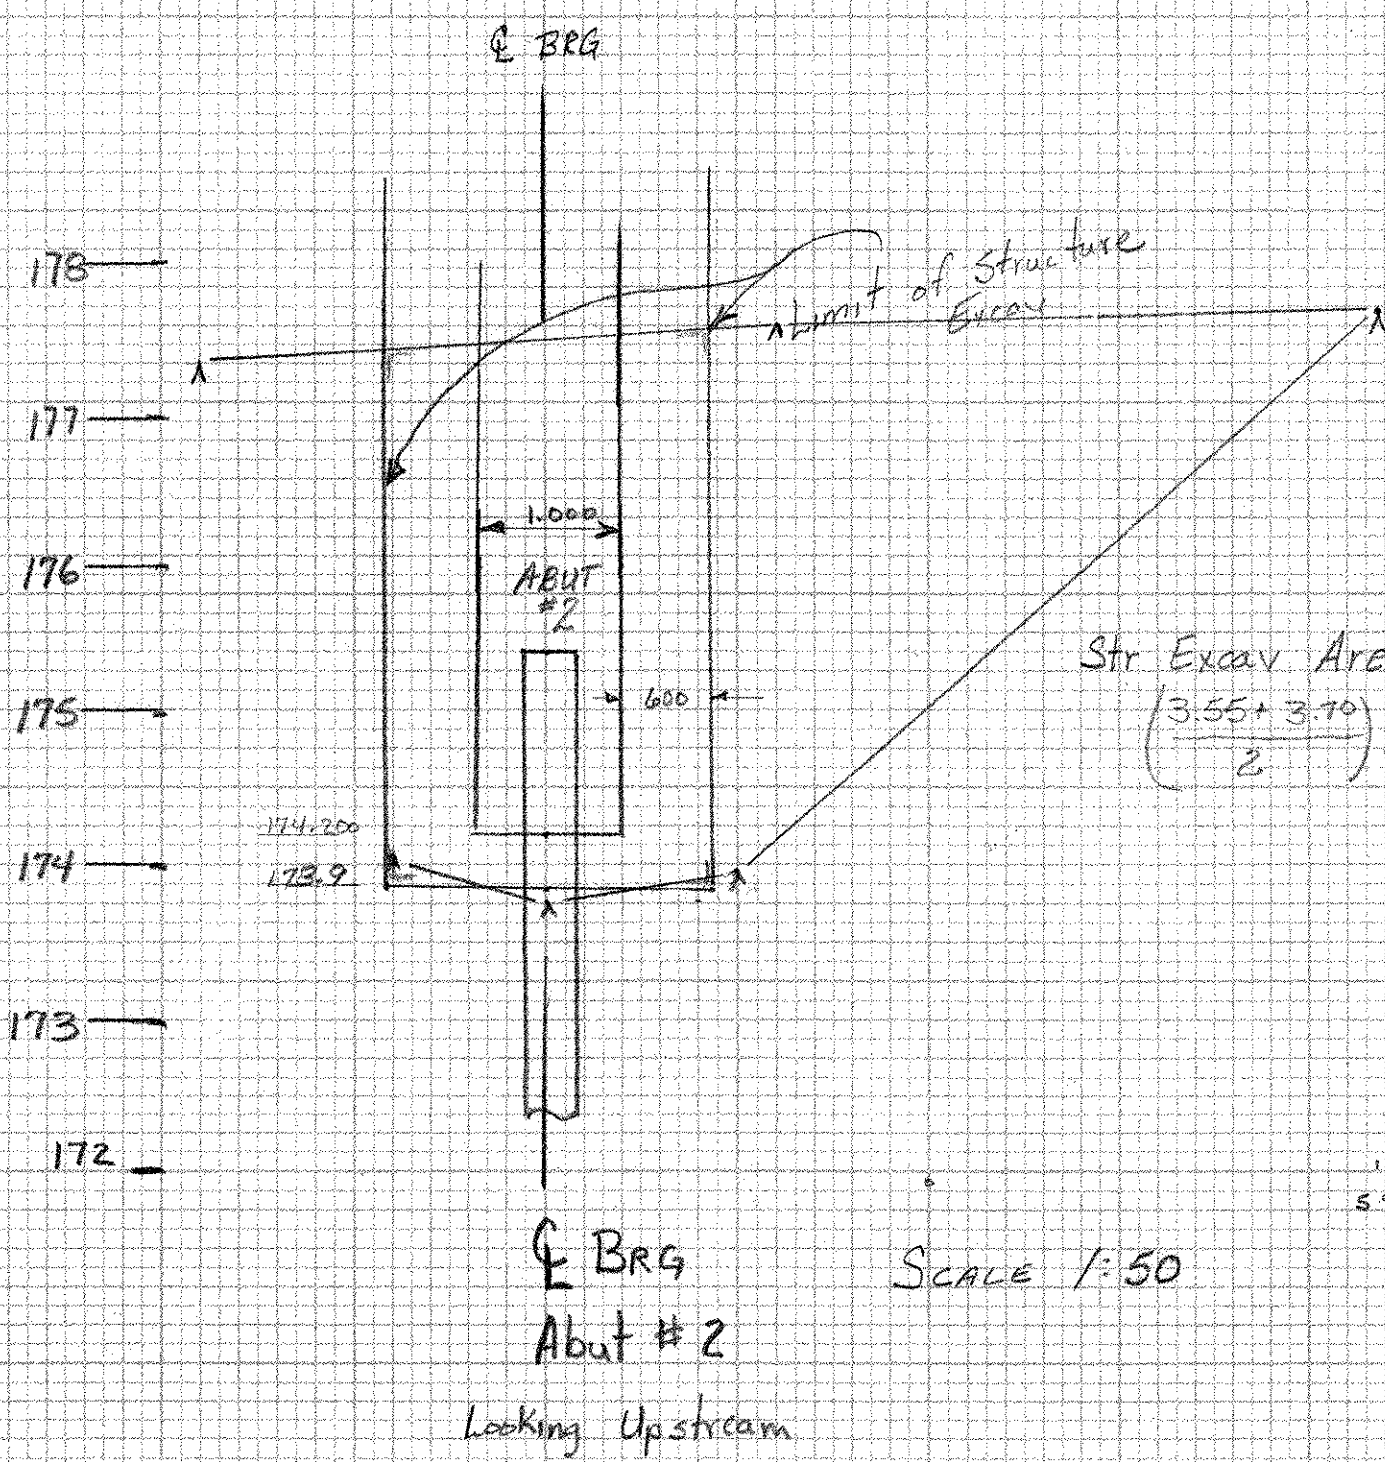

$$\text{Str Excav Area} = \frac{(3.55 + 3.70)}{2} \times 2.2 \text{ (w)} \times 14.4 \text{ m (L)} = 144.8 \text{ m}^3$$


from Sht #47

SCALE 1:50

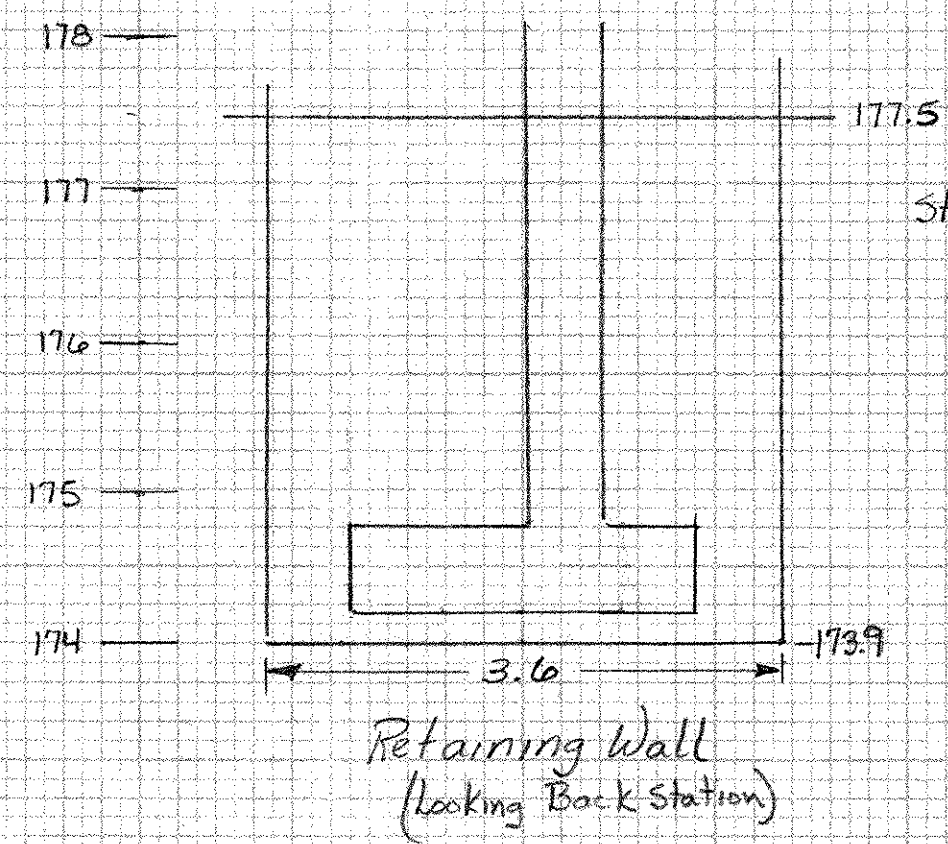

$$\text{Str Ex} = 3.6 \times \frac{H}{2} \times \frac{L}{2} = 132.2 \text{ m}^3$$

(3.6) (Sht 47)

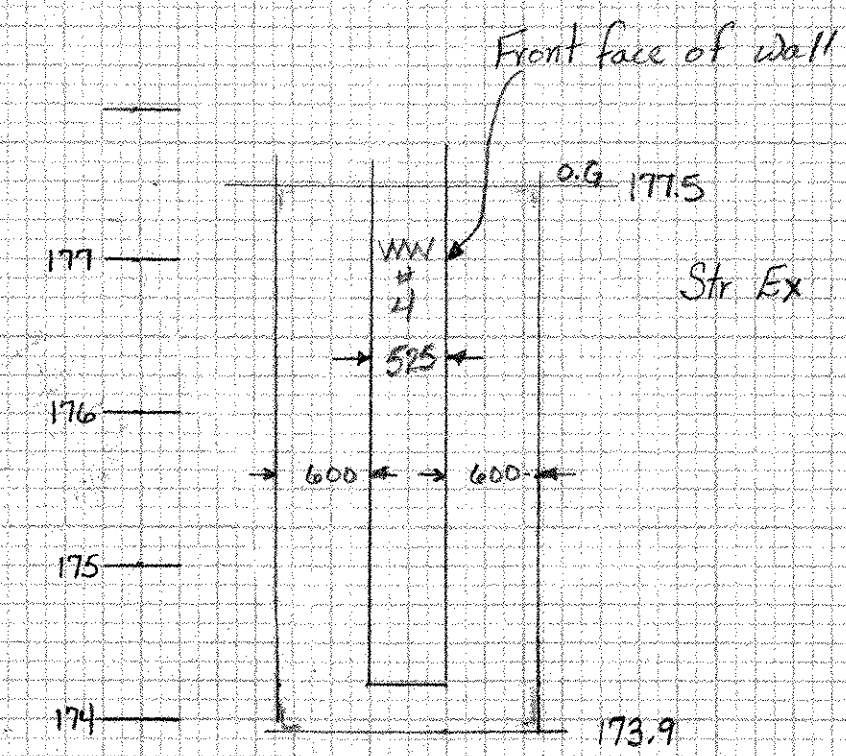

$$\text{Str Ex} = 1.725 \times \frac{H}{2} \times \frac{L}{2} = 19.6 \text{ m}^3$$

(3.6) (Sht 47)

WW #4