



R:\RE\15053_REW_VT_CABOT_DANVILLE\DWGS\06_MISC_DETAILS.DWG

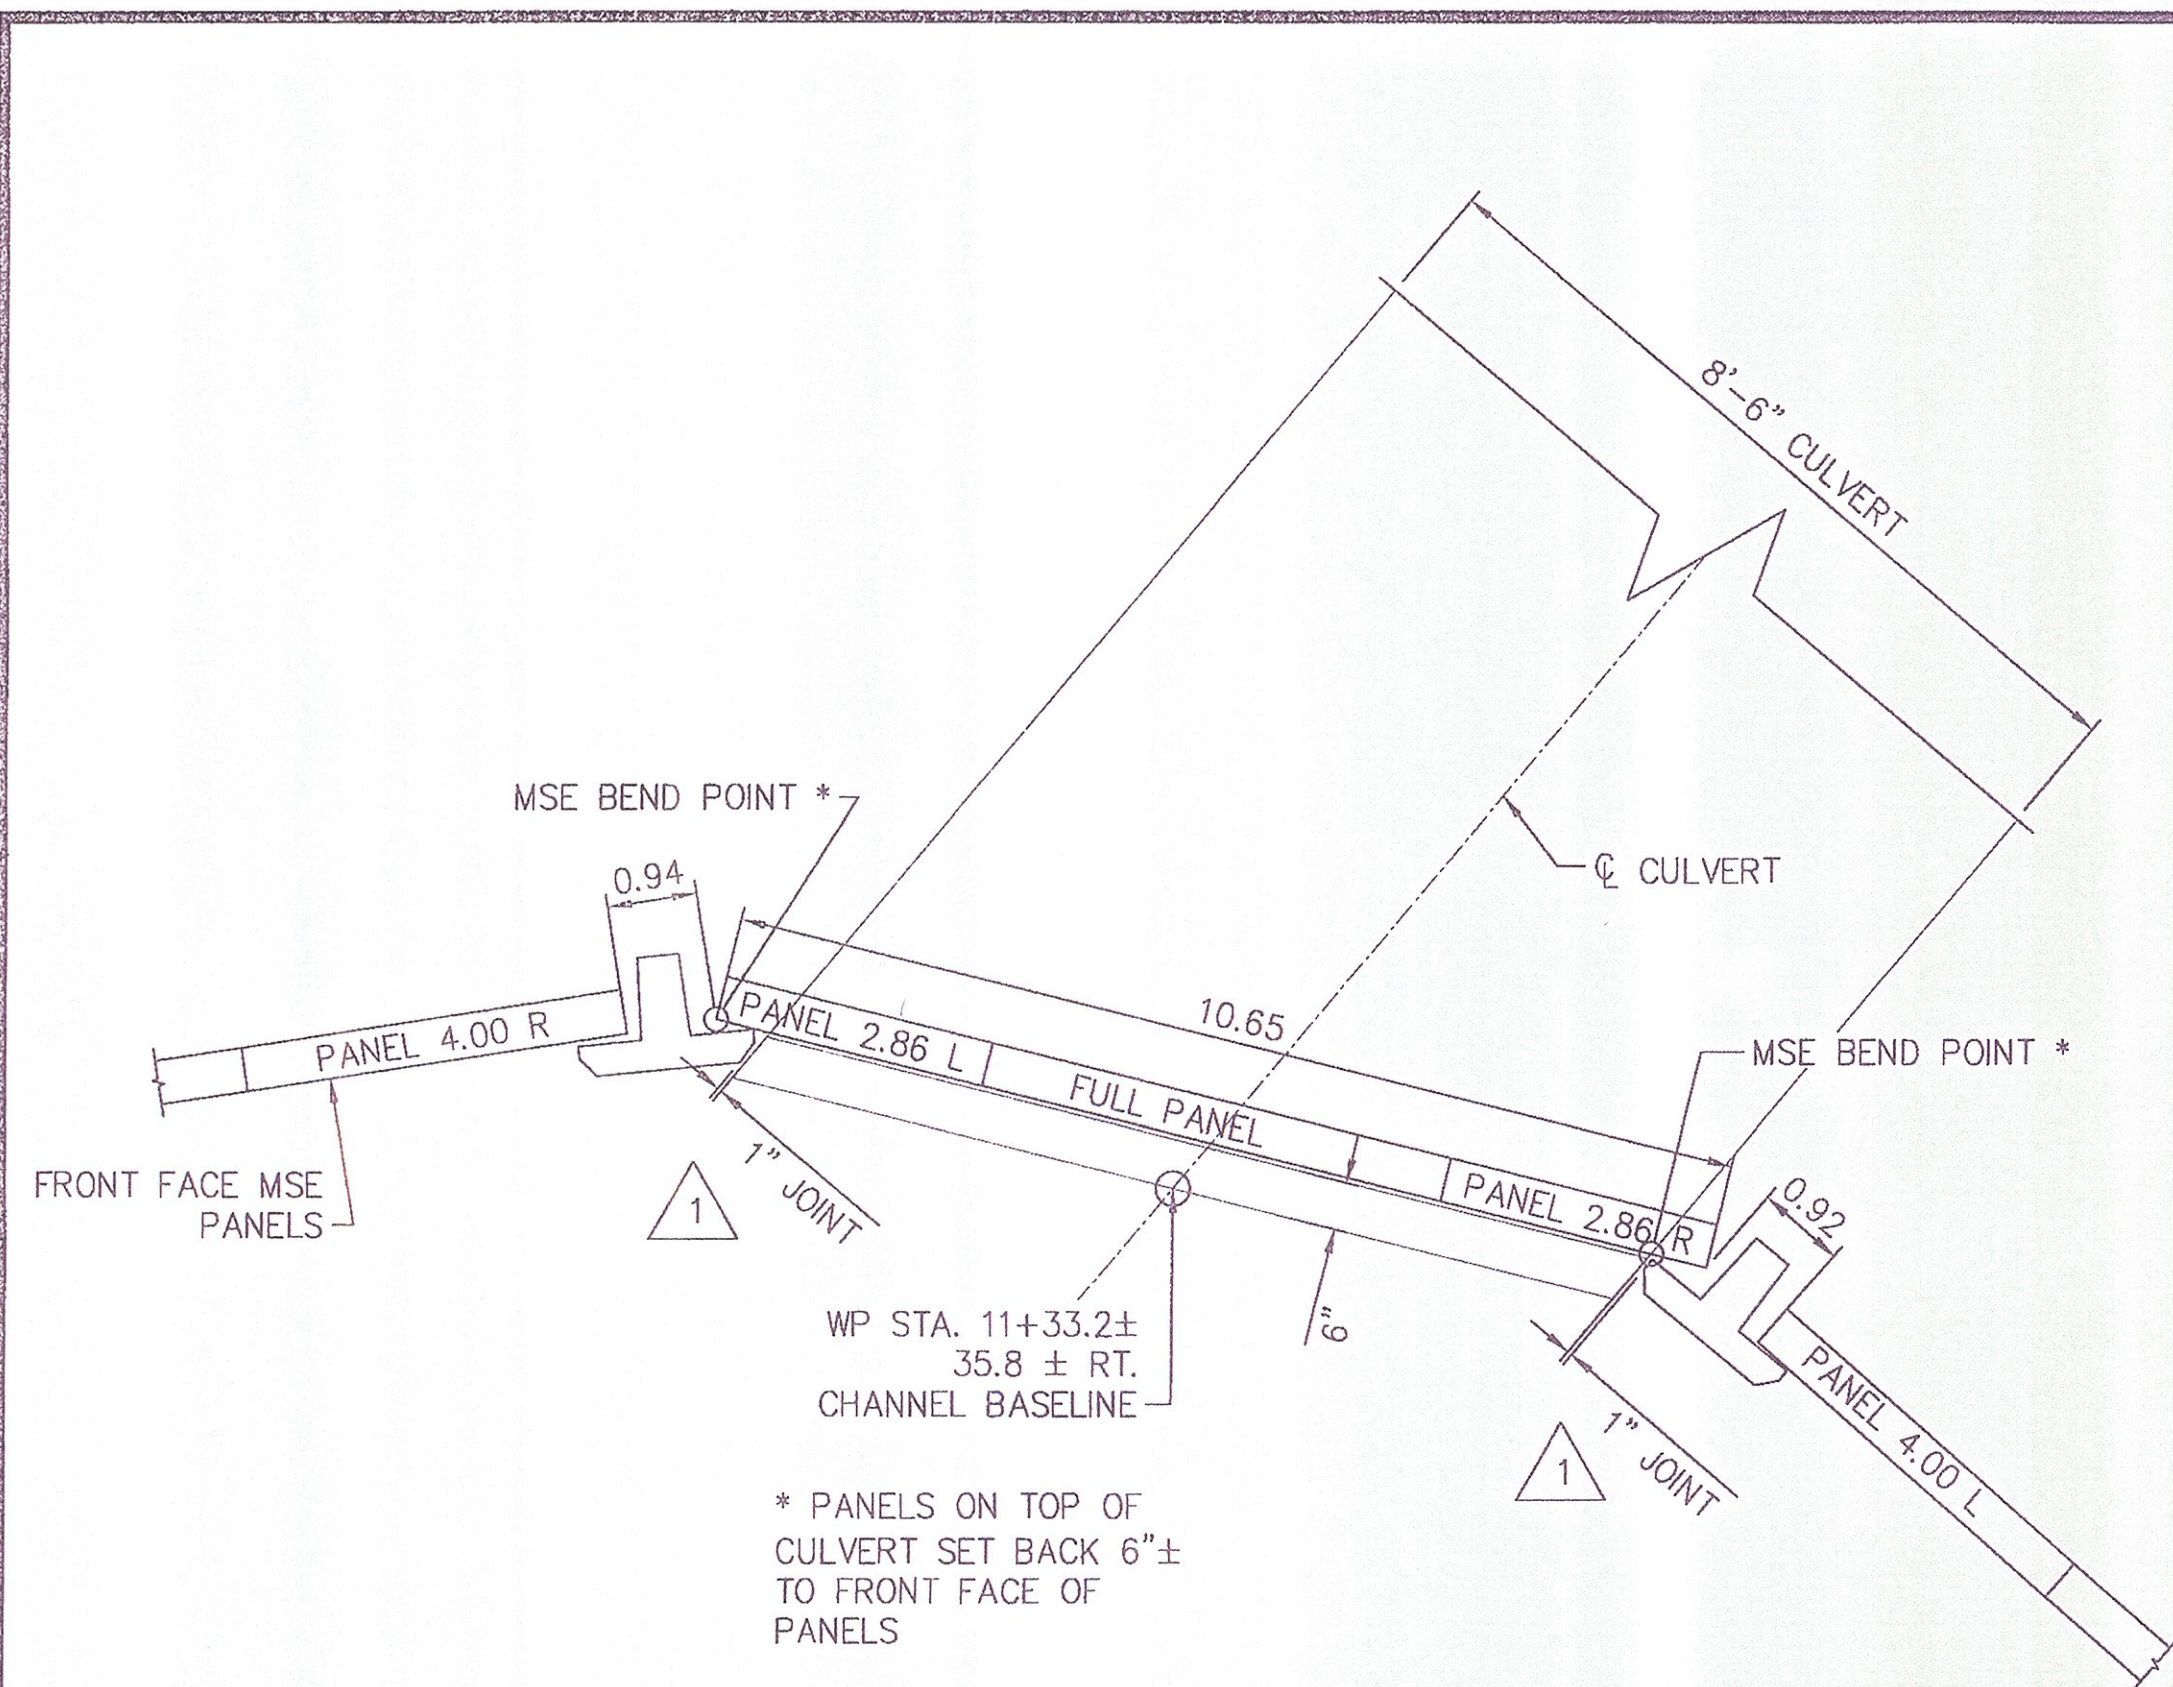


SLIP JOINT INTERFACE AT CULVERT
(SOUTH WALL SHOWN. NORTH WALL INTERFACE SIMILAR)
SCALE: 1/2" = 1'-0"

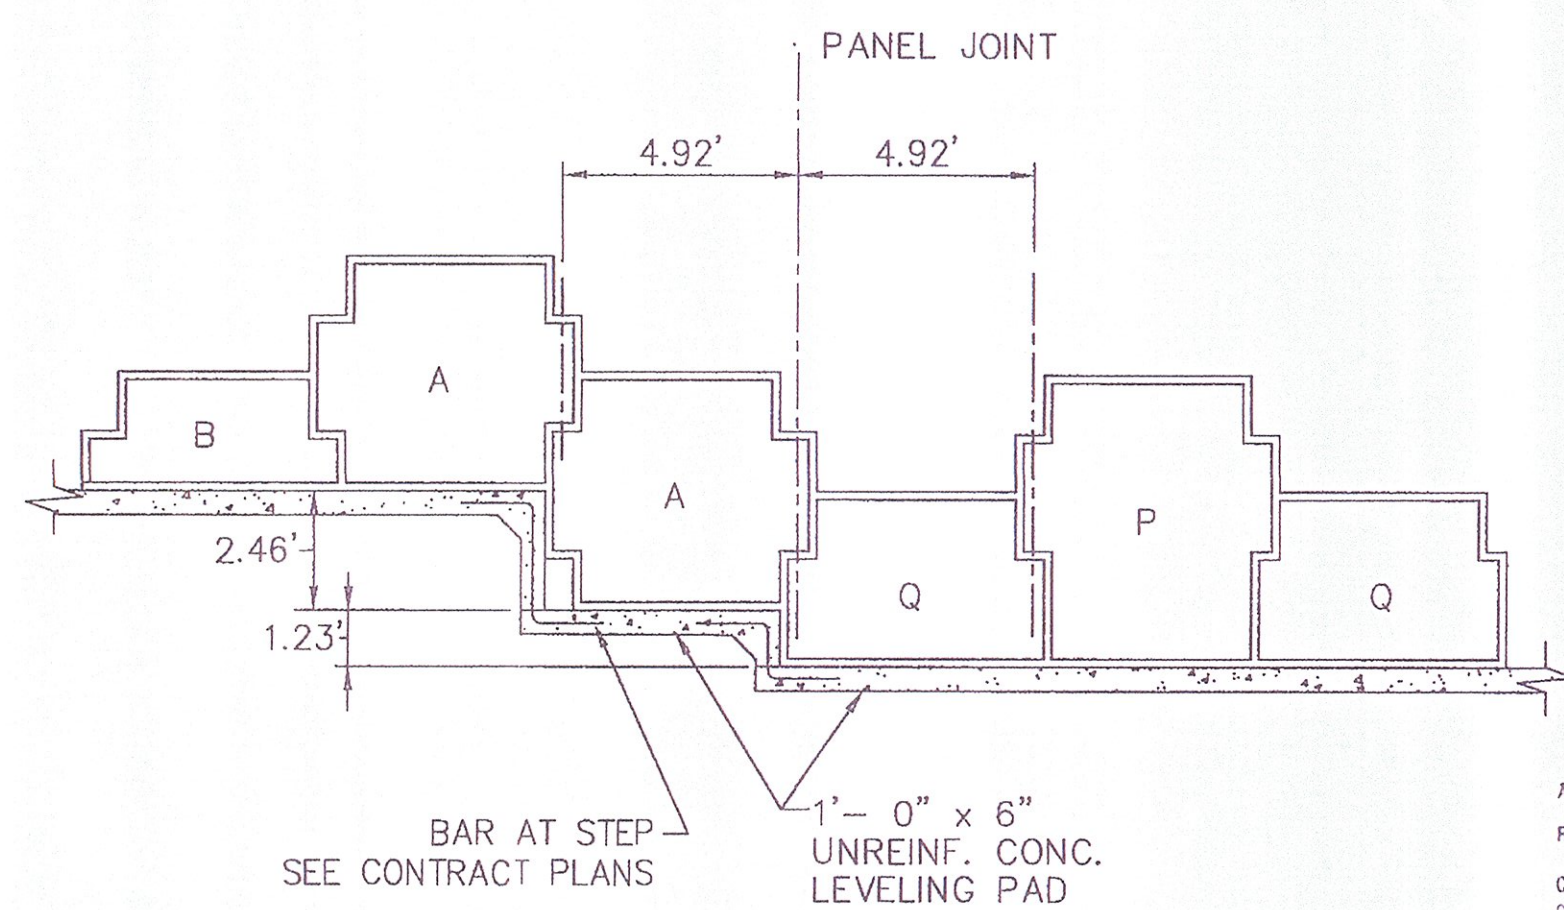

TYPICAL LEVELING PAD STEP DETAIL
SCALE: 1/4" = 1'-0"

NOTE: FOR ADDITIONAL DETAILS, REFER TO LEVELING PAD STEP DETAIL ON CONTRACT PLANS SHEET 102 OF 250



APPROVED
 Revise and Resubmit DISAPPROVED
 CHECKED BY: *[Signature]* DATE: 7/11
 SIGNED BY: *[Signature]* DATE: 7/11

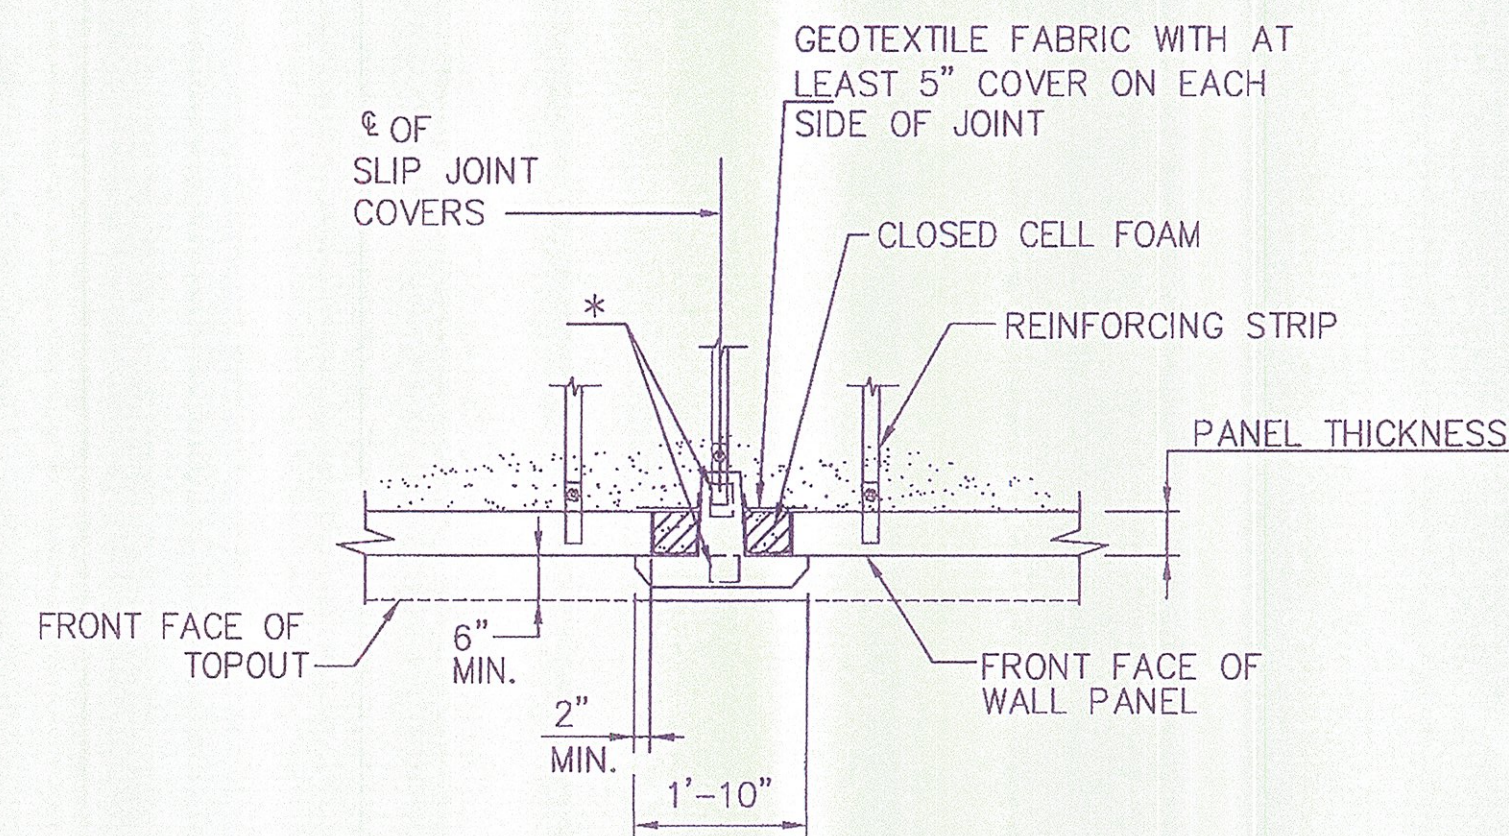

SLIP JOINT COVER DETAIL
SCALE: 1/2" = 1'-0"
* TWO FLAT BEARING PADS PER UNIT. FRONT PAD SHALL BE PLACED ON INSIDE EDGE OF LIP

5/8" DIA. x 6" LONG HILTI HAS ANCHOR ROD (GALV.) WITH HVA ADHESIVE ANCHOR OR HILTI HY150- EMBEDDED 4 1/2".
 2 PER CONNECTION ASSEMBLY 1 1/2" MIN. ±1/16"
 11/16" BOLT HOLE IN ANGLE


INSTALL IN ACCORDANCE WITH MANUFACTURERS RECOMENDATIONS

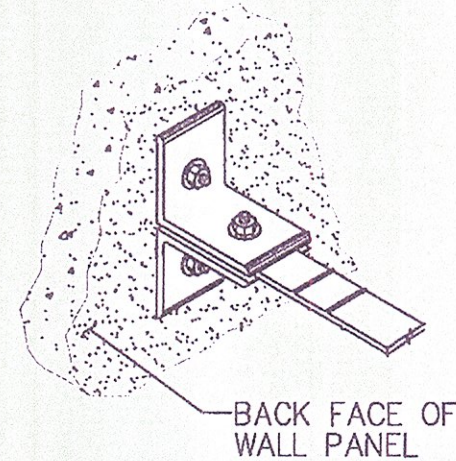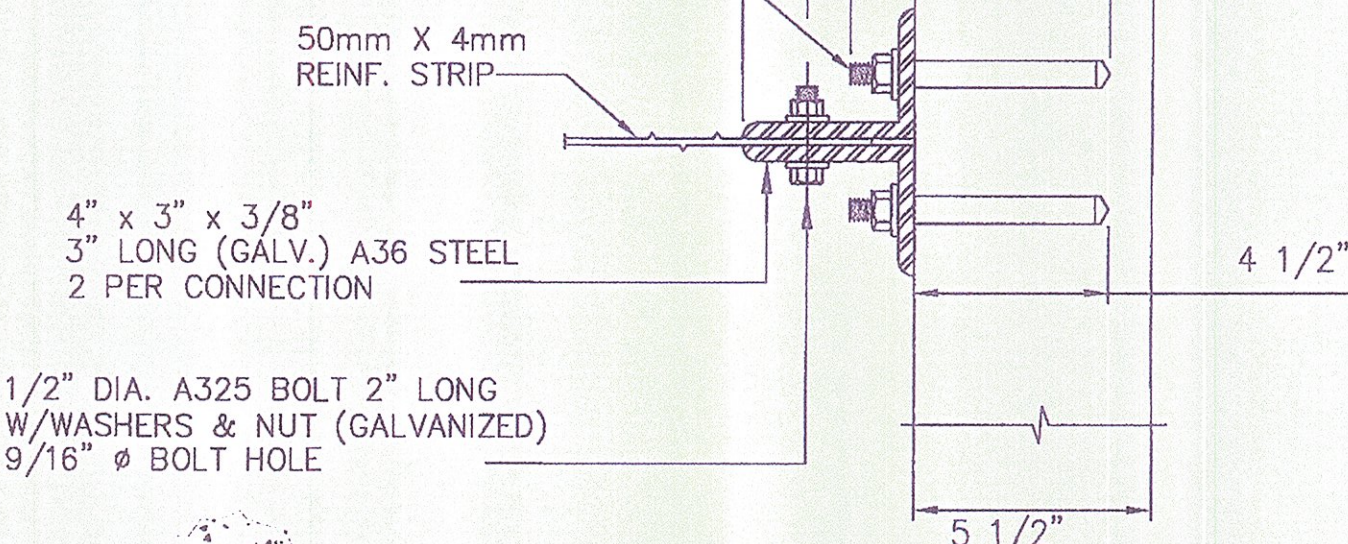

- MATERIAL PROPERTIES**
- CLIP ANGLE - A36 STEEL GALVANIZED PER ASTM A-123 OR AASHTO M111
 - 1/2" Ø BOLTS - A325 - GALVANIZED PER ASTM A-153
 - 50mm x 4mm R.S. - A-572 GRADE 65 GALVANIZED PER ASTM A-123 OR AASHTO M111
 - HILTI COMPONENTS PER HILTI SPECS.


NOTE:
 DRILLED HOLES SHALL BE CLEANED COMPRESSED AIR AS PER HILTI SPECIFICATIONS
 THIS DETAIL IS PROVIDED FOR USE IN THE EVENT A TIE STRIP CONNECTION NEEDS TO BE REPLACED OR ADDED TO THE MSE FACING PANELS.

CLIP ANGLE DETAIL
SCALE: NONE

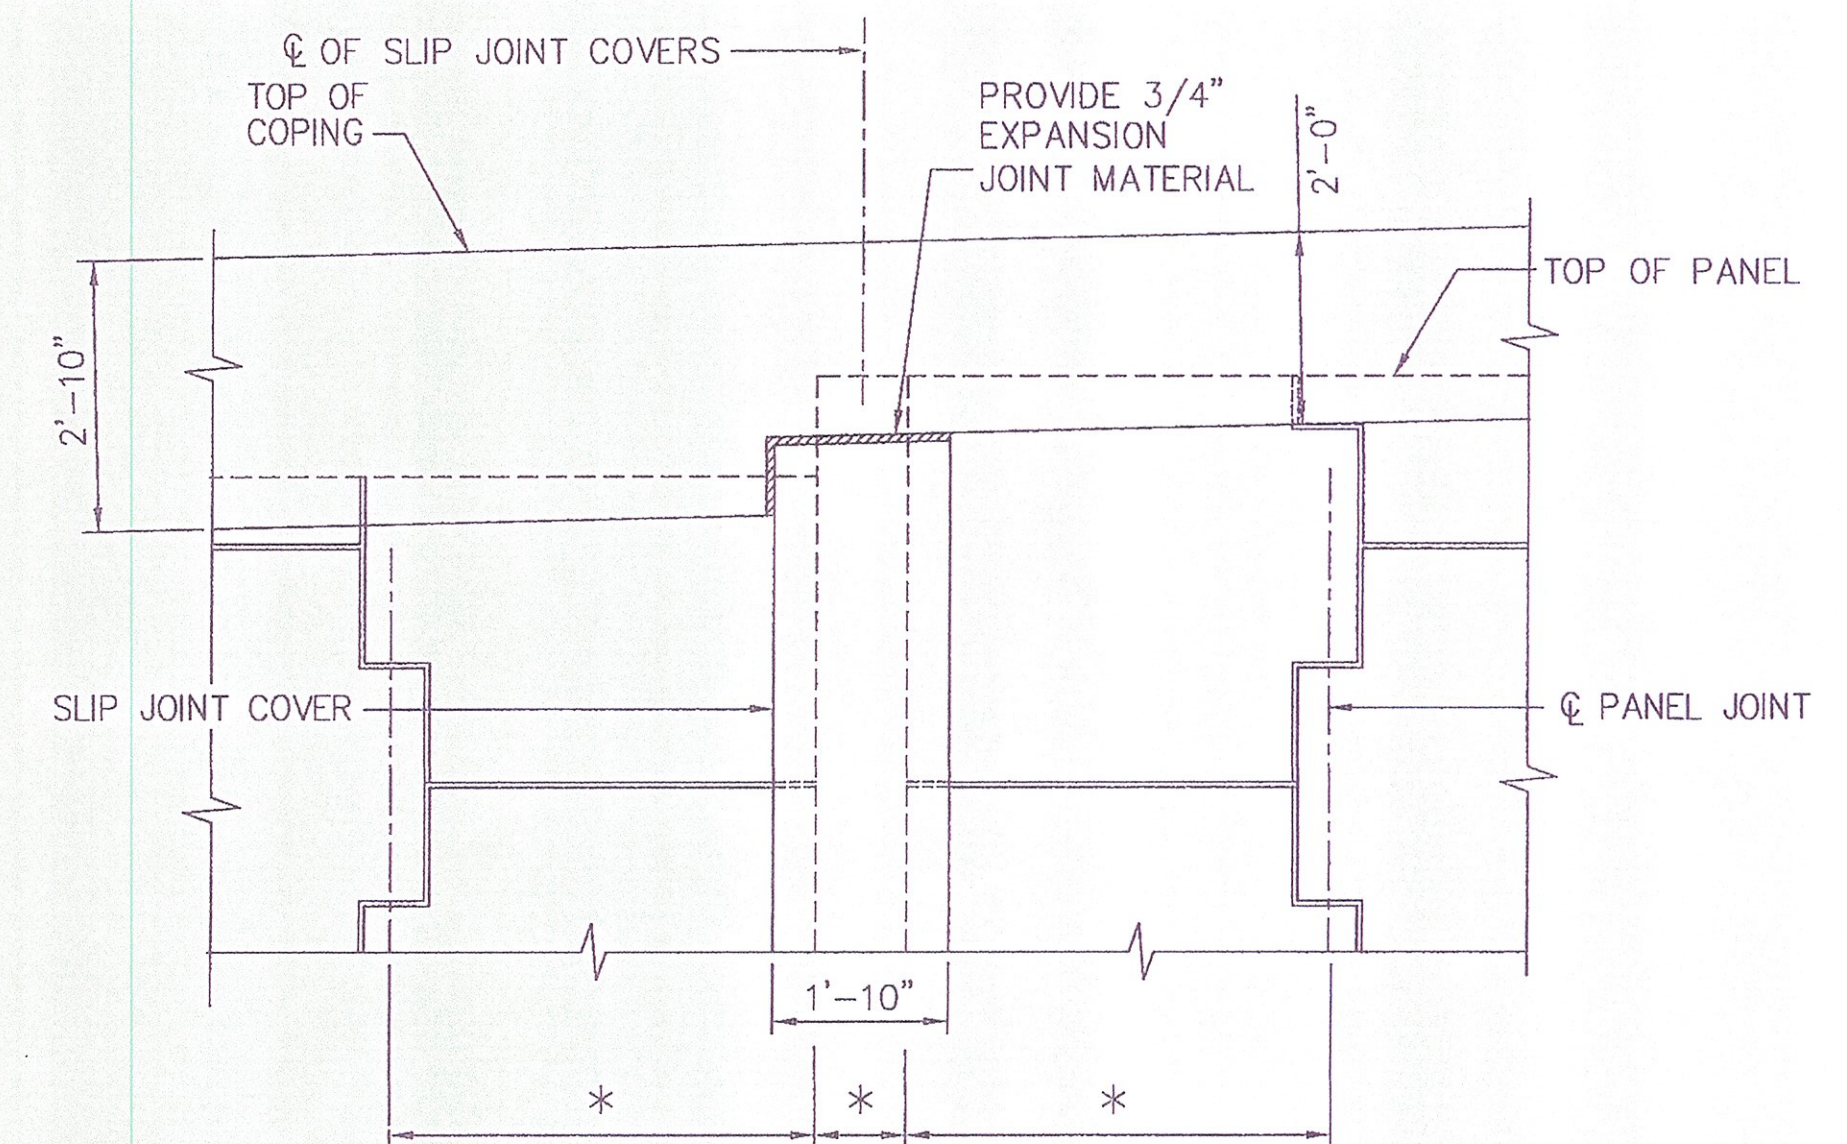

C.I.P. COPING OVER SLIP JOINT COVER (OPTION 1)
SCALE: 1/2" = 1'-0"
* SEE WALL ELEVATION

NOTE:
 CONTRACTOR MAY CHOOSE EITHER OPTION 1 OR OPTION 2 WHEREBY FOR OPTION 1 THE TOP SLIP JOINT PANEL IS FIELD CUT TO FIT UNDER BOTTOM OF COPING PROVIDING A 3/4" JOINT AS SHOWN IN DETAIL. OPTION 2 ALLOWS FOR USE OF THE FULL SLIP JOINT PANEL PROVIDED BY RECO WHEREBY THE CONTRACTOR WILL CAST THE COPING AROUND THE TOP OF SLIP JOINT COVER PROVIDING THE 3/4" JOINT SHOWN IN THE DETAIL.

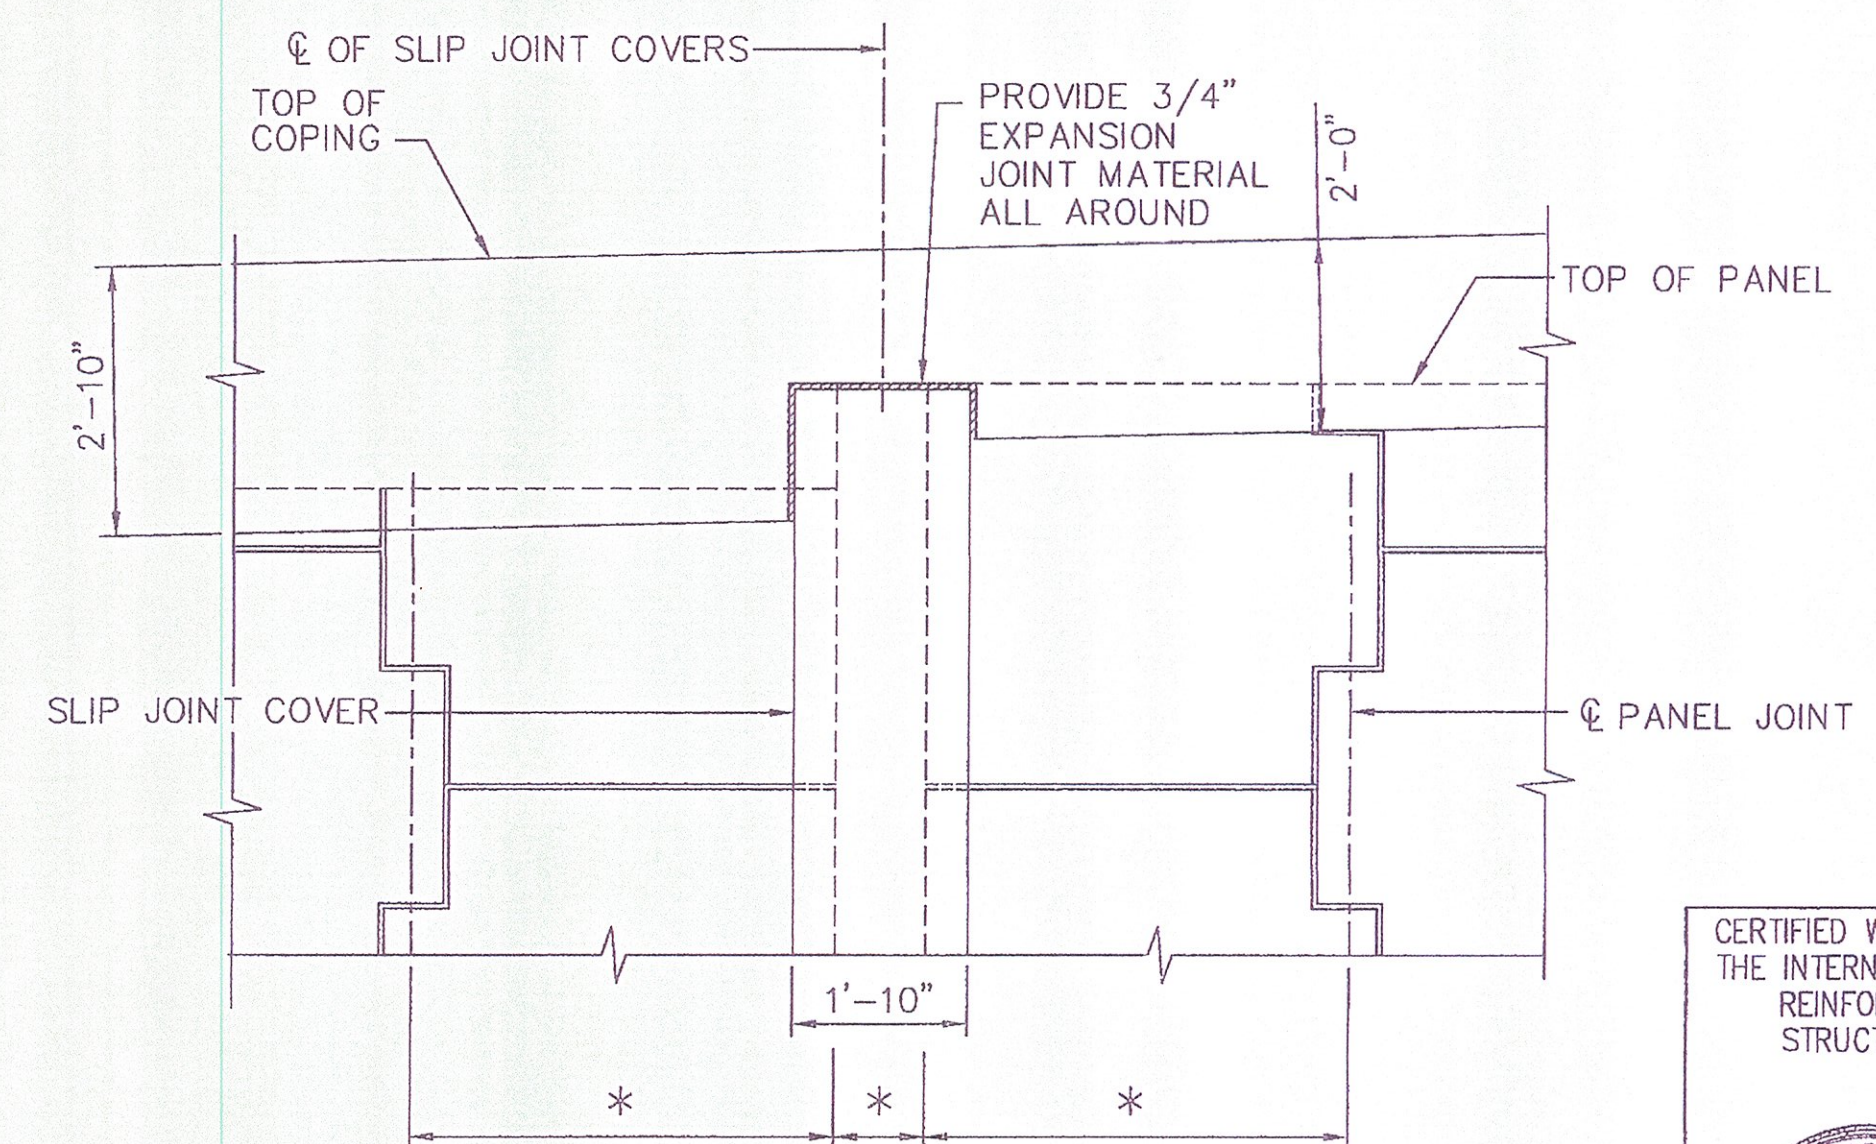

C.I.P. COPING OVER SLIP JOINT COVER (OPTION 2)
SCALE: 1/2" = 1'-0"
* SEE WALL ELEVATION

CERTIFIED WITH RESPECT TO THE INTERNAL STABILITY OF REINFORCED EARTH STRUCTURES ONLY



This drawing contains information proprietary to The Reinforced Earth Company, and is being furnished for the use of VTAOT only in connection with this project, and the information contained herein is not to be transmitted to any other organization unless specifically authorized in writing by The Reinforced Earth Company. The Reinforced Earth Company is exclusive licensee in the United States under patents issued to Henri Vidal, and the furnishing of this drawing does not constitute an expressed or implied license under the Vidal patents.

The design contained on these drawings is based on information provided by the owner. On the basis of this information, The Reinforced Earth Company has designed, and is responsible for the internal stability of the structure only. External stability, including foundation (bearing capacity and settlement) and slope (global) stability, is the responsibility of the owner.



"REINFORCED EARTH" is the registered trademark of The Reinforced Earth Company.

DESIGNED BY: DTM		PROJECT NAME U.S. ROUTE 2 OVER EXISTING STREAM	DATE 04/6/11
PROJECT ENGR: LY		LOCATION CABOT-DANVILLE VERMONT	CONTRACT NO. RE-15053
CHECKED BY: PLA/EEH	7/19/11	OWNER VTAOT	DRAWING NO. 6 OF 7
REV.	DATE	DESCRIPTION	SCALE AS SHOWN