



107+00

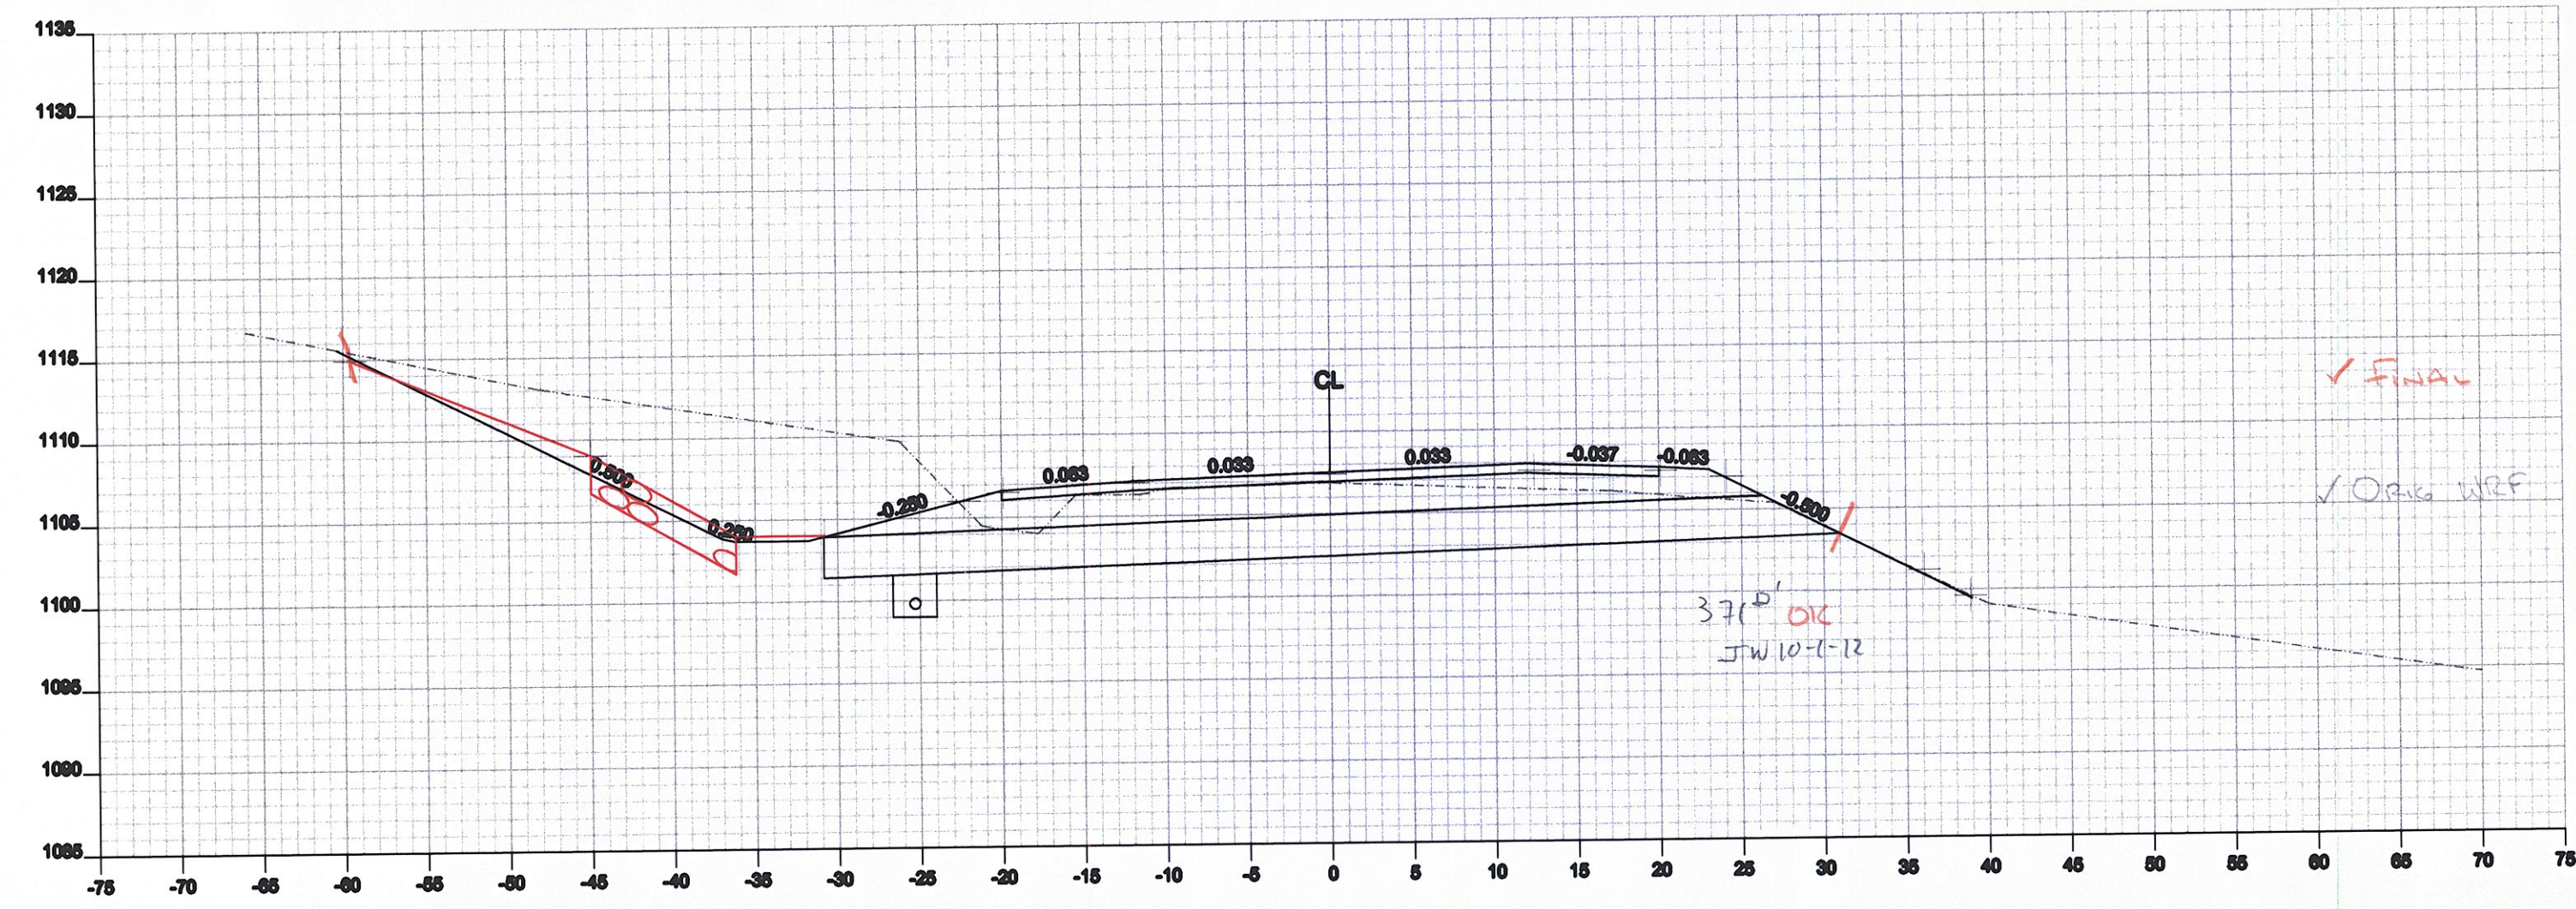

106+50

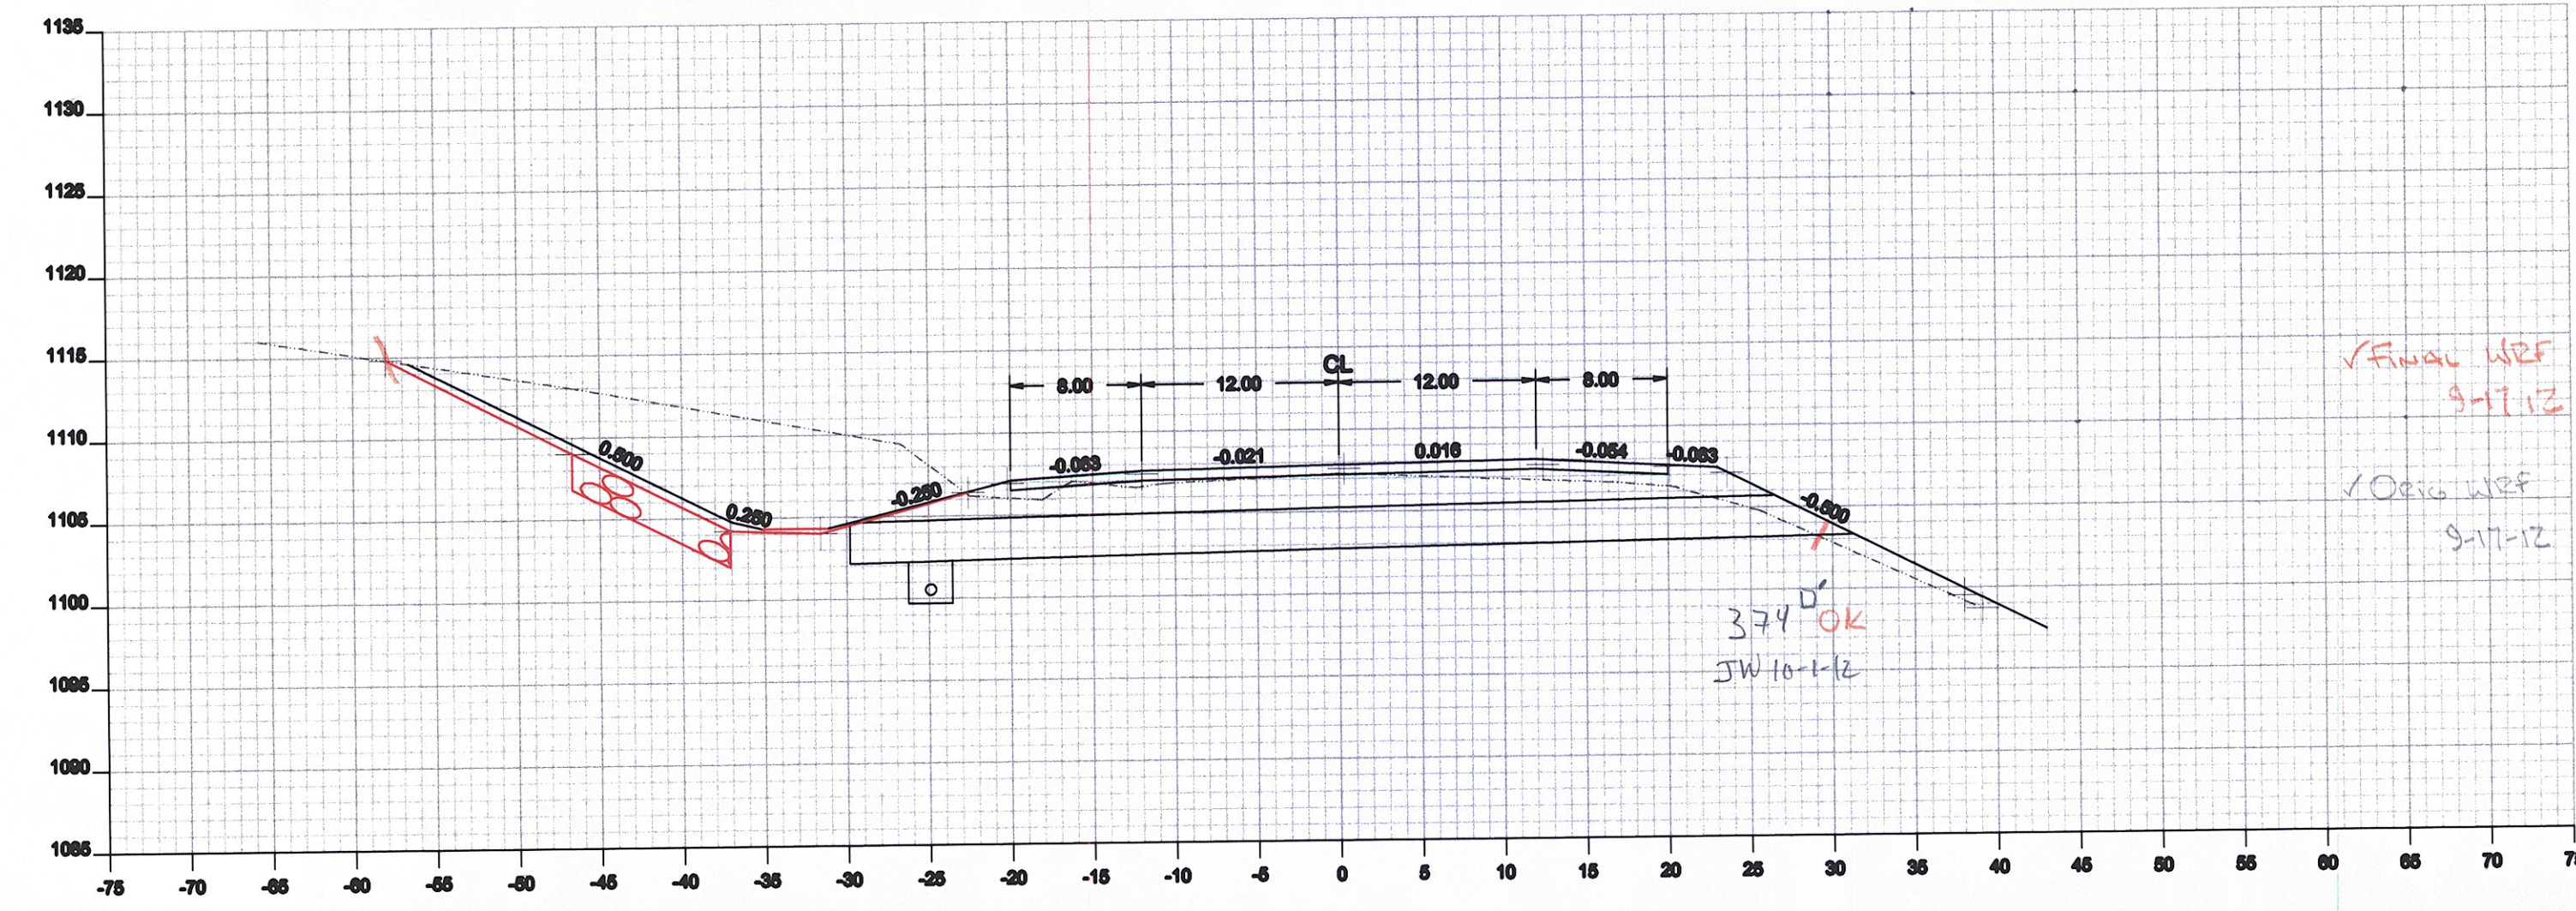

106+00

Drawing: Cross Section 106+00 - 107+00	
Project: Cabot Damville	
Drawn By: JMR	Checked By:
Date: 06-13-2012	Date:
Scale: 1:10	Sheet: of