



115+50

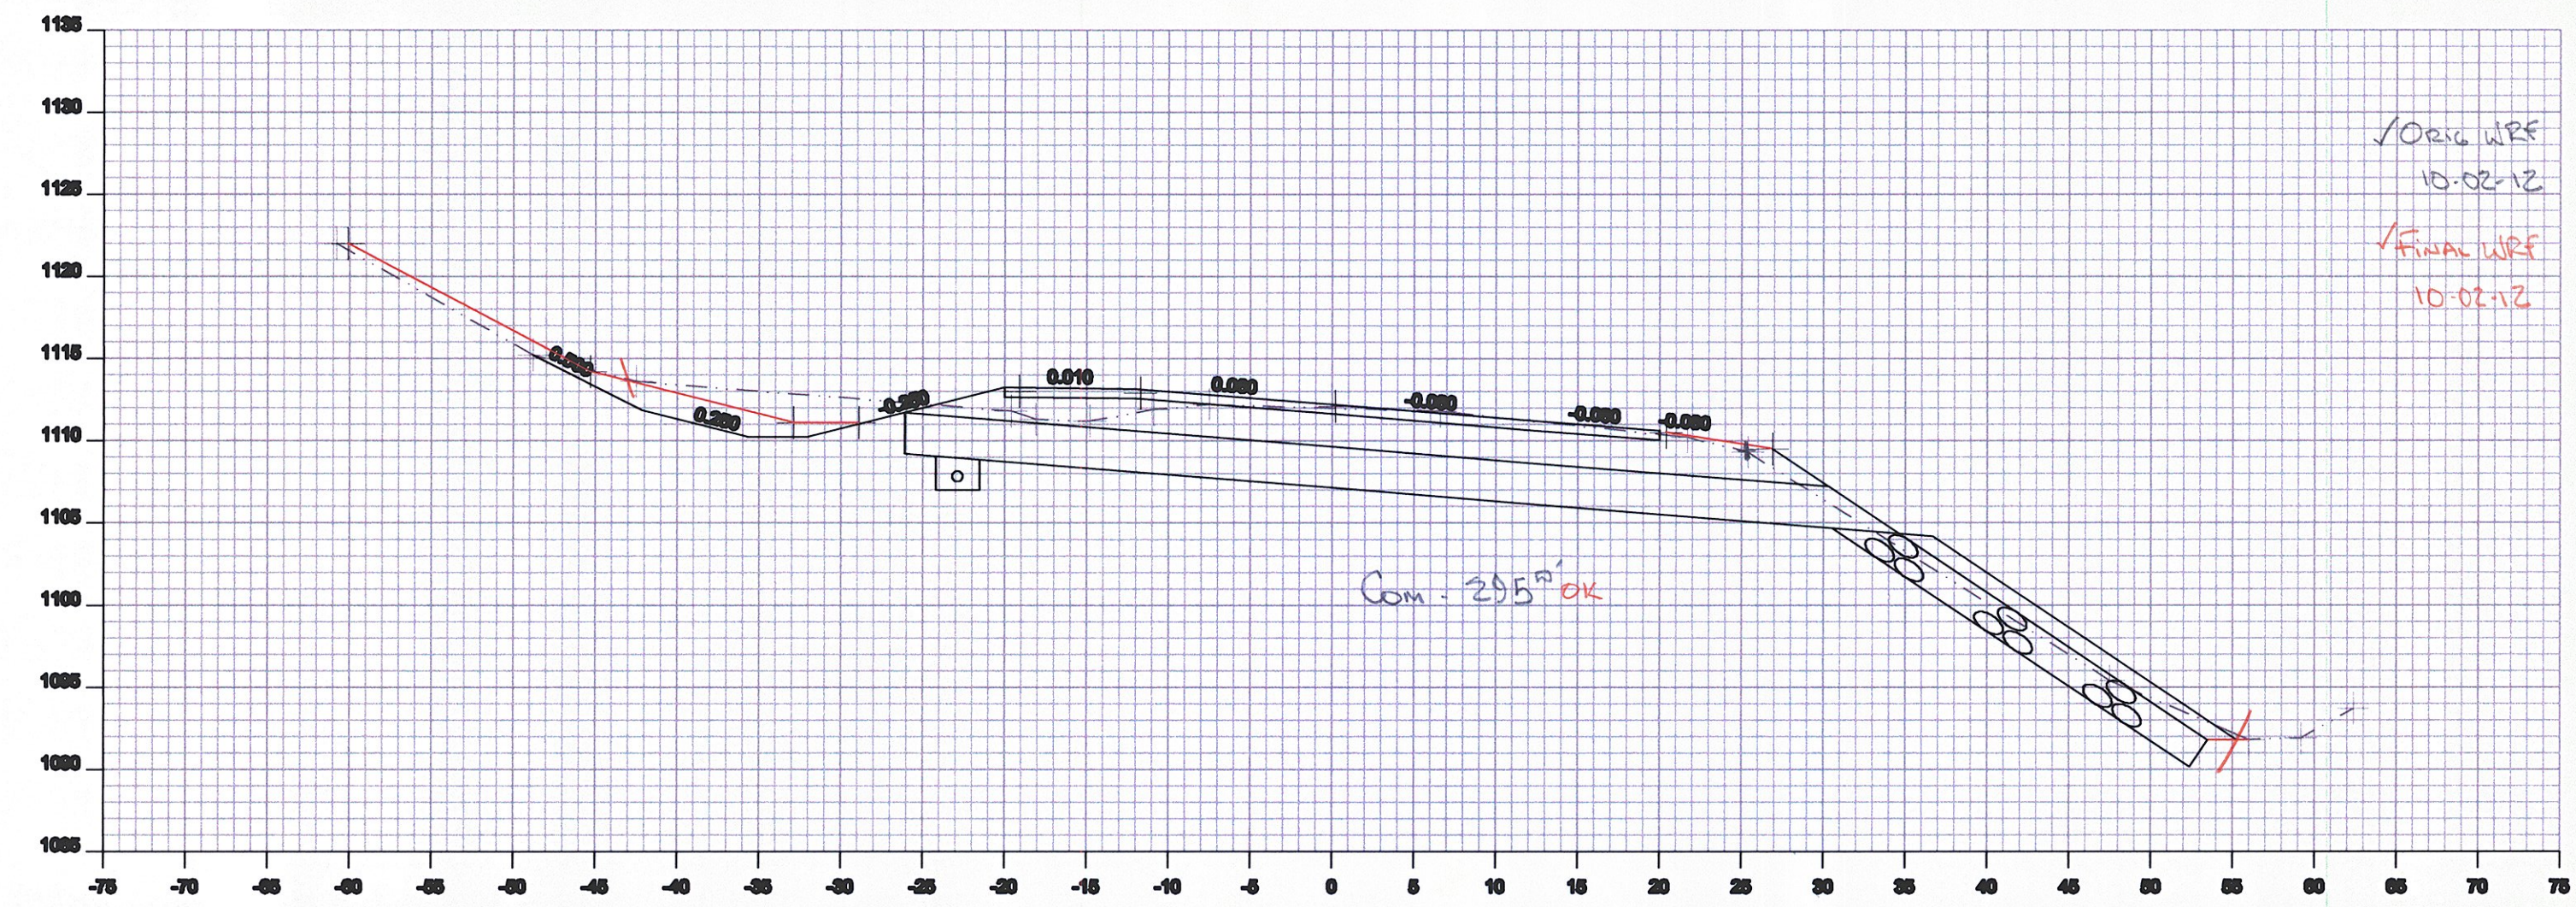

116+00

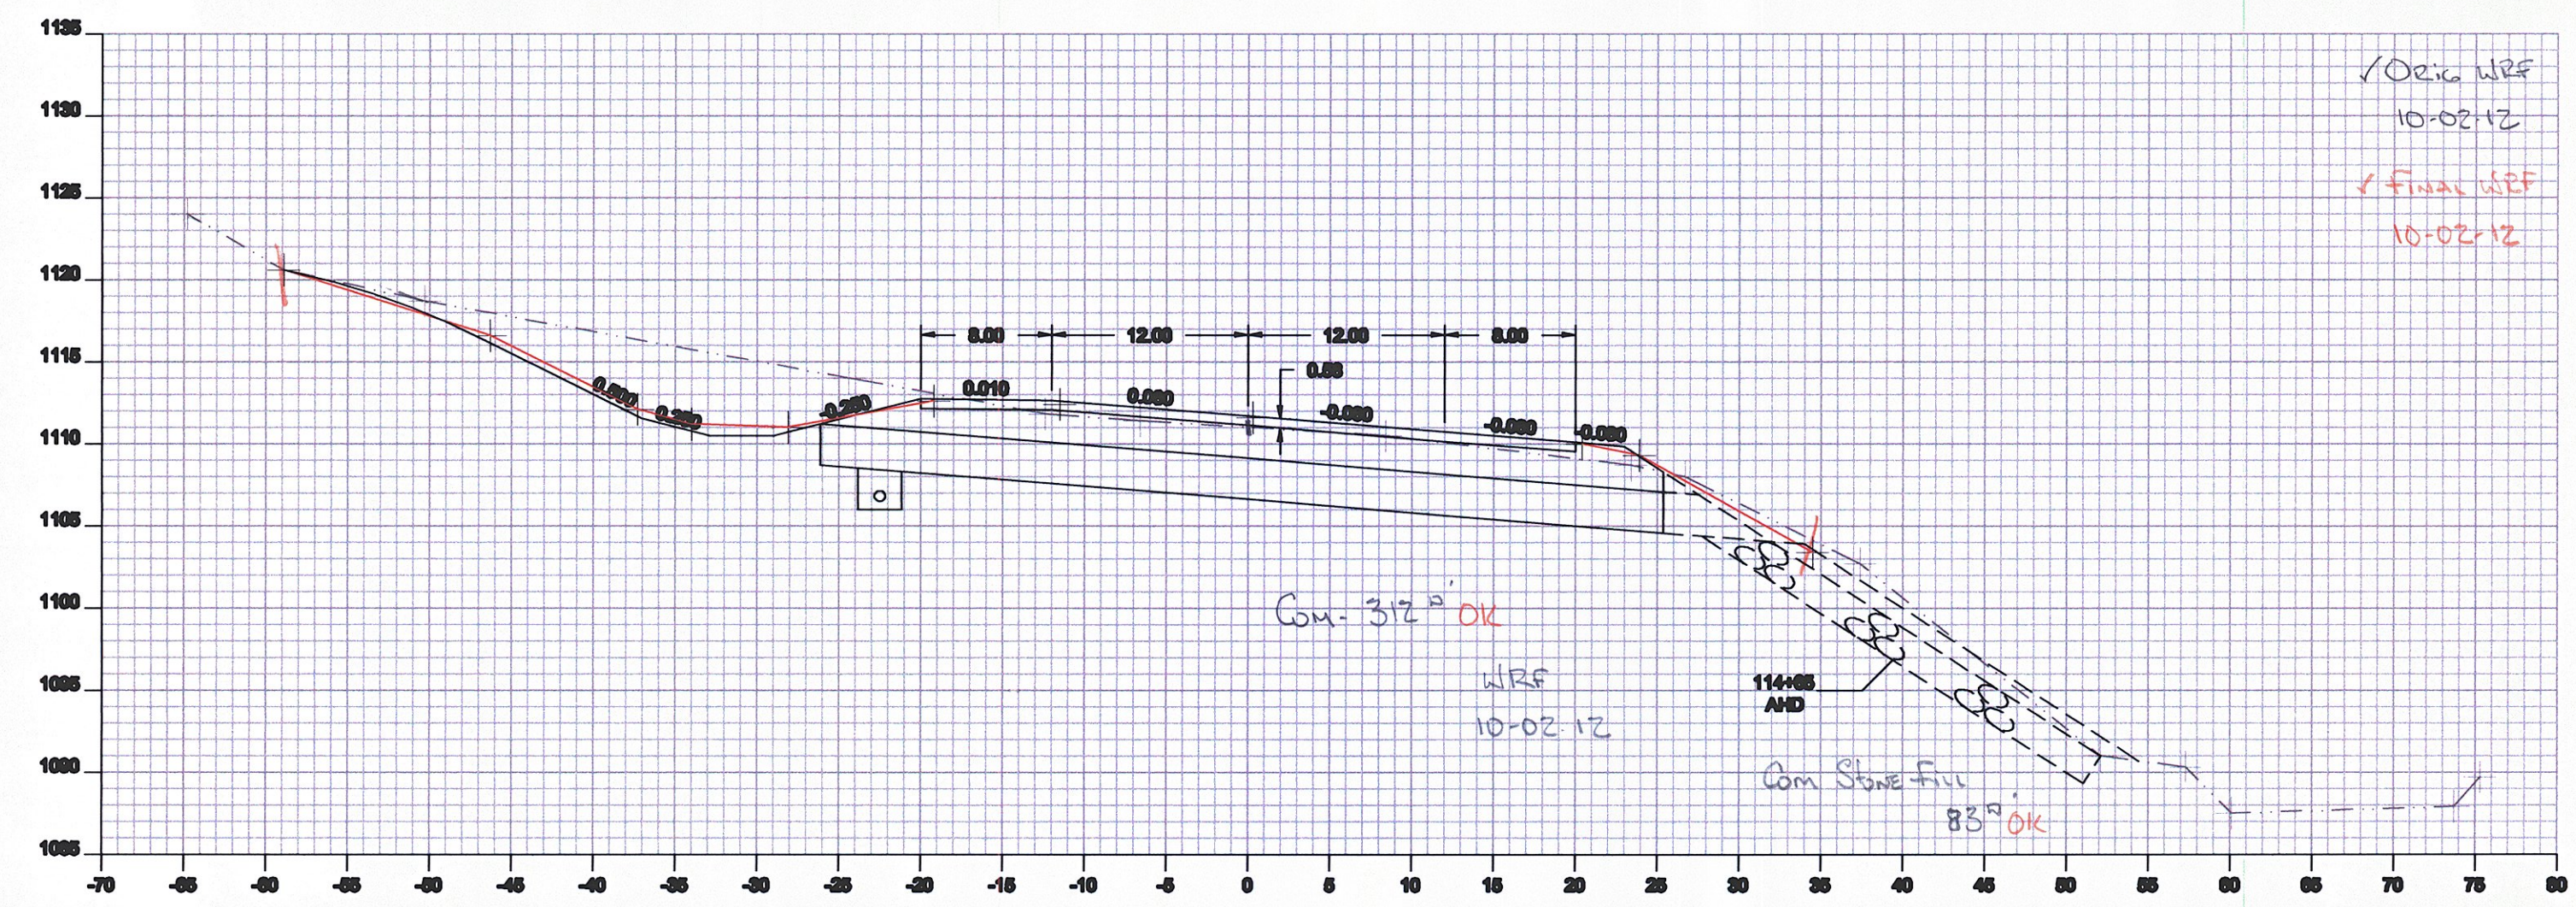

114+50