



118+50

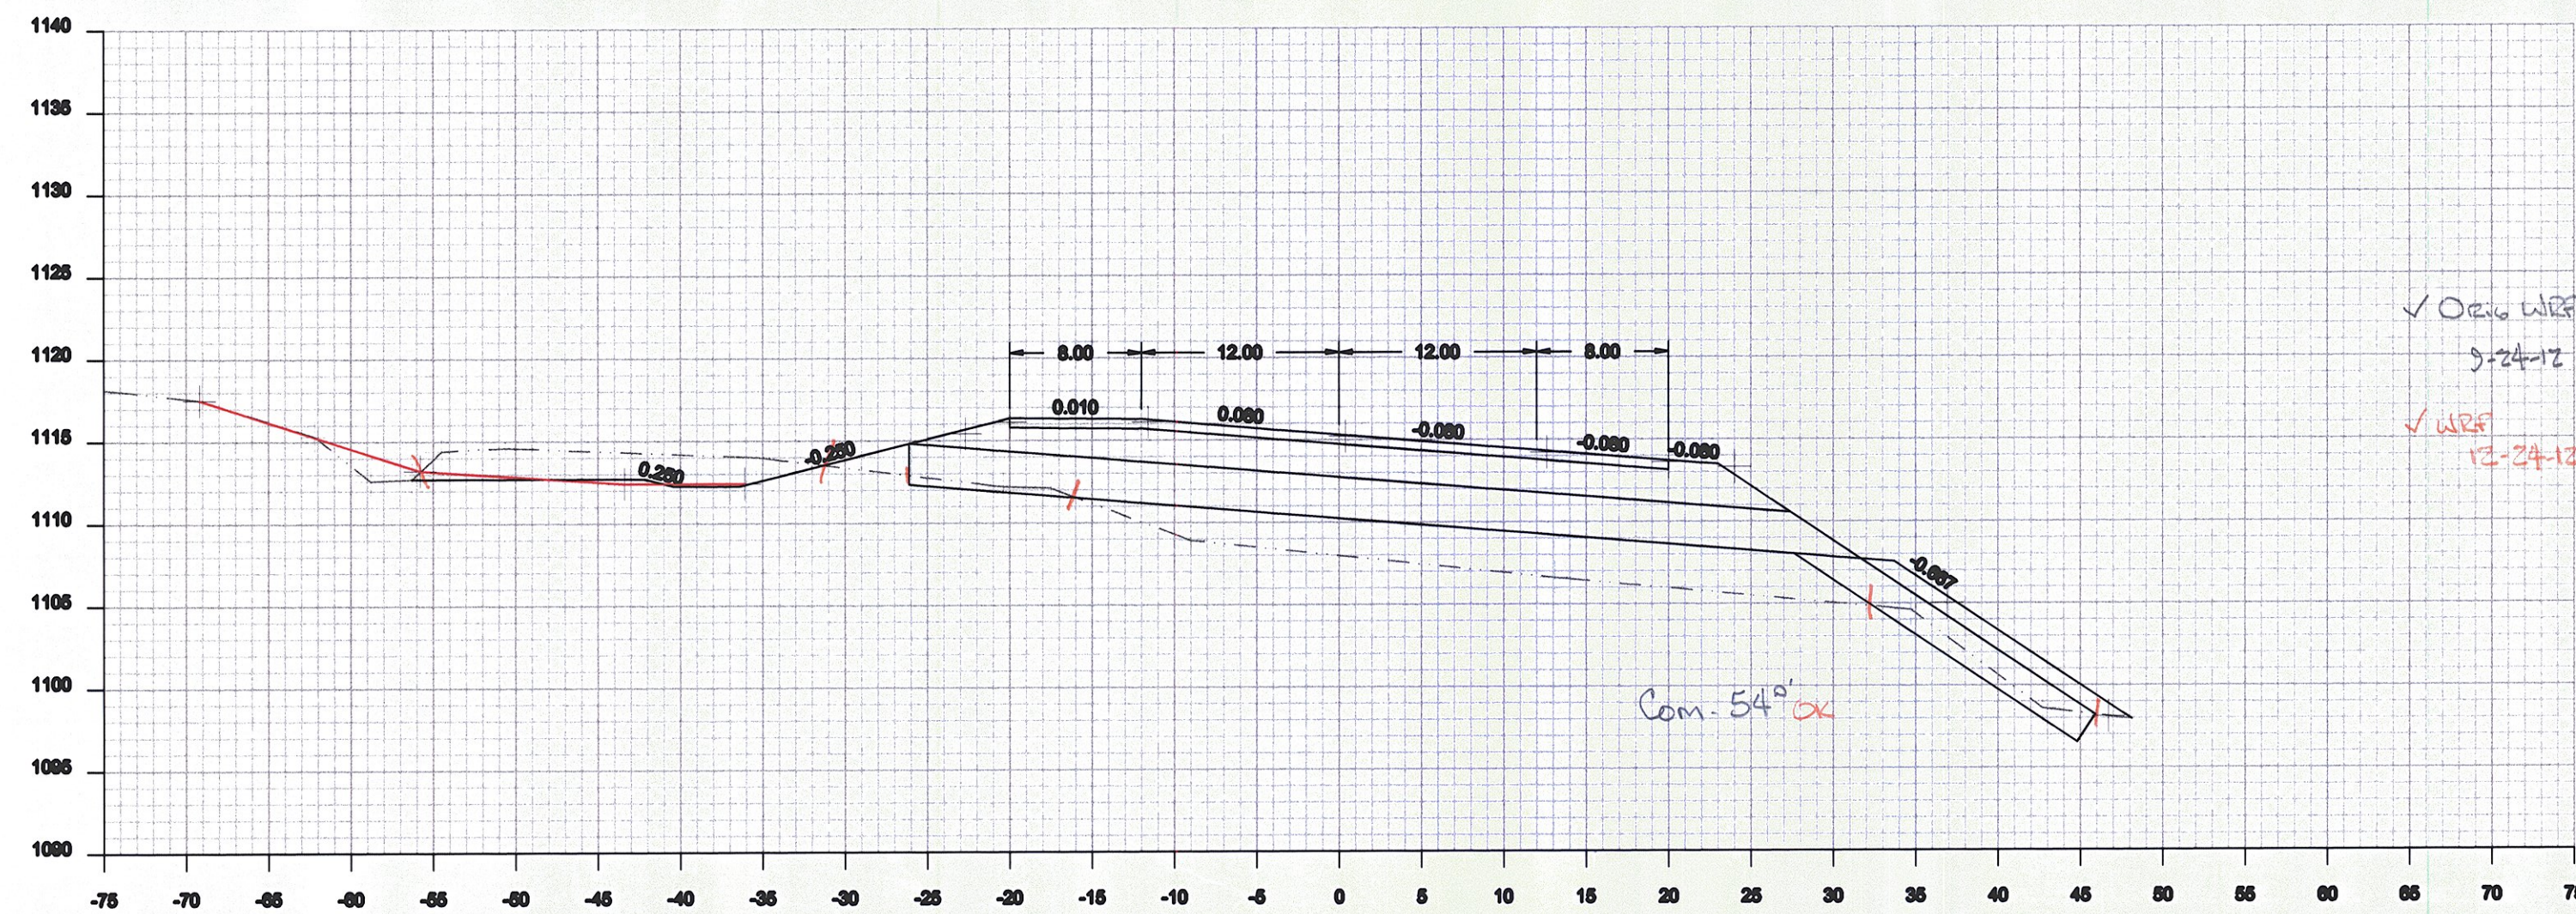

118+00

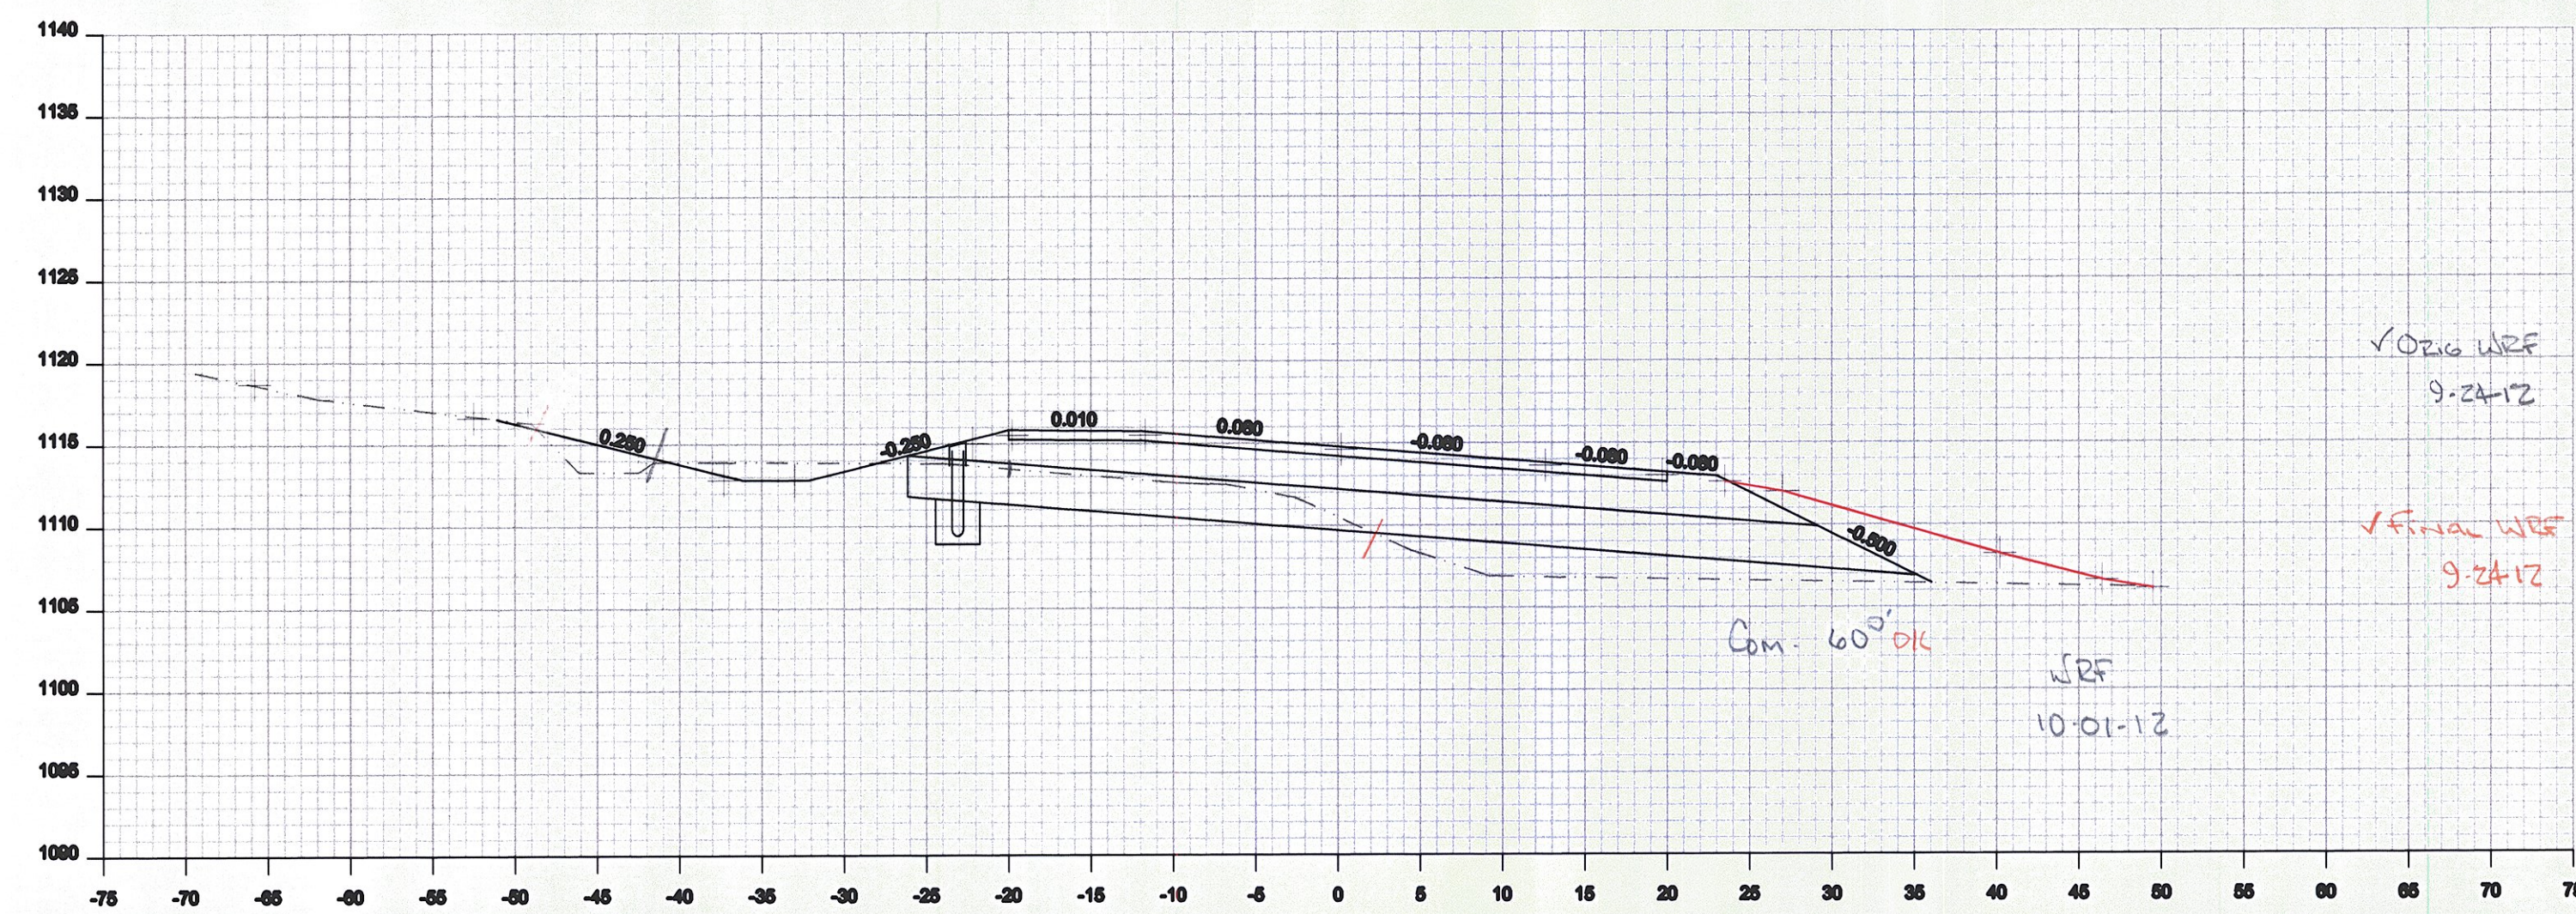

117+50

Drawing: Cross Section 117+50 - 118+50	
Project: Cabot Danville	
Drawn By: JMR	Checked By:
Date: 09-18-2012	Date:
Scale: 1:10	Sheet: of