



121+00

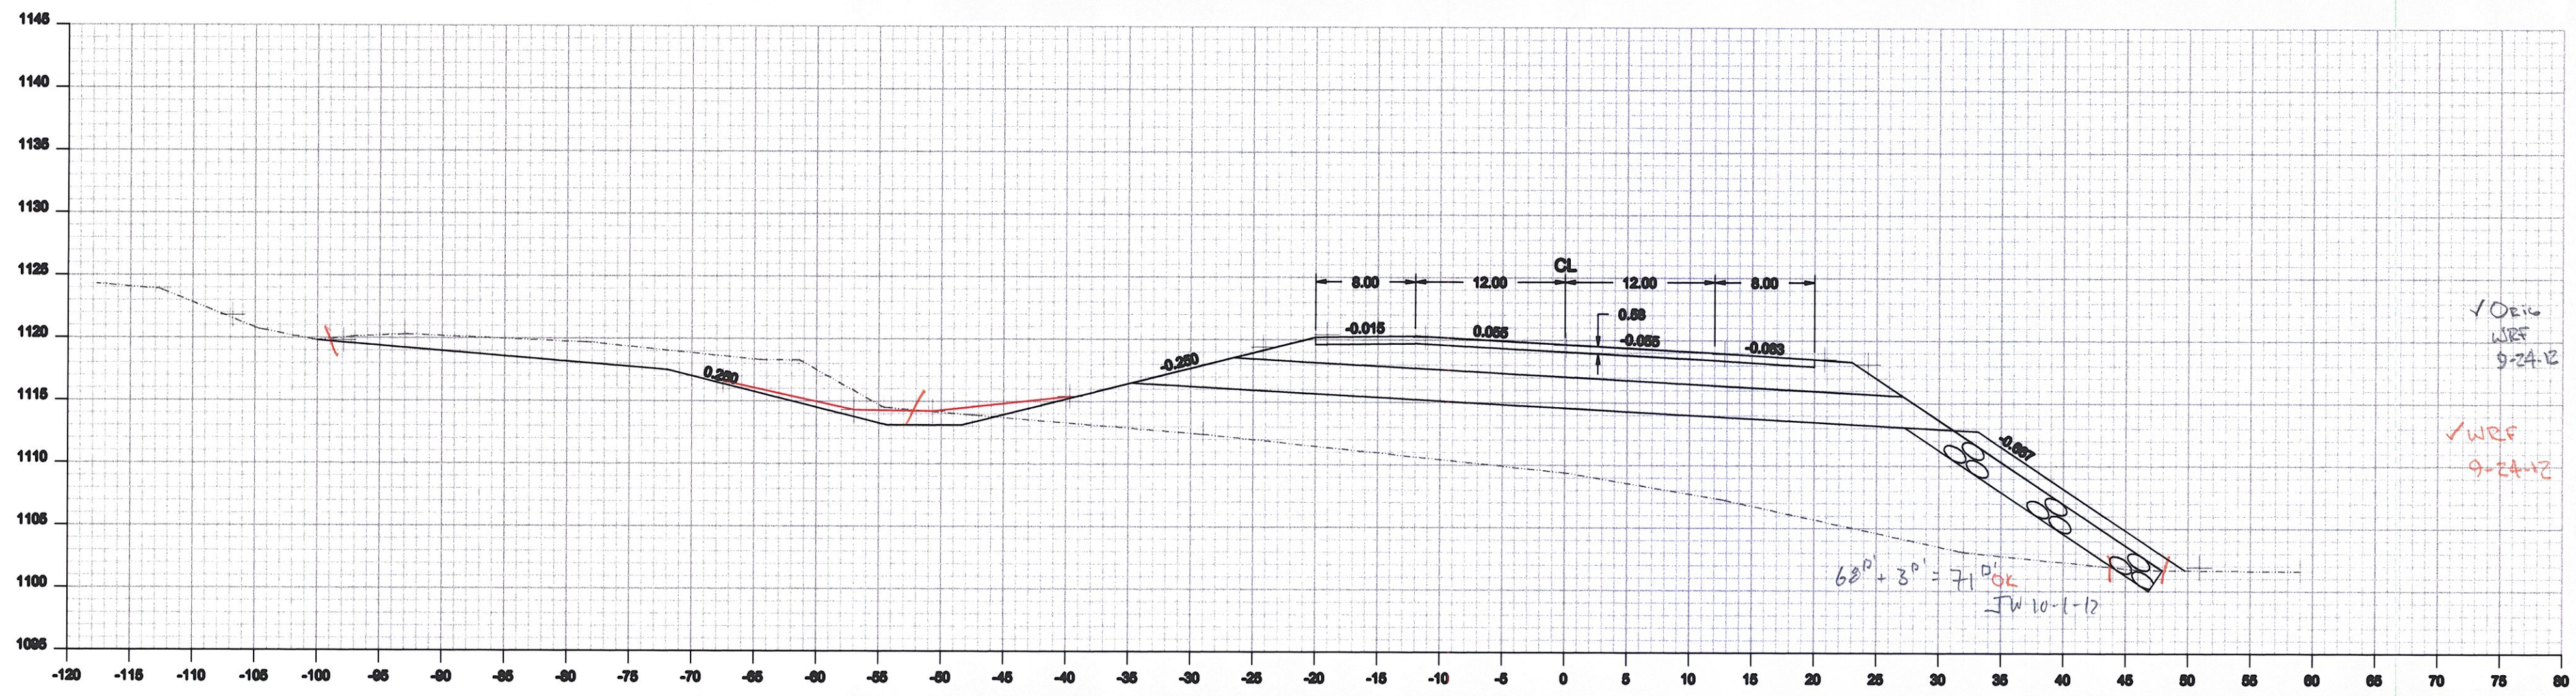

120+50

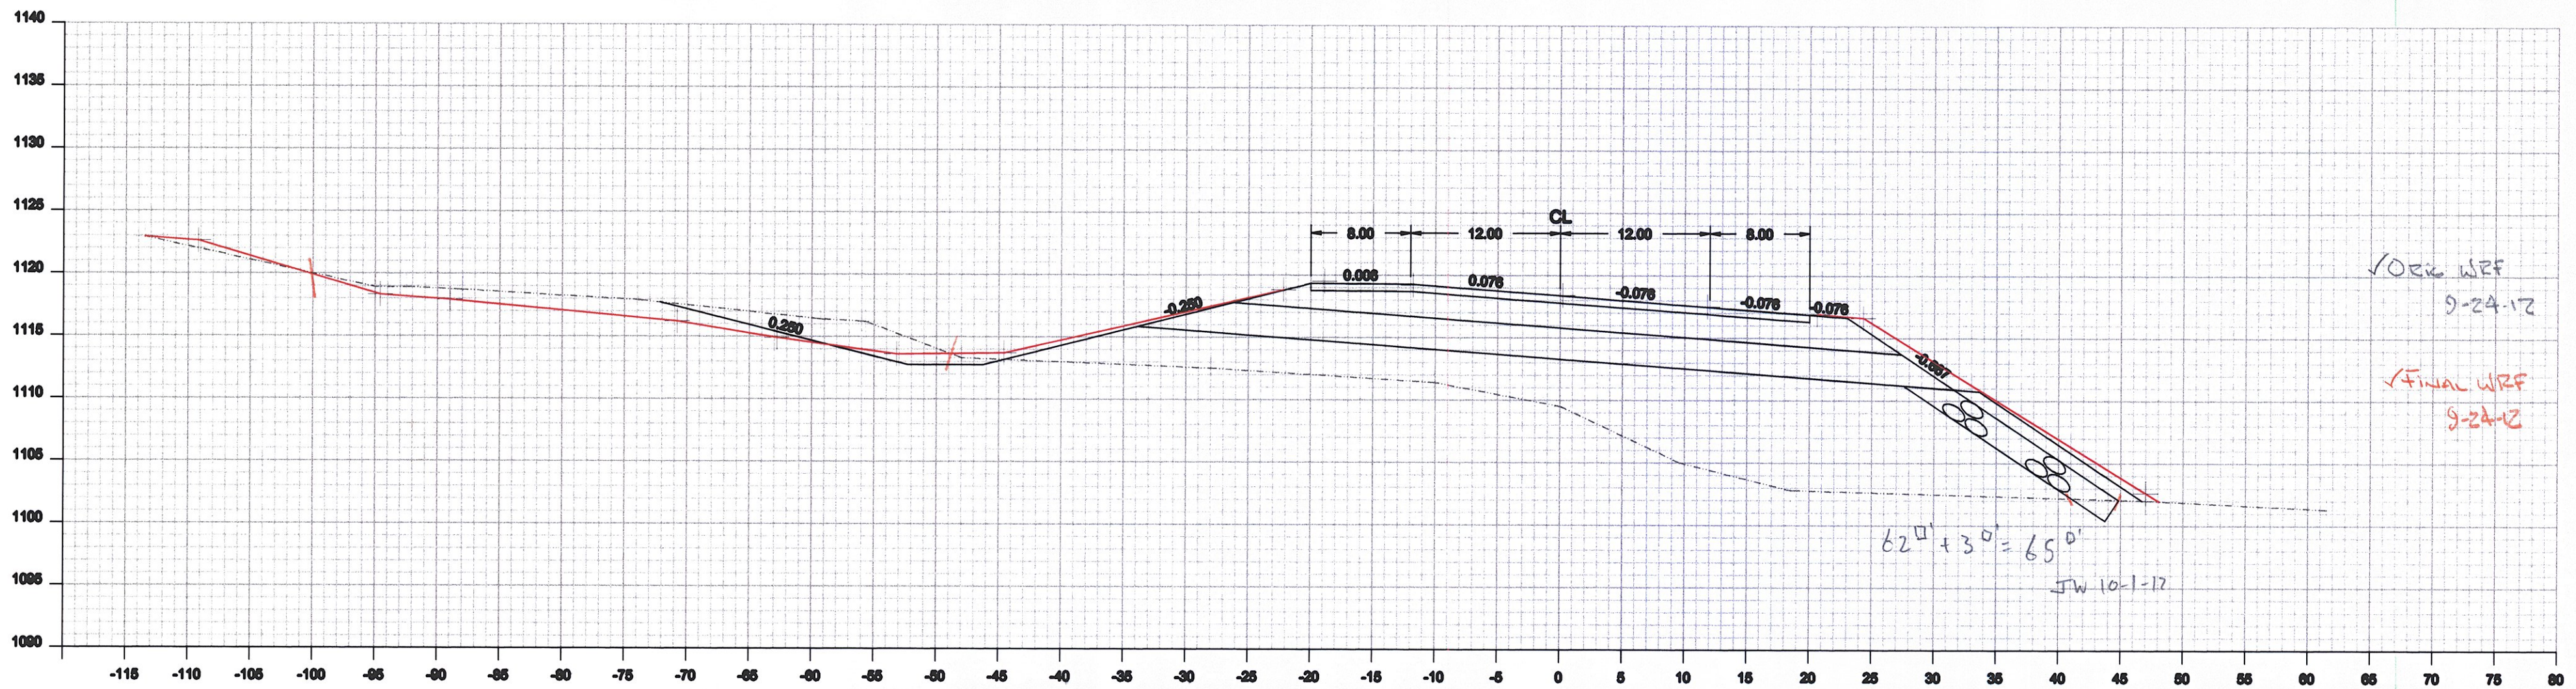

120+00

Drawing:	Section 120+00 - 121+00
Project:	Cabot Danville
Drawn By:	JMR
Date:	06-19-2012
Checked By:	Datoc
Scale:	1 : 10
Sheet:	of